

SURVEY & REMONUMENTATION

MAY 10 2000

LAND CORNER RECORDATION CERTIFICATE Filing Requirement of Act 74, Mich. P.A. 1970

SECTION

For corners in

WEXFORD COUNTY

Located In:

Corner Code #

1. Public Land Survey

T 21N R 09W

L-3

2. Property Controlling
in Section

S

T R

3. Miscellaneous
Property in Sec.

S

T R

4. Lot No. , Recorded Plat

5. Private Claims

I, George D. Smith, P.S., in a field survey on June 23, 19 99 do hereby state that under requirements of P.A. 74, Michigan P.A. of 1970, the corner points mentioned in lines 1 and 2 above were in conformance with regulations and rules therefore as required in the current manual of survey instructions of the United States Department of the Interior, Bureau of Land Management or by a decree of a Court of Law and/or that the corner points mentioned in lines 3, 4 and 5 above were in conformance with the rules of the Michigan Board of Land Surveyors or by a Decree of a Court of Law; established, re-established, monumented, recovered, found as expressed below:

NOTE: Not more than 2 corners, all in the same town and range, may be recorded on this certificate.

A. Description of original monument and accessories and/or subsequent restoration:

- L-3) 1848 GLO subdivision by Orson Lyon D.S. 14" N. Pine-N43½W-7, 11" N. Pine-S74E-8.
1907 D. Teed, found government witness, 14" N. pine-N24W-31, 16" N. Pine-N55E-37½, W. Pine-S57W-57.
1974 J.L. Wilcox Associates survey records field book 27, Page 25, set Wexford County Monument midway and on line between northeast and northwest section corners. 4" Maple-N55E-15.27', 7" Triple Maple-S30E-12.14', 8" Maple-S20W-10.09'.
1977 J. Switalski, PS #13045 Certificate of Survey, Liber 1, Page 555, found Wexford County Monument, 4" Maple-N58E-15.33', 6" Maple-S50E-30.40', 10" Maple-S20W-10.09'.
1979 J. Switalski, PS #13045 Certificate of Survey, Liber 1, Page 745, found Wexford County Monument.
1995 M. Myers, PS #31600 Certificate of Survey, Liber 74, Page 590, found Wexford County Monument, 12" Twin Maple-S21W-10.06', 6" Twin Maple-S49E-32.36', 7" Twin Maple-N60E-15.35', 7" Maple clump-S75W-55.32'.
1996 C. Pullen, PS #39095 Certificate of Survey, Liber 76, Page 196, found Wexford County Monument, witnesses same as 1995 Myers, PS #31600 Certificate of Survey.

B. Description of corner evidence found and/or method applied in restoring or reestablishing corner:

- L-3) Found Wexford County monument and two witnesses from Wilcox Associates field notes and one witness from 1995 Myers PS 31600 Certificate of Survey. This corner is accepted as a careful and faithful re-establishment of the position of the original corner, being the quarter corner common to Sections 1 and 12, T21N, R9W.


C. Description of monument for corner and accessories established to perpetuate locating the position of the corner:

- L-3) Wexford County Monument stamped 1999, PS #39098 1/12
N08E 11.12' 8" Red Pine
S24W 10.09' 12" Maple (1974 Wilcox 10.09')
S48E 32.38' 6" Maple (1995 Myers 32.36')
N61E 15.39' 8" Twin Maple (1974 Wilcox 15.27')

RECEIVED
1999 DEC - 1 PM 3:06
WEXFORD COUNTY, MI
REGISTER OF DEEDS

Register of Deeds Stamp & File Number

	A	B	C	D	E	F	G	H	I	J	K	L	M
1													
2		6		5		4		3		2		1	
3													
4		7		8		9		10		11		12	
5													
6		18		17		16		15		14		13	
7													
8		19		20		21		22		23		24	
9													
10		30		29		28		27		26		25	
11													
12		31		32		33		34		35		36	
13													

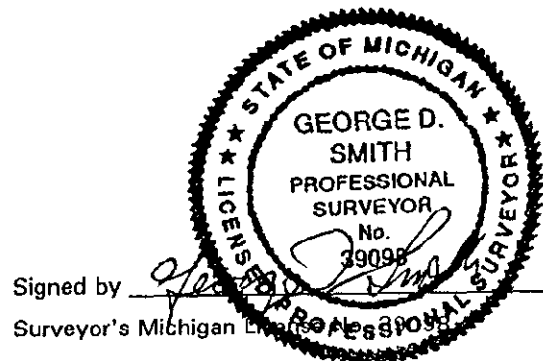

Signed by

Surveyor's Michigan License No. 39098

LIBER

05 PAGE 158

Peer Group Reviewed and Approved
Date: 12 Nov 99
Richard D. Wilcox, Wexford County Surveyor

Date 11-12-99