

SURVEY & REMONUMENTATION

MAY 10 2000

LAND CORNER RECORDATION CERTIFICATE Filing Requirement of Act 74, Mich. P.A. 1970

SECTION

For corners in

WEXFORD
(County)

Located In:

Corner Code #

1. Public Land Survey T 21N R 9W L-7
2. Property Controlling in Section S T R
3. Miscellaneous Property in Sec. S T R
4. Lot No. , Recorded Plat
5. Private Claims

RECEIVED

1999 DEC -3 PM 12: 44

Linda Laughmiller
WEXFORD COUNTY, MI
REGISTERED DEEDS

Register of Deeds Stamp & File Number

1	A	B	C	D	E	F	G	H	I	J	K	L	M
2		6		5		4		3		2		1	
3													
4		7		8		9		10		11		12	
5													
6		18		17		16		15		14		13	
7													
8		19		20		21		22		23		24	
9													
10		30		29		28		27		26		25	
11													
12		31		32		33		34		35		36	
13													

I, CRAIG J. PULLEN, PS, in a field survey on JULY 19, 1999, do hereby state that under requirements of P.A. 74, Michigan P.A. of 1970, the corner points mentioned in lines 1 and 2 above were in conformance with regulations and rules therefore as required in the current manual of survey instructions of the United States Department of the Interior, Bureau of Land Management or by a decree of a Court of Law and/or that the corner points mentioned in lines 3, 4 and 5 above were in conformance with the rules of the Michigan Board of Land Surveyors or by a Decree of a Court of Law; established, re-established, monumented, recovered, found as expressed below:

NOTE: Not more than 2 corners, all in the same town and range, may be recorded on this certificate.

A. Description of original monument and accessories and/or subsequent restoration:

- L-7 1848 G.L.O. RESURVEY BY O. LYON, WOOD POST, HEMLOCK 15 S4E 18, HEMLOCK 22 N46E 30
 1889 A. J. TEED SURVEY IN SEC.13 STAKE & BOTH WIT. OK
 1901 D. E. TEED SURVEY IN SEC.13 SUGAR 3 S9W 29, ELM 3 NORTH 59
 1976 JACK F. ERICKSON PS#16929 SURVEY IN SECTION 13, LIBER 1, PAGE 683, L.C.R.C. L.2, P.791 SET WCRC. MON STRAIGHT LINE & 1/2 BETWEEN SW & SE COR. IN LINE WITH FENCE NORTH & SOUTH. N35°W 38.00' 15" CHERRY, N25°E 42.82' 12" MAPLE, S50°E 55.00' 6" PINE
 1978 MATTHEW M. MCCLUNG PS#13037 L.C.R.C. L.3, P.316 FD WEXFORD MONUMENT 20" CHERRY N30°W 38.00', 14" MAPLE N30°E 44.70'
 1984 MATTHEW M. MCCLUNG PS#13037 SURVEY IN SEC.24, L.2, P.31 FD WEX CO MON 20" CHERRY N30°W 38.0', 14" MAPLE N30°E 44.7'
 1993 JAMES A. RAY PS#25869 SURVEY IN SEC.24, L.75, P.364 FOUND WEXFORD CO. MON. S60°E 10" MAPLE 56.28', N40°W 20" MAPLE 90.77', N30°E 6" MAPLE 61.30', S45°E 10" R. MAPLE 54.55'

B. Description of corner evidence found and/or method applied in restoring or reestablishing corner:


- L-7 FOUND WEXFORD COUNTY MONUMENT (ALUMINUM) 1.5' DEEP 6' SOUTH OF CENTERLINE 46 ROAD. LEFT AS IS AND STAMPED 1999 INFORMATION. THIS CORNER IS ACCEPTED AS THE BEST AVAILABLE EVIDENCE OF THE POSITION OF THE CORNER.

C. Description of monument for corner and accessories established to perpetuate locating the position of the corner:

- L-7 1/4 CORNER COMMON TO SECTIONS 13 & 24 T21N, R9W
 WEXFORD COUNTY ALUMINUM MONUMENT STAMPED: CJP, 39095, 1999, 1/4, 13, 24
 S69°E 7" MAPLE 55.19'
 S87°E 20" MAPLE 56.27'
 S48°E 10" RED PINE 54.36'
 S26°W POWER POLE 31.34'

Peer Group Reviewed and Approved

Date: 12 Nov 99
Richard D. Wilcox
 Richard D. Wilcox, Wexford County Surveyor

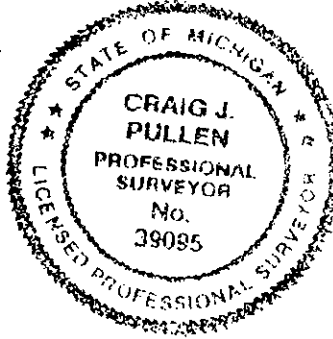

Signed by *Craig J. Pullen*

Date OCTOBER 21, 1999

Surveyor's Michigan License No. 39095