

SURVEY & REMONUMENTATION

MAY 10 2000

SECTION

LAND CORNER RECORDATION CERTIFICATE Filing Requirement of Act 74, Mich. P.A. 1970

For corners in

<u>WEXFORD COUNTY</u>	Located In:	Corner Code #
1. Public Land Survey	T <u> </u> R <u> </u>	<u> </u>
	T <u> </u> R <u> </u>	<u> </u>
	T <u> </u> R <u> </u>	<u> </u>
	T <u> </u> R <u> </u>	<u> </u>
2. Property Controlling in Section	S <u>3</u> T <u>21N</u> R <u>09W</u>	<u>12</u>
	S <u> </u> T <u> </u> R <u> </u>	<u> </u>
3. Miscellaneous Property in Sec.	S <u> </u> T <u> </u> R <u> </u>	<u> </u>
	S <u> </u> T <u> </u> R <u> </u>	<u> </u>

RECEIVED
1999 DEC - 1 PM 3:06
Yvette Schupmiller
WEXFORD COUNTY, MI
REGISTER OF DEEDS

Register of Deeds Stamp & File Number

4. Lot No. , Recorded Plat

5. Private Claims

I, George D. Smith, P.S., in a field survey on June 21, 19 99 do hereby state that under requirements of P.A. 74, Michigan P.A. of 1970, the corner points mentioned in lines 1 and 2 above were in conformance with regulations and rules therefore as required in the current manual of survey instructions of the United States Department of the Interior, Bureau of Land Management or by a decree of a Court of Law and for that the corner points mentioned in lines 3, 4 and 5 above were in conformance with the rules of the Michigan Board of Land Surveyors or by a Decree of a Court of Law; established, re-established, monumented, recovered, found as expressed below:

NOTE: Not more than 2 corners, all in the same town and range, may be recorded on this certificate.

	A	B	C	D	E	F	G	H	I	J	K	L	M
1													
2		6		5		4		3		2		1	
3													
4		7		8		9		10		11		12	
5													
6		18		17		16		15		14		13	
7													
8		19		20		21		22		23		24	
9													
10		30		29		28		27		26		25	
11													
12		31		32		33		34		35		36	
13													

A. Description of original monument and accessories and/or subsequent restoration:


- 12) 1848 GLO subdivision by Orson Lyon, D.S. Quarter Section corner in pond, set post on west side of pond, 37.50 east of southwest corner, Section 3. Beech 14-S14E-36, Beech 15-S28½W-33.
- 1881 A. Teed Survey, Liber 1, Page 01. Found W.P., no witnesses given, dist. to southwest corner, Section 3 measures 2478.8'.
- 1886 A. Teed Survey, Liber 1, Page 16. Found W.P., no witnesses given.
- 1891 A. Teed Survey, Liber 1, Page 02. Set 3' long iron 50' west of M.P. west of 7'. W. Pine 16-N10E-6.6, W. Pine 18-S70½W-17.2, dist. to southeast corner, Section 3 measures 2871.8'.
- 1906 D. Teed survey, Liber 1, Page 15. Corner found no witnesses given.
- 1991 Schripsema, PS 24617 Certificate of Survey Liber 70 Page 890. Found narrow gage railroad track at T.O.B. North-7.87-5" Oak, N55W-21.05-8" R. Pine, S60E-2.68-8" Oak, N85W-21.71-7" Oak.

B. Description of corner evidence found and/or method applied in restoring or reestablishing corner:

- 12) Found narrow gage railroad track and all four of 1991 Schripsema, PS #24617 Certificate of Survey. This corner is accepted as the best available evidence of the position of the original corner being the witness post common to Sections 3 and 10, T21N, R9W.

C. Description of monument for corner and accessories established to perpetuate locating the position of the corner:

- 12) Replaced narrow gage railroad track with 5/8"x36" iron with Wexford County brass cap stamp W.P. 1999, PS #39098.
- N55W 20.91 10" R. Pine, found nail
S52E 2.74 10" Oak, found nail
N06E 7.80 6" Oak, found nail
N85W 21.73 12" Oak, found nail
East 70' to edge of pond
East 2877.49 To southeast corner Section 3,
(1891 A. Teed dist. measures 2871.8').

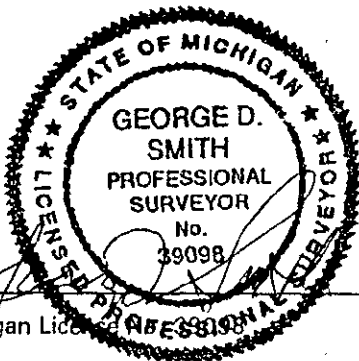

LIBER 05 PAGE 157

Peer Group Reviewed and Approved
Date: 12 Nov 99
Richard D. Wilcox
Richard D. Wilcox, Wexford County Surveyor

Signed by *George D. Smith*
Surveyor's Michigan License No. 39098

Date 11-12-99