

FILING REQUIREMENT OF ACT 74, MICH. P.A.1970

I, Carl F. Roser, do hereby certify that under requirements of P.A. 74, Michigan P.A. of 1970, the corner points mentioned in lines 1 and 2 above were, in a field survey on January 3, 1986, established, re-established, monumented, re-monumented, recovered or restored as expressed below and in conformance with regulations and rules therefore as required in the current manual of survey instructions of the United States Department of the Interior, Bureau of Land Management or by a decree of a court of law. Furthermore, that the corner points mentioned in lines 3, 4 and 5 above were, in a field survey on _____, 19____, found, recovered, restored, established or re-established as expressed below and in conformance with the rules of the Michigan State Board of Registration for Land Surveyors or, by a Decree of a Court of law:
(Continued):

XX

	<u>15</u>	
Drove 5/8" x 36" rerod w/RLS cap		
Power Pole	N56°W	39.65'
13" Elm stp (6'tall)	S58°W	67.85'
Ctr. 2'x 2½' Boulder	S40°W	39.7'
Set Cedar Post		
w/loc tag	North	21'
Ctr. E-W gravel rd	South	4'±

B. Description of corner evidence found and/or method applied in restoring or re-establishing corner:

- 9 - Estab. SE cor. of SW $\frac{1}{4}$ -NE $\frac{1}{4}$ of Sec. 9 per std. BLM instructions. White Pine stump (mostly down), probable 1903 D.E. Teed B.T., would fit cor. as set within less than two ft. for position.

C. Description of monument for corner and accessories established to perpetuate locating the position of the corner:

7

Drove 5/8" x 34" rerod w/RLS cap;
set cedar post w/loc tag

6" Red Oak	N25°W	13.4'
2" Red Oak	Due E	16.1'
4" Red Oak	S35°E	25.0'
Gas Pipe Line	Due W	152'

9

Drove 5/8" x 3/4" rerod w/RLS cap in rocks
& set cedar post w/loc tag

14" Sugar Maple (clp 2)	N55°W	14.1
5" Red Oak	Due E	9.2
10" Red Pine	S5°E	26.3

Old fn. cor. remains
(fences N&E) North 74'±
cor. in old N-S fn. remains

SIGNED BY Carl T. Noel 01-24-86 DATE


SURVEYOR'S MICHIGAN REGISTRATION NO. 12028

FOR STATE AND UNITED STATES AGENCIES:

SIGNED BY _____ DATE _____

APPROVED AND SIGNED BY _____ DATE _____

SURVEYOR'S MICHIGAN REGISTRATION NO.

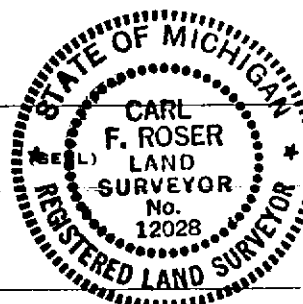

Wexford County