

# LAND CORNER RECORDATION CERTIFICATE

Filing Requirement of Act 74, Mich. PA 1970

For Corners In:  
Wexford  
(County)

Located In

Corner Code #

1. Public Land Survey	T		R	
	T		R	
2. Property Controlling in Section	S 31	T 22N	R 9W	4
	S 31	T 22N	R 9W	12
3. Miscellaneous Property in Section	S	T	R	
	S	T	R	


4. Lot No: Recorded Plat:

5. Private Claims:

I, Craig W. McVean, in a field survey on April 25, 2011 do hereby state that under requirements of PA 74, Michigan PA of 1970, the corner points mentioned in lines 1 and 2 above were in conformance with regulations and rules therefore as required in the current manual of survey instructions of the United States Department of the Interior, Bureau of Land Management or by a decree of a Court of Law and/or that the corner points mentioned in lines 3, 4 and 5 above were in conformance with the rules of the Michigan Board of Land Surveyors or by a Decree of a Court of Law; established, re-established, monumented, recovered, found as expressed below:

**NOTE: Not more than 2 corners, all in the same town and range, may be recorded on this certificate.**

Register of Deeds Stamp & File Number

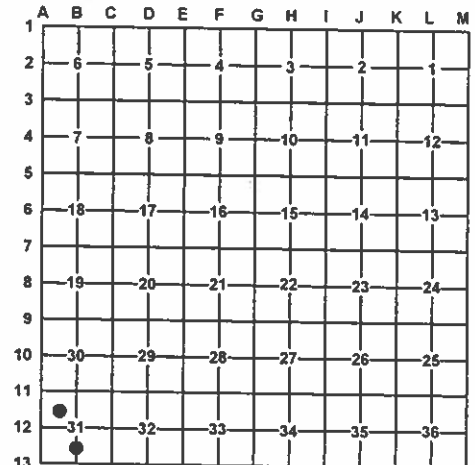

A. Description of original monument and accessories and/or subsequent restoration:

4 - None

12 - 1895 - CSR - A.J. Teed, 1) Tamarack 10" S89°E 9',  
- 1971 - Certificate of Survey - L.246, P. 693 - M. McClung,  
PS #13037. - No corner description given.

B. Description of corner evidence found and/or method applied in restoring or re-establishing corner:

4 - Northwest 1/16 corner of section 31 - Set 2" Aluminum cap on 5/8" X 34" rebar per standard BLM procedures.

12 - Center south 1/16 corner of Section 7 - Found 5/8" capped rebar in tag elder swamp per M. McClung, PS #13037. Also found 2" Cedar stake 0.3'± WSW.

C. Description of monument for corner and accessories established to perpetuate locating the position of the corner:

4 - Stamped 2" Aluminum cap on 5/8" x 34" rebar  
N20°E 43.15' to set N & T in W. side Tri. 7", 10" & 11" R. Maple  
N37°W 32.66' to set N & T in SW side 4" R. Maple  
S24°W 58.04' to set N & T in W. side 11" Cherry  
S47°E 37.87' to set N & T in NE side 2" R. Maple  
Set 4" x 4" Wood post 1' SW

12 - Stamped 2" Aluminum Cap on 5/8" X 34" rebar  
S78°E 8.02' to set Nail & Tag in N. side 3" R. Maple  
S05°W 11.31' to set Nail & Tag in E. side 2" R. Maple  
S08°W 15.36' to set Nail & Tag in W. side 3" R. Maple  
Set Blue Carsonite Post 1' West

Signed by:

Craig W. McVean

Date:

8/24/2011

Surveyor's Michigan License No.:

39088

