

# SURVEY & REMONUMENTATION

APR 25 1995

RECEIVED

## COMMISSION LAND CORNER RECORDATION CERTIFICATE

Filing Requirement of Act 74, Mich. P.A. 1970

1994 DEC -9 PM 2: 58

For corners in  
WEXFORD

*Linda Laughmiller*  
WEXFORD COUNTY, MI  
REGISTER OF DEEDS

(County)	Located In:	Corner Code <del>##</del>
	24N 11W	K-13
1. Public Land Survey	T R	
	T R	
	T R	
	T R	
2. Property Controlling in Section	S T R	
	S T R	
3. Miscellaneous	S T R	
Property in Sec.	S T R	

Register of Deeds Stamp & File Number

4. Lot No. \_\_\_\_\_, Recorded Plat \_\_\_\_\_  
5. Private Claims \_\_\_\_\_

A	B	C	D	E	F	G	H	I	J	K	L	M
2	6	5	4	3	2	1						
3												
4	7	8	9	10	11	12						
5												
6	18	17	16	15	14	13						
7												
8	19	20	21	22	23	24						
9												
10	30	29	28	27	26	25						
11												
12	31	32	33	34	35	36						
13												

CRAIG J. PULLEN

NOVEMBER 8

94

I, \_\_\_\_\_, in a field survey on \_\_\_\_\_, 19 \_\_\_\_\_, do hereby certify that under requirements of P.A. 74, Michigan P.A. of 1970, the corner points mentioned in lines 1 and 2 above were in conformance with regulations and rules therefore as required in the current manual of survey instructions of the United States Department of the Interior, Bureau of Land Management or by a decree of a Court of Law and/or that the corner points mentioned in lines 3, 4 and 5 above were in conformance with the rules of the Michigan Board of Land Surveyors or by a Decree of a Court of Law; established, re-established, monumented, re-monumented, recovered, found as expressed below:

**NOTE: Not more than 4 corners, all in the same town and range, may be recorded on this certificate.**

A. Description of original monument and accessories and/or subsequent restoration:

- K-13 1838 GLO SURVEY BY J. BRINK WOOD POST Y. PINE 22 N52½E Y. PINE 22 N20W 59  
1913 FARGO ENGINEERING SURVEY FOUND OLD STAKE & CROCKERY. ACCEPTED. Y. PINE STP. 16" N15W 1.81 CH W. PINE STP. 20" S18½W 0.37½ CH  
1972 WILCOX & ERICKSON J.L. WILCOX PS#14102 L.C.R.C. NOT RECORDED SET IRON TOP EDGE OF CULVERT N45° W 29.79' 20" OAK N75°E 104.10' CONC. MON. (INDIAN TRAIL) N20°E 38.20' CENTERLINE E-W RD. & CENTERLINE ROAD TO SOUTH  
1973 A. COURTRIGHT PS#4672 L.C.R.C. L.1 P.476 FOUND IRON IN CENTERLINE E-W ROAD AND ROAD TO SOUTH TOP EDGE OF CULVERT N45°W 29.79' 20" OAK N75°E 104.10' CONC. MON. N20°E 38.20'  
1973 MDNR SURVEY C. ROSER PS#12028 L.C.R.C. L.2 P.620 FOUND W&E IRON OF RECORD ADDED STD. WEX. CO. MON. TOP EDGE OF CULVERT 29.79' 20" OAK N75°E 104.10' CONC. MON (INDIAN TRAIL) N20°E 38.20' SET CED. POST W/LOC. TAG N45°E 47'  
1975 J.L. WILCOX & ASSOC. PS#14102 SURVEY L.1 P.425 FD WEXFORD COUNTY MON. WITNESSES SAME AS 1973.  
1992 WADE-TRIM SURVEY J. RAY PS#25869 L72 P.138 WEXFORD COUNTY MON. 1975 WILCOX WITNESSES GOOD AND S45°W WOOD POST 39.72'

B. Description of corner evidence found and/or method applied in restoring or reestablishing corner:


- K-13 FOUND WEXFORD COUNTY MONUMENT IN GOOD CONDITION IN ROAD CENTERLINES AND 4 PREVIOUS WITNESSES. THIS CORNER IS ACCEPTED AS A CAREFUL AND FAITHFUL PERPETUATION OF THE POSITION OF THE ORIGINAL CORNER, BEING THE SECTION CORNER COMMON TO SECTIONS 35 & 36, T24N, R11W AND SECTIONS 1 & 2, T23N, R11W.

Peer Group Reviewed and Approved

Date: 12-2-94  
*Richard D. Wilcox*  
Richard D. Wilcox, Wexford County Surveyor

C. Description of monument for corner and accessories established to perpetuate locating the position of the corner:

- K-13 SE CORNER SECTION 35, T24N, R11W  
WEXFORD COUNTY MONUMENT  
S45°W FENCE POST 39.72'  
N78°E 36" RED OAK 103.35' (NEW NAIL)  
N28°E CONCRETE INDIAN TRAIL MARKER (FACE) 38.20'  
N45°W TOP EDGE OF CULVERT 29.79'  
N45°E CEDAR POST WITH TAG 47'

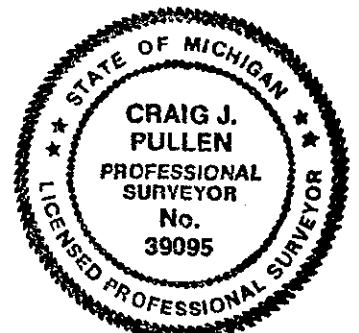

LIBER 04 PAGE 311

Signed by *Craig J. Pullen*

Date DECEMBER 1, 1994

Surveyor's Michigan License No. 39095