

LAND CORNER RECORDATION CERTIFICATE
Filing Requirement of Act 74, Mich. PA 1970

For Corners In: _____ Located In _____ Corner Code # _____
Wexford _____
(County)

1. Public Land Survey	T	24N	R	11W	C12
	T		R		
2. Property Controlling in Section	S	T		R	
	S	T		R	
3. Miscellaneous	S	T		R	
Property in Section	S	T		R	

4. Lot No: _____ Recorded Plat: _____

5. Private Claims: _____

1. Craig W. McVean, in a field survey on June 4, 2003 do hereby state that under requirements of PA 74, Michigan PA of 1970, the corner points mentioned in lines 1 and 2 above were in conformance with regulations and rules therefore as required in the current manual of survey instructions of the United States Department of the Interior, Bureau of Land Management or by a decree of a Court of Law and/or that the corner points mentioned in lines 3, 4 and 5 above were in conformance with the rules of the Michigan Board of Land Surveyors or by a Decree of a Court of Law; established, re-established, monumented, recovered, found as expressed below:

NOTE: Not more than 2 corners, all in the same town and range, may be recorded on this certificate.

1	A	B	C	D	E	F	G	H	I	J	K	L	M
2	6	5	4	3	2	1							
3													
4	7	8	9	10	11	12							
5													
6	18	17	16	15	14	13							
7													
8	19	20	21	22	23	24							
9													
10	30	29	28	27	26	25							
11													
12	31	32	33	34	35	36							
13													

A. Description of original monument and accessories and/or subsequent restoration:

C12 - GLO - Set 1/4 Post - J. Brink - 1838

Beech 10" S71°W 32 L.

Beech 10" N9°E 11 L.

- Fargo Eng. - 1913 - No US Evidence

Set Iron pipe and crockery; Sugar 12" S43½°W 37½ L.;

Cedar stp. 12" N40½°E 45 L.

- LCRC - L. 3, p. 190 - J. L. Wilcox - 1978

Found 1" pipe - set Wexford Co. Monument.

S15°E 10" Hemlock 28.28'; N75°E 4" DbI. Hemlock

N35°W 6" Cedar 32.47'; S80°W 4" Maple 5.30'.

- Rec. Sur. - L. 1, p. 613 - J. L. Wilcox - 1978

Same as LCRC

- Rec. Sur. - L. 69, p. 302 - D. E. Schripsema - 1989

B. Description of corner evidence found and/or method applied in restoring or re-establishing corner:

C12 - ¼ Corner Common to Sec. 31 & 32, T24N, R11W - Found 4" Wexford Co. Alum. Mon. w/ ½" Fargo pipe on NE side. Fil's Wilcox Witnesses. Fargo established position by Single Proportion to GLO. Both of Fargo's Wit.'s are gone. 4" Wexford Co. Mon. accepted as a careful and faithful re-establishment of the position of the original corner.

C. Description of monument for corner and accessories established to perpetuate locating the position of the corner:

C12 - 4" Wexford Co. Alum. Mon. - Added stamping "1/4 31/32"

S20°E 28.17' to Fd. Nail in 16" Hemlock (JLW)


N28°W 32.43 to Set N & T in E side 7" Cedar (JLW)

N64°E 35.50' to set N & T in NW side 8" Cedar

S66°W 27.20' to Set N & T in SE side 9" Ash

Set Blue Carsonite Post 1' NW

N28°W 4.42' to Fd. Nail in W. side Tw. 12" Ash

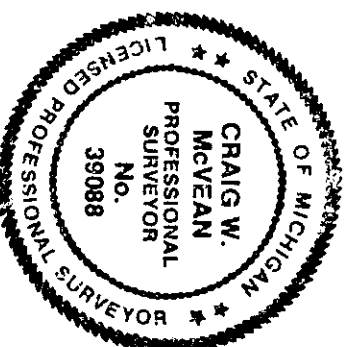

Signed by: Craig W. McVean
Surveyor's Michigan License No.: 39088

Date: 11/10/2003

Register of Deeds Stamp & File Number