

MAY 1 1995

COMMISSION

COPY

LAND CORNER RECORDATION CERTIFICATE
Filing Requirement of Act 74, Mich. P.A. 1970

RECORDED
WASHTENAW COUNTY, MI

JAN 10 9 44 AM '95

PEGGY M. HAINES
COUNTY CLERK/REGISTER

-COPY-

For corners in
Washtenaw

(County)

Located in:

Corner Code #

- | | | | | | |
|---------------------------------------|---|----|---|----|-----|
| 1. Public Land Survey | T | 1S | R | 3E | K-9 |
| | T | | R | | |
| | T | | R | | |
| | T | | R | | |
| 2. Property Controlling
in Section | S | | T | R | |
| | S | | T | R | |
| 3. Miscellaneous | S | | T | R | |
| Property in Sec. | S | | T | R | |

LIBER

1 PAGE 277 RM

Register of Deeds Stamp & File Number

4. Lot No. _____, Recorded Plat _____
5. Private Claims _____

I, Charles C. Wilson, in a field survey on September 23, 19 94,
do hereby certify that under requirements of P.A. 74, Michigan P.A. of 1970, the corner points mentioned
in lines 1 and 2 above were in conformance with regulations and rules therefore as required in the
current manual of survey instructions of the United States Department of the Interior, Bureau of Land
Management or by a decree of a Court of Law and/or that the corner points mentioned in lines 3, 4 and 5
above were in conformance with the rules of the Michigan Board of Land Surveyors or by a Decree of a
Court of Law; established, re-established, monumented, re-monumented, recovered, found as
expressed below:

NOTE: Not more than 4 corners, all in the same town and range, may be recorded
on this certificate.

A. Description of original monument and accessories and/or subsequent restoration:

United States Government Survey, 1815 Instructions, Surveyed 1825, Bearing Trees Hickory 12" N8-1/2deg. W 52 Links(34.32)
Hickory 10" S55deg. E 41 Links(27.06)
Meas. (N) 40 Chains(2640)
(E) 39.125 Chains(2582.25)
(S) 40 Chains(2640)
(W) 40.18 Chains(2651.88)

Continued on back:

B. Description of corner evidence found and/or method applied in restoring or reestablishing corner:

Found a 1/2" Iron Pipe, 4' below ground surface, 3' North of the North edge of gravel surface on Lindley Road. Set straddle witnesses and removed.
Found a 1-1/2" Pinch Top Iron Pipe. I believe this 1-1/2" Iron Pipe to be the point set by W.J. Armstrong in 1938. Replaced this 1-1/2" Pinch
Top Iron Pipe with a 1-1/4"x24" Iron Pipe with a Remonumentation Cap stamped #13604.


C. Description of monument for corner and accessories established to perpetuate locating the position of the corner:

Corner (K-9) 1-1/4"x24" Iron Pipe with a Remonumentation Cap stamped #13604
14" W. Oak N4deg. E 49.84(Nail & RT W/S)* 20" Maple N30deg. E 26.28(Nail & RT NW/S)*
40" Oak N40deg. E 19.80(Nail & RT NW/S)* 26" Oak N60deg. E 64.47(Nail & RT SE/S)*
30" Oak S65deg. E 44.70(Nail & RT NE/S)* 36" Oak S36deg. W 53.69(Nail & RT SE/S)*
36" Oak N40deg. W 30.75(Nail & RT E/S)*

*indicates accessory previously mentioned in Paragraph A.

I find no evidence to conflict with the acceptance of this point as being
a careful and faithful perpetuation of the position of the original corner.

This point was ratified by the Washtenaw County Peer Committee on November 28, 1994

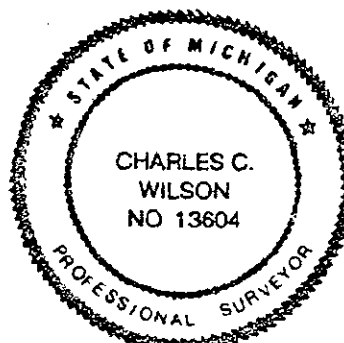

Signed by Charles C. Wilson Date November 30, 1994

Surveyor's Michigan License No. 13604

COPY

LIBER

1 PAGE 278 RM

-copy-

Paragraph A Continued:

William J. Armstrong, PS #2444, April 20, 1938

Found stumps of both GLO (A & B). Found Pointed Stone over a Black Mark surrounded by small stones. Reset with 1-1/2"x36" Iron Pipe, Bricks & Stones. Set 3 R/W Iron Pipes NW, NE & S.

W. Oak 8" N4deg.E 50.0

Maple 3" N31deg.E 26.4

B. Oak 26" N44-1/2deg.E 20.0

W. Oak 12" N45deg.E 5.6

W. Oak 6" N46deg.E 53.9

W. Oak 12" N61deg.E 64.9

B. Oak 14" S65deg.E 44.9

W. Oak 14" S36deg.W 53.7

Elm 36" N87deg.W 55.6

W. Oak 24" N37deg.W 30.5

C. Wilson & Associates, Inc., April 11, 1979

Charles C. Wilson, PS #13604

Reset Iron Pipe from remaining W.J. Armstrong accessories 1938

W. Oak 14" N4deg.E 50.0

Maple 10" N31deg.E 26.4

B. Oak 32" N44-1/2deg.E 20.0

W. Oak 20" N45deg.E 59.6

W. Oak 14" N46deg.E 53.9

W. Oak 20" N61deg.E 64.9

B. Oak 24" S65deg.E 44.9

W. Oak 24" S36deg.W 53.7

W. Oak 30" N37deg.W 30.5

Washtenaw Engineering Co., Inc., April 28, 1980

Norman N. Fahrner, PS #17620

Found 1/2" Iron Pipe(bent). Reset with new 1/2" Iron Pipe

12" W. Oak N4deg.E 49.72(nail)

14" Maple N31deg.E 26.40(nail)

36" B. Oak N44deg.E 20.00(nail)

18" W. Oak N61deg.E 64.90 (nail)

24" B. Oak S65deg.E 44.90(nail)

28" W. Oak S36deg.W 53.70(nail)

Washtenaw Engineering Co., Inc., May 7, 1980

Norman N. Fahrner, PS #17620

Found 1/2" Iron Pipe

Same as Liber 6, Page 6

Atwell-Hicks, Inc., December 22, 1983

Paul V. Schwimmer, PS # 24618

Found 1/2" Iron Pipe

32" B. Oak N44deg.E 20.00(nail)

24" B. Oak S65deg.E 44.5

24" W. Oak S36deg.W 53.6(nail)

30" W. Oak N37deg.W 30.3

Atwell-Hicks, Inc., January 26, 1984

John L. Snyder, PS #13352

Found 1/2" Iron Pipe

Same as December 22, 1983

Washtenaw Engineering Co., Inc., April 18, 1985

Norman N. Fahrner, PS #17620

Found 1/2" Iron Pipe

Same as Liber 6, Page 6

C. Wilson & Associates, Inc., March 17, 1986

Charles C. Wilson, PS #13604

Found 1/2" Iron Pipe

12" W. Oak N4deg.E 49.72(nail)

14" Maple N31deg.E 26.40(nail)

36" B. Oak N44deg.E 20.00(nail)

APPROVED

DATE 11/28/94

CO. REP. K