

LAND CORNER RECORDATION CERTIFICATE
Filing Requirement of Act 74, Mich, P.A. 1970

SURVEY &
REMONUMENTATION

NOV 02 1999

For corner in

Washtenaw
(County)

Located in:

Corner Code #

SECTION

1. Public Land Survey

T 1S R 3E

M-7

2. Property Controlling
in Section

S T R

3. Miscellaneous
Property in Sec

S T R

4. Lot No. , Recorded Plat

5. Private Claims

I, Charles C. Wilson, in a field survey on June, 19 98,

do hereby certify that under requirements of P.A. 74, Michigan P.A. of 1970, the corner points mentioned in lines 1 and 2 above were in conformance with regulations and rules therefore as required in the current manual of survey instruction of the United States Department of the interior, Bureau of Land Management or by a decree of a Court of Law and/or that the corner points mentioned in lines 3, 4 and 5 above were in conformance with the rules of the Michigan Board of Land Surveyors or by a Decree of a Court of Law; established, re-established, monumented, re-monumented, recovered, found as expressed below.

NOTE: Not more than 4 corners, all in the same town and range, may be recorded on this certificate.

A. Description of original monument and accessories and/or subsequent restoration:

United States Government Survey, 1815 Instructions, Surveyed 1824
Bearing Trees A) B. Oak 18" N58deg.W 40.26
B) B. Oak 18" SW 42.24

Continued on Back

B. Description of corner evidence found and/or method applied in restoring or reestablishing corner:

Found 3/4" x 12" Iron Rod 2" below bituminous road surface (Hadley Road). Removed and found 1-3/4" Iron Pipe 42" below road surface. Could not verify presence of Stone and Brick because of size and depth of excavation. 3/4" Iron Rod, as found, was not exactly over 1-3/4" Iron Pipe. Raised the 1-3/4" Iron Pipe with a 3/4" x 42" Iron Pipe and Remonumentation Cap stamped #13604 to road surface.

C. Description of monument for corner and accessories established to perpetuate locating the position of the corner:

3/4" x 42" Iron Pipe with Remonumentation Cap stamped #13604 (to road surface)
7) 2 R/W Pipes E and W 33.0 feet
9) 14" Ash S60deg.E 37.05 (Nail & RT NE/S)
10) 8" Oak S68deg.E 38.65 (Nail & RT N/S)
Twin 10" Ash N50deg.W 34.40 (Nail & RT NE/S of N'ly Trunk)
10" Hickory N80deg.W 29.85 (Nail & RT SW/S)

I feel that this point should be accepted as the best available evidence of the position of the original corner.

This corner was ratified by the Peer Committee on August 10, 1998

Monument Box will be installed by Washtenaw County Road Commission at a future date.


Signed by Charles C. Wilson
Surveyors Michigan's License No. 13604

Date August 10, 1998

APPROVED
DATE 8-10-98
CO. REP. K

COPY

	A	B	C	D	E	F	G	H	I	J	K	L	M
1													
2	6	5	4	3	2	1							
3													
4	7	8	9	10	11	12							
5													
6	18	17	16	15	14	13							
7													
8	19	20	21	22	23	24							
9													
10	30	29	28	27	26	25							
11													
12	31	32	33	34	35	36							
13													

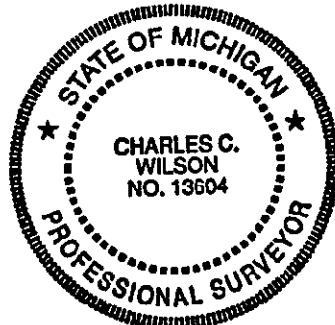

M-7

Paragraph A Continued:



Joseph Wampler, DS, 1824

C) W. Oak 16" N58W 9.24

D) B. Oak 16" N34deg.W 21.12

- Copy

Yocum, 1850+-

E) B. Oak 24" S8deg.E 55.44

F) Hickory S29deg.W 6.60

W.J. Armstrong, PLS#2444, May 1935

Washtenaw County Road Commission Grid Book

Found trace of Yocum's witness tree.

Reset corner with Iron Pipe, Stones & Bricks

1) 1-1/2" Hickory N78deg.E 20.95

2) 1-1/2" B. Oak S80deg.E 21.6

3) 1" Hickory S80deg.E 20.9

4) 5" B. Oak S35deg.E 36.3

5) 14" Hickory S84-1/2deg.W 64.8

6) 5" B. Oak N79deg.W 23.3

7) 2 R/W Pipes E&W

Richard E. Bidstrup, PLS#11360 July 1964

Washtenaw County Road Commission Grid Book

8) Edison Pole S84deg.W 45.0

9) 4" Box Elder S60deg.E 37.0

10) 2" B. Oak S68deg.E 38.55

Washtenaw Engineering Co., Inc., Norman N. Fahrner, PLS#17620, August 1974

Survey Drawing

Found 3/4" Iron Rod

7) 2 R/W Irons E & W 33.00

9) 8" Ash S60deg.E 37.0

10) 3" BO S68deg.E 38.55

11) Utility Pole N50W 51.65

Patrick L. Benton, PLS#19826, January, July 1975

Survey Drawing

Found 3/4" Iron Rod

9) 6" Box Elder S60deg.E 37.10

10) 3" B. Oak S68deg.E 38.55

11) Edison Pole N47deg.W 51.78 (nail N/S)

C. Wilson & Associates, Inc., Charles C. Wilson, PLS#13604, September, October 1977

Survey Drawing

Land Corner Recordation Certificate, Liber 4, Page 330

Found 3/8" Iron Rod

9) 4" Box Elder S60deg.E 37.0

10) 2" B. Oak S68deg.E 38.5

11) Power Pole N75deg.W 51.9

C. Wilson & Associates, Inc., Charles C. Wilson, PLS#13604, September, May 1978

Survey Drawing

Found 3/8" Iron Rod

9) 4" Box Elder S60deg.E 37.0

10) 2" B. Oak S68deg.E 38.5

11) Power Pole N75deg.W 51.9

Washtenaw Engineering Co., Inc., Norman N. Fahrner, PLS#17620, September 1985

Survey Drawing

9) 6" Box Elder S60deg.E 37.10

10) 3" B. Oak S68deg.E 38.55

11) Edison Pole N47deg.W 51.78 (nail N/S)

C. Wilson & Associates, Inc., Charles C. Wilson, PLS#13604, September, January 1986

Survey Drawing

Found 3/8" Iron Rod

9) 4" Box Elder S60deg.E 37.0

10) 2" B. Oak S68deg.E 38.5

11) Power Pole N75deg.W 51.9

C. Wilson & Associates, Inc., Charles C. Wilson, PLS#13604, September, April 1993

Survey Drawing

Found 3/8" Iron Rod

9) 6" Box Elder S60deg.E 37.10

10) 3" B. Oak S68deg.E 38.55

11) Edison Pole N47deg.W 51.78 (nail N/S)