

REMONUMENTATION

MAY - 1 1995

COMMISSION

LAND CORNER RECORDATION CERTIFICATE

Filing Requirement of Act 74, Mich. P.A. 1970

For corners in

WASHTENAW

(County)

Located In:

Corner Code ##

1. Public Land Survey

T 1 S R 5 E

L - 13

T R

T R

T R

2. Property Controlling
in Section

S T R

S T R

3. Miscellaneous
Property in Sec.

S T R

S T R

4. Lot No. , Recorded Plat

5. Private Claims

I. JOHN JEKABSON, in a field survey on 16 DECEMBER, 19 93

do hereby certify that under requirements of P.A. 74, Michigan P.A. of 1970, the corner points mentioned in lines 1 and 2 above were in conformance with regulations and rules therefore as required in the current manual of survey instructions of the United States Department of the Interior, Bureau of Land Management or by a decree of a Court of Law and/or that the corner points mentioned in lines 3, 4 and 5 above were in conformance with the rules of the Michigan Board of Land Surveyors or by a Decree of a Court of Law; established, re-established, monumented, re-monumented, recovered, found as expressed below:

NOTE: Not more than 4 corners, all in the same town and range, may be recorded on this certificate.

A. Description of original monument and accessories and/or subsequent restoration:


1819 G.L.O. Set Post
WAMPLER1934 17 Jan. WASHTENAW
COUNTY ROAD COMMISSION
W.J. ARMSTRONG #2444Found a wood stake and group of large
stones. Reset with Iron Pipe, stones
and bricks.Hickory, 6"
Twin Hickory, 5"
W. Oak, 32"
Hickory, 12"
Hickory 6"
Cherry, 6"N 40° E 66.4
N 46½° E 70.5
S 89° E 72.8
S 10° E 101.1
N 11° E 16.6
N 20° E 4.61
2
3
4
5
6SEE BACK OF THIS SHEET (NEXT
PAGE) FOR CONTINUATION OF
SECTION "A"This point is nearly in the West R.
of W. fence of the highway N. & S.

B. Description of corner evidence found and/or method applied in restoring or reestablishing corner:

FOUND 1½" IRON PIPE WITH BRICKS & STONES
USING 5 WITNESSES FROM SECTION "A"

C. Description of monument for corner and accessories established to perpetuate locating the position of the corner:

Found 1½" Iron Pipe	PK & RT in W sd. 16" Hickory	N 11° E	11.60	5
with Bricks & Stones.	PK & RT in SE sd. 20" Cherry	N 20° E	4.60	6
Set 5/8" Re-Bar with	PK & RT in SE sd. Twin 20" Hickory	N 45° E	70.50	2
Alum. Remon. Cap in it	PK & RT in N sd. 38" White Oak	EAST	72.80	3
	Nail in E. sd. 18" Hickory	S 10° E	101.10	4
	PK & RT in S sd. DE Pole	WEST	55.05	7

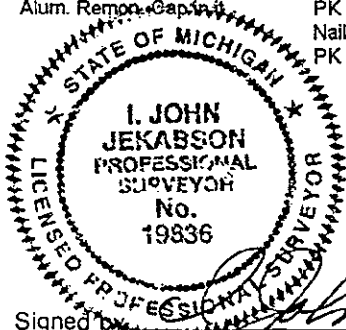

I conclude that after careful study of the recon
documentation and field observations, that thi
corner is a careful and faithful perpetuation of th
position of the original corner.

Signed by I. John Jekabson
Surveyor's Michigan License No. 19836Date 7 October, 1994

Continuation of section "A"

1993 WASHTENAW COUNTY REMONUMENTATION PROGRAM

WEBSTER TOWNSHIP TOWN 1 SOUTH, RANGE 5 EAST
L-13 (SOUTH 1/4 CORNER OF SECTION 36)

History compiled by:
I. John Jekabson P.S. # 19836
Roskelly, Jekabson & Assoc. P.C.

DATE	COMPANY SURVEYOR JOB #	P.S. #	P.A. 74 L.C.R.C.	LOCATION OF SURVEY	MONUMENT DESCRIPTION	WITNESSES	BEARING & DISTANCE	ID #	COMMENT
1971 10 Nov.	ATWELL-HICKS, INC. ROBERT J. JAGOW Job # 27320	# 6938		S.E. 1/4 SEC. 36	Found Iron Pipe	8" Hickory 8" Twin Hickory 34" Oak 12" Hickory 14" Cherry	N 44° E 66.4 N 46° E 70.5 S 89° E 72.8 N 11° E 16.6 N 20° E 4.6	1 2 3 5 6	
1971 11 Nov.	ROBERT J. JAGOW	# 6938	Liber 1, Page 323		Found Iron Pipe	Same as 1971	10 Nov.		
1990 Dec.	LAND SURVEYING CONSULTANTS R. TIMOTHY TIETSEMA Job # 04990A-2S5E1	# 20712		N.E. 1/4 SEC. 1 T.2S., R.5E.	Found Iron Pipe	No Witnesses			

2

APPROVED
DATE 11/19/94
CO. REP.