

SURVEY & REMONUMENTATION

MAY - 1 1995

LAND CORNER RECORDATION CERTIFICATE Filing Requirement of Act 74, Mich. P.A. 1970

COMMISSION

For corners in

Washtenaw

County

Located in: Lima Twp Corner Code

1. Public Land Survey

T 2 S R 4 E

J-13

2. Property Controlling
in Section

S

T

R

3. Miscellaneous
Property in Sec.

S

T

R

4. Lot No.

Recorded Plat

5. Private Claims

RECORDED
WASHTENAW COUNTY, MI
SEP 21 11 23 AM '94
J-13
HARRY M. HAINES
COUNTY CLERK/REGISTER

LIDER

1 PAGE

92Rm

- COPY -

Register of Deeds Stamp and File Number

	A	B	C	D	E	F	G	H	I	J	K	L	M
2	6	5	4	3	2	1							
3													
4	7	8	9	10	11	12							
5													
6	18	17	16	15	14	13							
7													
8	19	20	21	22	23	24							
9													
10	30	29	28	27	26	25							
11													
12	31	32	33	34	35	36							
13													

I, Michael S. Hoben in a field survey on Friday, January 01, 1993

do hereby certify that under requirements of P.A. 74, Michigan P.A. of 1970, the corner points mentioned in lines 1 and 2 above were in conformance with regulations and rules therefore as required in the current manual of survey instructions of the United States Department of the Interior, Bureau of Land Management, or by a decree of a Court of Law and/or that the corner points mentioned in lines 3, 4 and 5 above were in conformance with the rules of the Michigan Board of Land Surveyors or by a Decree of a Court of Law, established, re-established, monumented, re-monumented, recovered, found as expressed below.

NOTE: Not more than 4 corners, all in the same town and range, may be recorded on this certificate.

A. Description of original monument and accessories and/or subsequent restorations:

Monday, January 01, 1816

B. Hough

G.L.O.

Set post.

Witnesses:

15" W. OAK N. 33 W., 36 LINKS (23.76')
18" W. OAK S. 23 W., 24 LINKS (15.84')

Friday, December 09, 1983

R. A. Campbell

13028

WCRC

L6-P33

Fd. 1/2" iron pipe @ rd surface.
Removed 1/2" iron pipe during
paving and reset 3/4" X 18" iron
pipe at road surface.

Witnesses:

- 1 NAIL IN S. SIDE 22" WALNUT N. 54 W., 30.68'
- 2 NAIL IN S. E. SIDE 13" ASH N. 58 E., 46.38'
- 3 NAIL IN E. SIDE 6" POPLAR S. 34 E., 43.15'
- 4 NAIL IN W. SIDE 10" ELM S. 3 W., 43.78'
- 5 NAIL IN N.W. SIDE 8" ASH S. 50 W. 52.10'
- 6 N. EDGE PAVEMENT NORTH 4.9'
- 7 S. EDGE PAVE SOUTH 18.9'

Saturday, January 30, 1988

C. A. Eckfeld

33135

C. Wilson

Certified

Fd. 3/4" iron pipe.

Witnesses:

- 9 8" B. WALNUT N 18 W 22.51'
- 10 14" B. WALNUT N 71 E 54.55'
- 11 22" B. WALNUT S 8 W 37.19'
- 12 IRON PIPE WESTERLY 140.89'

B. Description of corner evidence found and/or method applied in restoring or reestablishing corner:

Fd. 3/4" iron pipe.

C. Description of monument for corner and accessories established to perpetuate locating the position of the corner:

Friday, January 01, 1993

Orchard, Hiltz &
McCliment, Inc.

21584

OHM


W. C.

Remon

Witnesses:

- 1 NAIL R/T N.E. SIDE 24" WALNUT N 45 W 30.29'
- 2 NAIL R/T S.W. SIDE 15" ASH N 58 E 46.40'
- 5 NAIL R/T S.E. SIDE 12" ASH S 51 W 52.14'
- 6 N. EDGE PAVEMENT NORTH 4.9'

We conclude that after careful study of the record documentation and field observations, that this corner is accepted as the best available evidence of the position of the original corner.

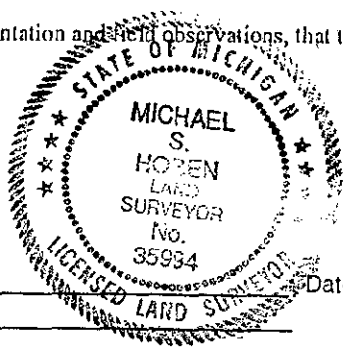

APPROVED

DATE 6-13-94

CO. REP. Kx

Signed by

Michael S. Hoben

Drafted by Michael S. Hoben

Surveyor's Michigan License No. 35994

Orchard, Hiltz and McCliment, Inc. 34935 Schoolcraft Road Livonia, MI 48150