

APPROVED

DATE 11-20-96

CO. REF. K2

LAND CORNER RECORDATION CERTIFICATE  
Filing Requirement of Act 74, Mich, P.A. 1970

RECORDED  
WASHTENAW COUNTY, MI  
PEER M. HAINES  
COUNTY CLERK/REGISTRAR

FEB 18 9 08 AM '97

For corner in

Washtenaw  
(County)

Located in:

Corner Code #

1. Public Land Survey

T 2S R 6E

I-10

T R

T R

T R

T R

2. Property Controlling  
in Section

S T R

S T R

3. Miscellaneous  
Property in Sec

S T R

S T R

4. Lot No.

Recorded Plat

5. Private Claims

Liber 000001 Page 0595 2

Register of Deeds Stamp & File Number

I, Charles C. Wilson, in a field survey on November 1, 1996, do hereby certify that under requirements of P.A. 74, Michigan P.A. of 1970, the corner points mentioned in lines 1 and 2 above were in conformance with regulations and rules therefore as required in the current manual of survey instruction of the United States Department of the Interior, Bureau of Land Management or by a decree of a Court of Law and/or that the corner points mentioned in lines 3, 4 and 5 above were in conformance with the rules of the Michigan Board of Land Surveyors or by a Decree of a Court of Law; established, re-established, monumented, re-monumented, recovered, found as expressed below.

NOTE: Not more than 4 corners, all in the same town and range, may be recorded on this certificate.

A. Description of original monument and accessories and/or subsequent restoration:

United States Government Survey, 1815 Instructions, Surveyed 1819  
Bearing Trees W. Oak 12" N83deg.E 48.84'  
W. Oak 18" N21deg.W 46.20'  
Meas. (N) 2640'  
(S) 2640'

Continued on Back:

B. Description of corner evidence found and/or method applied in restoring or reestablishing corner:

Found 3/4" Iron Pipe in outer lane of Huron High School Running Track from information and accessories mentioned in Paragraph A.

C. Description of monument for corner and accessories established to perpetuate locating the position of the corner:

Re-Set 3/4" Iron Pipe with 1" x 18" Iron Pipe with Remonumentation Cap Stamped #13604  
Iron Fence Post W'ly 12.00' \*  
West Edge of Track N45deg.W 3.0' \*  
19" Maple N5deg.W 110.17' (Nail & RT E/S) \*  
Top Nut of Hydrant S80deg.W 134.64' \*  
14" Maple N30deg.W 124.45' (Nail & RT W/S)  
12" Pine N80deg.W 136.24' (Nail & RT S/S)  
2-1/2" Peg with Chiseled "X" North Side of Stadium Light Pole S30deg.W 116.49'  
Northerly Goal Post S79deg.E 125.1'

\* Indicates accessory previously mentioned in Paragraph A

RT Indicates Remonumentation Tag

I believe this point should be accepted as the best available evidence of the position of the original corner.  
This point was ratified by the Washtenaw County Peer Committee on November 20, 1996.

Signed by

*Charles C. Wilson*

Surveyors Michigan's License No.

13604

Date

November 21, 1996


SURVEY &  
REMONUMENTATION

MAY 05 1997

COMMISSION

	A	B	C	D	E	F	G	H	I	J	K	L	M
1													
2	6	5	4	3	2	1							
3													
4	7	8	9	10	11	12							
5													
6	18	17	16	15	14	13							
7													
8	19	20	21	22	23	24							
9													
10	30	29	28	27	26	25							
11													
12	31	32	33	34	35	36							
13													

COPY

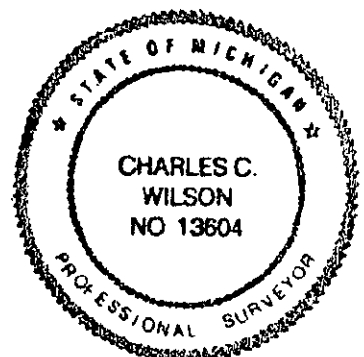

**Paragraph A Continued:**

H.H. Atwell, PS #322, Date Unknown  
Washtenaw County Road Commission Grid Book  
Iron Pipe  
Cottonwood 24" N47-1/2deg.W 183.5'

H.H. Atwell, PS #322, December 1926  
Survey Drawing

George White, PS #1573, June 1933  
Survey Drawing

Ed Young, June 1933  
Survey Drawing

H.H. Atwell, PS #322, February 1950  
Survey Drawing

Atwell-Hicks, Inc., September 1971  
Robert J. Jagow, PS #6998  
Survey Liber 1371, Page 878  
14" Maple N20deg.E 25.3'                      Triple Juniper S80deg.E 18.0'  
12" Pine N10deg.E 43.0'

Washtenaw Engineering Co., Inc., September 3, 1971  
John F. Oliver, PS #19840  
Survey Drawing  
Set 1" Iron Pipe  
Back of Curb W'ly 54.3'                      6" Triple Cherry N23deg.E 54.45'  
12" Pine N'ly 94.4'                      12" Cherry N42deg.E 54.6'  
15" Maple N5deg.E 75.80'

Washtenaw Engineering Co., Inc., September 15, 1971  
Norman N. Fahrner, PS #17620  
Previous Land Corner Recordation Certificate, Liber 1, Page 255  
Re-Set 1" Iron Pipe from previous survey information  
Back of Curb W'ly 54.3'                      15" Maple N5deg.E 75.80'  
12" Pine N'ly 94.40'                      12" Cherry N42deg.E 54.6'

Atwell-Hicks, Inc., September 17, 1971  
Robert J. Jagow, PS #6998  
Previous Land Corner Recordation Certificate, Liber 6, Page 275  
Found Pinch Top Iron Pipe raised with 3/4" Iron Pipe  
Accessories Same as September 1971

Atwell-Hicks, Inc., January 1972  
Robert J. Jagow, PS #6998  
Survey Drawing Liber 1386, Page 102  
Found Iron Pipe  
Accessories Same as September 1971

Washtenaw Engineering Co., Inc., February 13, 1979  
Norman N. Fahrner, PS #17620  
Previous Land Corner Recordation Certificate, Liber 5, Page 202  
Found Iron Pipe, Accessories Same as September 15, 1971, Multiple Cedar N20deg.E 51.4'

Midwestern Consulting Inc., September 10, 1991  
Allen R. Rentschler, PS #15411  
Previous Land Corner Recordation Certificate, Liber 7, Page 295  
Re-Set Iron Pipe according to Atwell-Hicks, Inc. Survey No. 6982 (1958)  
Iron Fence Post W'ly 11.92'                      19" Maple N5deg.W 110.91' (Nail E/S)  
West Edge of Track N45deg.W 2.99'                      Top Nut of Hydrant S80deg.W 134.53'

SURVEY &  
REMONUMENTATION  
MAY 05 1997  
COMMISSION