

MAY - 1 1995

COMMISSION

COPY

LAND CORNER RECORDATION CERTIFICATE
Filing Requirement of Act 74, Mich. P.A. 1970

LIBER

1 PAGE 227 Rm

- copy -

PEGGY M. HAINES
COUNTY CLERK/REGISTER

Dec 1 11 41 AM '94

RECORDED
WASHTENAW COUNTY, MI

- COPY -

For corners in

Washtenaw
(County)

Located In:

Corner Code ##

- | | | |
|---------------------------------------|-----------|------|
| 1. Public Land Survey | T 3S R 5E | I-10 |
| | T R | |
| | T R | |
| | T R | |
| | T R | |
| 2. Property Controlling
in Section | S T R | |
| | S T R | |
| 3. Miscellaneous
Property in Sec. | S T R | |
| | S T R | |

Register of Deeds Stamp & File Number

4. Lot No. _____, Recorded Plat _____
5. Private Claims _____

I, Kenneth Coleman, in a field survey on May 23, 19 94,
do hereby certify that under requirements of P.A. 74, Michigan P.A. of 1970, the corner points mentioned
in lines 1 and 2 above were in conformance with regulations and rules therefore as required in the
current manual of survey instructions of the United States Department of the Interior, Bureau of Land
Management or by a decree of a Court of Law and/or that the corner points mentioned in lines 3, 4 and 5
above were in conformance with the rules of the Michigan Board of Land Surveyors or by a Decree of a
Court of Law; established, re-established, monumented, re-monumented, recovered, found as
expressed below:

NOTE: Not more than 4 corners, all in the same town and range, may be recorded
on this certificate.

A. Description of original monument and accessories and/or subsequent restoration:

See back of sheet


B. Description of corner evidence found and/or method applied in restoring or reestablishing corner:

Found 3/4" iron pipe 12-14-93
See back of sheet

C. Description of monument for corner and accessories established to perpetuate locating the position of the corner:

Found 3/4" iron pipe with Atwell-Hicks, Inc, cap

- | | | | |
|-----------|--------|----------------|----|
| 6) S70°W | 116.34 | 16" Hickory | RT |
| 7) S60°W | 112.31 | 20" Walnut | RT |
| 10) N50°W | 288.83 | SE Corner Barn | |
| 11) N 5°W | 61.71 | P. Pole | RT |

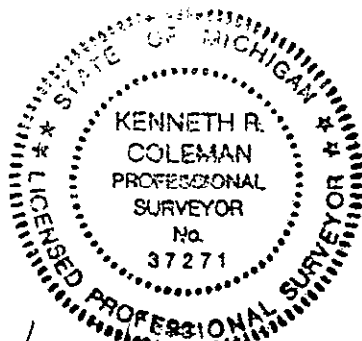

Signed by Kenneth R. Coleman Date 9/19/94
Surveyor's Michigan License No. 37271

- copy -

I-10 Witness Summary

6-15-1819 J. Wampler D.S.

P. 261

- Set 1/2 Mile Post
1) Elm 40" S 13 W 16
2) Do. 9" N 24 W 8

(1930's) Pettibone

W.C.R.C. Grid Book P, 16,

Government witnesses:

- 3) 14" Elm, S 80 W, 108.9'
4) 9" Maple, S 43 1/2 E, 39.6'
5) 8" Y. Oak, S 78 E, 102.96'

1-20-78 Allen R. Rentschler

Liber 4, Page 400, W.C.R.

Found 1 1/4" Iron Pipe

- 6) 14" Hickory, S 20 W, 116.4'
7) 16" Walnut, S 20 E, 112.37'
8) SE cor of barn, N 50 W, 179.3'
9) 10' North of N edge of gravel road

4-12-84 Midwestern Consulting, Inc.

Job #84344

Found 1 1/4 Iron Pipe

- 6) 14" Hickory S 20 W 116.14'
7) 16" Walnut S 20 E 112.4'
8) S.E. Cor. of Barn N 50 W 179.3

8-4-93 Atwell-Hicks, Inc.

Book 940, Page 32

Reset W 1/4 cor. Sec. 26 from witnesses on Recordation Certificate L.4, P.400. Set 3/4" iron pipe in bit. drive 9.6' North of north edge bit. road

- 6) Nail NW side 20" Hickory S 70° W 116.40'
7) Nail N. Side 24" Walnut S 70° E 112.37
8) SE cor. barn N 10° W 179.25
9) Nail E. side P.P. N 20° W 62.00

12-14-93 Atwell-Hicks, Inc.

Found 3/4" Iron pipe in Asphalt Drive, pulled pipe, found nothing below

- 6) 16" Hickory S20W, 116.34'
7) 20" Walnut S60E, 112.31'
8) SE cor. of barn, N 50° W 288.83
9) RT W. face power pole N 5° W 61.71
10) 10' N. of N. edge of asphalt drive

APPROVED

DATE 6/13/74

CO. REP. FA