

SURVEY &
REMONUMENTATION

COPY

RECORDED
WASHTENAW COUNTY, MI

MAY - 1 1995

JAN 10 9 44 AM '95

LAND CORNER RECORDATION CERTIFICATE
Filing Requirement of Act 74, Mich. P.A. 1970

COMMISSION

For corners in

Washtenaw
(County)

Located In:

Corner Code ##

- | | | | | | |
|---------------------------------------|---|----|---|----|------|
| 1. Public Land Survey | T | 3S | R | 5E | M-12 |
| | T | | R | | |
| | T | | R | | |
| | T | | R | | |
| 2. Property Controlling
in Section | S | | T | | R |
| | S | | T | | R |
| 3. Miscellaneous
Property in Sec. | S | | T | | R |
| | S | | T | | R |

PEGGY M. HAINES
COUNTY CLERK/REGISTER

-COPY-

LIBER

1 PAGE 275 RM

-COPY-
Register of Deeds Stamp & File Number

4. Lot No. _____, Recorded Plat _____
5. Private Claims _____

I, Kenneth R. Coleman in a field survey on July 12, 19 94,
do hereby certify that under requirements of P.A. 74, Michigan P.A. of 1970, the corner points mentioned
in lines 1 and 2 above were in conformance with regulations and rules therefore as required in the
current manual of survey instructions of the United States Department of the Interior, Bureau of Land
Management or by a decree of a Court of Law and/or that the corner points mentioned in lines 3, 4 and 5
above were in conformance with the rules of the Michigan Board of Land Surveyors or by a Decree of a
Court of Law; established, re-established, monumented, re-monumented, recovered, found as
expressed below:

NOTE: Not more than 4 corners, all in the same town and range, may be recorded
on this certificate.


- A. Description of original monument and accessories and/or subsequent restoration:
See back of sheet

- B. Description of corner evidence found and/or method applied in restoring or reestablishing corner:
Found monument 4-1-94
See back of sheet

- C. Description of monument for corner and accessories established to perpetuate locating the position of the corner:

Set remonumentation cap on found monument.

- | | | |
|-----------|-------|----------------------|
| 6) N17°E | 40.25 | 24" W. Oak, RT, nail |
| 8) N79°E | 33.42 | 36" W. Oak, RT, nail |
| 9) S 4°W | 44.00 | 48" W. Oak, RT, nail |
| 11) S85°E | 6.26 | 4" Hickory, RT, nail |

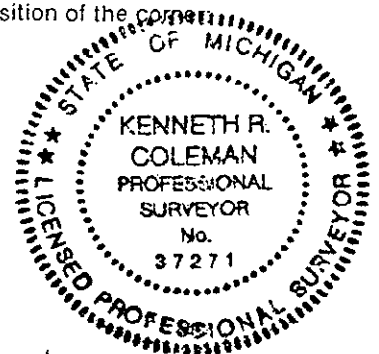

Signed by Kenneth R. Coleman Date 9/19/94
Surveyor's Michigan License No. 37271

M-12 Witness Summary

LIBER

1 PAGE 276 RM
-copy-

11-28-1815 J. Wampler D.S.

Page. 408

Set the q sec post from which

- 1) a W. Oak 18 in di bears N 76 E 71 Lks dist
- No other timber near

Early 1900's S. B. Pettibone

Referenced in Armstrong notes 1937, P. 46

- 3) W. Oak 12" N 2°W .31
- 4) B. Oak 22" S21°W .57

10-25-37 W. J. Armstrong

W.C.R.C. Field Book, P. 46

Found stake and Pettibone's Witnesses,

Set 1 1/2" x 38" Iron Pipe, Bricks and 4 Stones

- 5) 12" W. Oak, N 9 E, 60.1'
- 6) 14" W. Oak, N 17 E, 40.4'
- 7) 10" W. Oak, N 59 E, 15.1'
- 8) 28" W. Oak, N 78 E, 34.0'
- 9) 30" W. Oak, S 4 W, 44.3'
- 10) 26" W. Oak, West, 6.0'

4-1-94 Atwell-Hicks, Inc.

Found monument

- 6) 24" W. Oak, N 17 E, 40.4' to center
- 8) 36" W. Oak, N 79 E, 33.5' to center
- 9) 48" W. Oak, S 4 W, 44.3' to center
- 10) 36" W. Oak, West, 6.0' to center

APPROVED

DATE 4/19/94

CO. REP. H