

APPROVED

DATE 9-23-76

CO. REP. K

LAND CORNER RECORDATION CERTIFICATE

Filing Requirement of Act 74, Mich. P.A. 1970

For corners in

Washtenaw

(County)

Located In:

Corner Code =#

1. Public Land Survey

T 3S R 6E

I-10

T R

T R

T R

2. Property Controlling
in Section

S T R

S T R

3. Miscellaneous

S T R

Property in Sec.

S T R

4. Lot No. , Recorded Plat

5. Private Claims

RECORDED
WASHTENAW COUNTY, MI
PEGGY M. HAINES
COUNTY CLERK/REGISTER

FEB 18 9 10 AM '97

Liber 000001 Page 0605 pm

Register of Deeds Stamp & File Number

I, Todd D. Shelly, in a field survey on 3-22, 19 96, do hereby certify that under requirements of P.A. 74, Michigan P.A. of 1970, the corner points mentioned in lines 1 and 2 above were in conformance with regulations and rules therefore as required in the current manual of survey instructions of the United States Department of the Interior, Bureau of Land Management or by a decree of a Court of Law and/or that the corner points mentioned in lines 3, 4 and 5 above were in conformance with the rules of the Michigan Board of Land Surveyors or by a Decree of a Court of Law; established, re-established, monumented; re-monumented, recovered, found as expressed below:

NOTE: Not more than 4 corners, all in the same town and range, may be recorded on this certificate.

A. Description of original monument and accessories and/or subsequent restoration:
See back of sheet.

B. Description of corner evidence found and/or method applied in restoring or reestablishing corner:

Found 3/4" IP in monument box 3-15-96
See back of sheet.

SURVEY &
REMONUMENTATION

MAY 05 1997

COMMISSION

C. Description of monument for corner and accessories established to perpetuate locating the position of the corner:
Found 3/4" IP in monument box. Set aluminum remonumentation cap with PK nail over found iron pipe.

5) 16" Hickory with dead twin	WEST	74.45'	to nail & RT
13) 10" Cherry	WEST	53.35'	to nail & RT
16) Guy pole	S55°E	66.32'	to nail & RT
17) U.P.	S87°E	52.22'	to nail & RT
18) Pipe line market	N45°W	52.13'	to center


COPY

I believe that this point should be accepted as a careful and faithful representation of the position of the original corner.

Signed by Todd D. Shelly
Surveyor's Michigan License No. 41111

Date Nov 25 1997

FORM APPROVED BY MICHIGAN STATE BOARD OF LAND SURVEYORS, JAN. 28, 1971
REVISED MAY 14, 1975
REVISED JAN., 1983

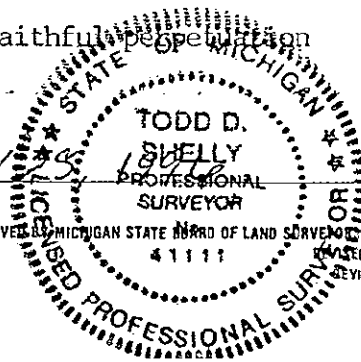

1-10 Witness Summary		
11-18-1887	C.S. Woodard	Woodard's notes
Stake, tile, iron and stone.		
1) 14" Elm	S20°W	380.8'
2) 10" Hickory	S02°E	577.5'
4-8-1932	W.J. Armstrong	Grid Book
Found cast iron sleigh shoe and stones. Set a 2" x 52" iron pipe and placed 6 bricks around it.		
3) 10" Y. Oak	S11½°E	77.3'
4) 16" Y. Oak	S54°W	28.27'
5) 6" Tw. Hickory	N88½°W	74.95'
6) R.O.W. pipe		
7) R.O.W. pipe		
5-27-1958	C. Wilson	A-H Book 660-6
Found 2" I.P. 0.7' below road surface. Raised with 1/2" x 12" I.P. driven inside.		
10-27-1959	Bissell, McKenzie	A-H Grid Book
NOTE IN GRID BOOK UNDER I-10 ENTRY.		
Found plow point 5.42' west of the pipe above. This point is closer to the middle of the road 1/2 between road fence lines.		
8) Plow point	WEST	5.42'
8-27-1971	N. Fahrner No. 17620	LCRC L.1, P.235
2" Iron pipe.		
3) 26" Y. Oak	S11½°E	77.5'
4) 30" Y. Oak	S54°W	28.3'
5) 12" Tw. Hickory	N88½°W	75.0'
9) P.P.	E'ly	31.3'
10) Pipe line marker	N26°E	38.9'
11) Pipe line marker	N34°W	45.0'
8-31-1978	N. Fahrner No. 17620	W.E. Survey File No. R-4224
2" Iron pipe.		
3) 26" Y. Oak	S11½°E	77.5'
4) 30" Y. Oak	S54°W	28.3'
5) 12" Tw. Hickory	N88½°W	75.0'
9) P.P.	E'ly	31.3'
10) Pipe line marker	N26°E	38.9'
11) Pipe line marker	N34°W	45.0'
5-27-1972	A. Rentschler	LCRC L.2, P.33
3) 24" W. Oak	S11½°E	77.3'
4) 30" W. Oak	S54°W	28.3'
6) I.P.	WEST	33.0'
9) P.P.	EAST	31.0'
4-3-1974	P. Schwimmer	A-H Book 777-27
Found 1/2" I.P. in 2" I.P.		
3) 32" W. Oak	S15°E	77.50'
4) 36" W. Oak	S48°W	28.30'
8) Plow point	N88°W	5.5'
10) Gasoline marker	N22°E	38.90'
11) Gasoline marker	N34°W	45.00'
5-15-1975	A. Rentschler	Survey Job 75340
Found I.P.		
3) 24" Oak	S11½°E	77.3'
4) 30" Oak	S54°W	28.3'
6) I.P.	WEST	33.0'
9) P.P.	EAST	31.0'
12-5-1976	John Snyder	A-H Drw. 535-112
Shown as "found iron pipe" on drawing.		
3) 32" W. Oak	S15°E	77.5'
4) 36" W. Oak	S48°W	28.3'
8) Plow point	N88°W	5.5'
10) Gas line marker	N22°E	38.9'
11) Gas line marker	N34°W	45.0'
11-9-1977	A. Rentschler	Survey Job 77433
Found iron.		
3) Y. Oak	S11°E	77.3'
4) Y. Oak	S54°W	28.3'
6) R.O.W. pipe	WEST	33.0'
9) P.P.	EAST	31.0'
10-15-1979	R. Campbell No. 13028	LCRC L.5, P.249
Found 2" I.P. with 1/2" I.P. driven inside. Raised to surface with 3/4" I.P. and plastic plug. Set monument box at surface of new asphalt roadway.		
9) P.P.	S88°E	31.26' nail S. side
12) 14" Tw. Hickory	N87°W	75.2'
13) 8" Cherry	WEST	53.40' nail N. side
14) Pipe line marker	N45°E	45.7'
15) Pipe line marker	N40°W	49.3'
3-28-1980		A-H Book 810-49
NO DESCRIPTION OF MONUMENT		
5) 14"-14" Tw. Hickory	WEST	74.8'
9) P.P.	EAST	31.3'
13) 7" Cherry	WEST	53.4' to nail
14) Gasoline marker	N45°E	45.5'
15) Gasoline marker	N45°W	49.4'
3-15-1996	Atwell-Hicks, Inc.	Remonumentation
Found 3/4" IP in monument box. Set aluminum remonumentation cap with PK nail over found iron pipe.		
5) 16" Hickory with dead twin	WEST	74.45' to nail & RT
13) 10" Cherry	WEST	53.35' to nail & Rt
16) Guy pole S55°E		66.32' to nail & RT
17) U.P.	S87°E	52.22' to nail & RT
18) Pipe line marker	N45°W	52.13' to center