

APPROVED  
DATE 11-20-96  
CO. REP. KA

LAND CORNER RECORDATION CERTIFICATE  
Filing Requirement of Act 74, Mich. P.A. 1970

RECORDED  
WASHTENAW COUNTY, MI  
FEB 18 9 16 AM '97  
Page 1  
REC'D M. HAINES  
COUNTY CLERK/REGISTRAR

For corners in  
Washtenaw  
County

Located in:  
Ypsilanti

Corner Code  
J-09

1. Public Land Survey  
T 3 S R 7 E  
T  
T  
T  
T

2. Property Controlling  
in Section  
S  
S  
S  
S

3. Miscellaneous  
Property in Sec.  
S  
S  
S  
S

4. Lot No. , Recorded Plat  
5. Private Claims

Liber 000001 Page 0644 RM

Register of Deeds Stamp and File Number

I, Michael S. Hoben in a field survey on 10/28/1996  
do hereby certify that under requirements of P.A. 74, Michigan P.A. of 1970, the corner points  
mentioned in lines 1 and 2 above were in conformance with regulations and rules therefore as  
required in the current manual of survey instructions of the United States Department of the  
Interior, Bureau of Land Management, or by a decree of a Court of Law and/or that the corner  
points mentioned in lines 3, 4 and 5 above were in conformance with the rules of the Michigan  
Board of Land Surveyors or by a Decree of a Court of Law, established, re-established,  
monumented, re-monumented, recovered, found as expressed below.

NOTE: Not more than 4 corners, all in the same town and range, may be  
recorded on this certificate.

|    |    |    |    |    |    |    |   |   |   |   |   |   |   |
|----|----|----|----|----|----|----|---|---|---|---|---|---|---|
|    | A  | B  | C  | D  | E  | F  | G | H | I | J | K | L | M |
| 2  | 6  | 5  | 4  | 3  | 2  | 1  |   |   |   |   |   |   |   |
| 3  |    |    |    |    |    |    |   |   |   |   |   |   |   |
| 4  | 7  | 8  | 9  | 10 | 11 | 12 |   |   |   |   |   |   |   |
| 5  |    |    |    |    |    |    |   |   |   |   |   |   |   |
| 6  | 18 | 17 | 16 | 15 | 14 | 13 |   |   |   |   |   |   |   |
| 7  |    |    |    |    |    |    |   |   |   |   |   |   |   |
| 8  | 19 | 20 | 21 | 22 | 23 | 24 |   |   |   |   |   |   |   |
| 9  |    |    |    |    |    |    |   |   |   |   |   |   |   |
| 10 | 30 | 29 | 28 | 27 | 26 | 25 |   |   |   |   |   |   |   |
| 11 |    |    |    |    |    |    |   |   |   |   |   |   |   |
| 12 | 31 | 32 | 33 | 34 | 35 | 36 |   |   |   |   |   |   |   |
| 13 |    |    |    |    |    |    |   |   |   |   |   |   |   |

A. Description of original monument and accessories and/or subsequent restorations:

03/03/1816 G.L.O. SET POST  
23" LYNN N35E 48 LINKS  
18" ELM S38E 28 LINKS

( Witnesses Continued on Back ...)

B. Description of corner evidence found and/or method applied in restoring or reestablishing corner:

Fd. 3/4" I.P. over 1 1/2" i.p. 8" below pave

C. Description of monument for corner and accessories established to perpetuate locating the position of the corner:

10/28/1996 HOBEN 35994 O.H.M. REMON  
8 SET OHM WASHER WITH NAIL IN S. FACE OF TWIN 30" TREE N29  
9 SET OHM WASHER WITH NAIL IN S. FACE DE POLE N63E 87.54'  
10 SET OHM WASHER AND NAIL IN W. FACE OF 8" TREE S2W 25.72'  
11 SET NAIL AND OHM WASHER N FACE OF 15" TREE S62W 48.35'

SURVEY &  
REMONUMENTATION


MAY 05 1997

COMMISSION

We conclude that after careful study of the record documentation and field observations, that this corner is accepted as the  
best available evidence of the position of the original corner.

Signed by Michael S. Hoben Date 11-26-96  
Drafted by Michael S. Hoben  
Surveyor's Michigan License No. 35994  
Orchard, Hiltz and McCliment, Inc. 34935 Schoolcraft Road Livonia, MI 48150

COPY

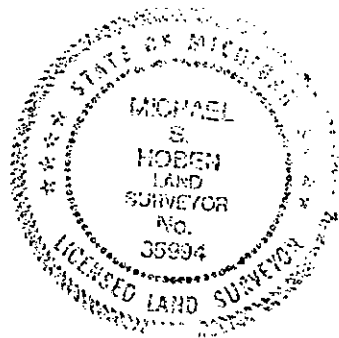

A. (Continued) Description of original monument and accessories and/or subsequent restorations:

01/01/1936 Atwell

Fd. I.p.

- 1 14" ELM S 28.2'
- 2 16" B. WALNUT S. 68.8'
- 3 36" ELM S.E. 104.9'
- 4 3" ELM S.W. 37.5'

02/13/1978 Burris 19563

L. 5, P

SAME AS ABOVE

05/29/1981 Carlson 14759

Fd. 3/4" steel stake

- 5 PK NAIL IN POLE S.W'LY 63.70'
- 6 PK NAIL IN POLE N.W'LY 67.80'
- 7 PK NAIL IN POLE N. ELY 57.40'