

SURVEY & REMONUMENTATION

Liber 000001 Page 0537 RM

-copy-

MAY 09 1995 LAND CORNER RECORDATION CERTIFICATE Filing Requirement of Act 74, Mich. P.A. 1970 COMMISSION

M-12 Page 1

For corners in Washington
Wayne County Located in: YPSILANTI Corner Code M-12

1. Public Land Survey	T	3	S	R	7	E
	T			R		
	T			R		
	T			R		
2. Property Controlling in Section	S			T		
	S			T		
3. Miscellaneous Property in Sec.	S			T		
	S			T		

4. Lot No. _____, Recorded Plat _____
5. Private Claims _____

Register of Deeds Stamp and File Number

I, Michael S. Hoben in a field survey on 03/01/1995
do hereby certify that under requirements of P.A. 74, Michigan P.A. of 1970, the corner points mentioned in lines 1 and 2 above were in conformance with regulations and rules therefore as required in the current manual of survey instructions of the United States Department of the Interior, Bureau of Land Management, or by a decree of a Court of Law and/or that the corner points mentioned in lines 3, 4 and 5 above were in conformance with the rules of the Michigan Board of Land Surveyors or by a Decree of a Court of Law, established, re-established, monumented, re-monumented, recovered, found as expressed below.

NOTE: Not more than 4 corners, all in the same town and range, may be recorded on this certificate.

	A	B	C	D	E	F	G	H	I	J	K	L	M
2	6	5	4	3	2	1							
3													
4	7	8	9	10	11	12							
5													
6	18	17	16	15	14	13							
7													
8	19	20	21	22	23	24							
9													
10	30	29	28	27	26	25							
11													
12	31	32	33	34	35	36							
13													

A. Description of original monument and accessories and/or subsequent restorations:

11/24/1816

G.L.O.

POST

- 18" BIRCH N. 75 LINKS E. 23 LINKS
- 18" DOGWOOD N. 89 LINKS W. 23 LINKS

(Witnesses Continued on Back ...)


B. Description of corner evidence found and/or method applied in restoring or reestablishing corner:

FD. MON IN MON BOX IN ASPHALT PAVE

C. Description of monument for corner and accessories established to perpetuate locating the position of the corner:

03/01/1995 Hoben 35994 OHM REMON

- 9 SET TAG IN 40" MAPLE N 19 W 178.40'
- 11 MON IN BOX N. 37.27'
- 16 SET TAG IN DE POLE N 35 E 112.83'
- 17 SET TAG IN DE POLE S 85 E 54.27'
- 18 SET TAG IN DE POLE S 15 E 162.62'
- 19 SET TAG IN DE POLE S 65 W 48.92'

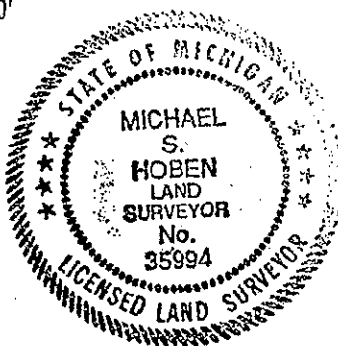

RECORDED
WASHINGTON COUNTY, MI
Mar 29 1 50 PM '96
COUNTY CLERK'S REGISTER
-copy-

We conclude that after careful study of the record documentation and field observations, that this corner is accepted as the best available evidence of the position of the original corner.

Signed by

Michael S. Hoben

Date

12-18-95

Drafted by Michael S. Hoben

Surveyor's Michigan License No. 35994

Orchard, Hiltz and McCliment, Inc. 34935 Schoolcraft Road Livonia, MI 48150

A. (Continued) Description of original monument and accessories and/or subsequent restorations:

12/03/1936	SIDNEY			STONE, POINTED TOP, BRICKS AROUND
	3 NAIL IN S. SIDE OF 18" MAPLE N, ELY 33.6'			
01/03/1938			W.C.R.C.	
	DIST. A-13 TO A-12 VAN BUREN = 2688.74'			
10/01/1944			W.C.R.C.	STONE, POINTED TOP, BRICKS AROUND, NOT OVER 12" DOWN
	5 I. P. NORTH 37.2' (VAN BUREN TWP. A-12)			
	7 SAME AS ABOVE			
11/20/1972	J. SNYDER	13352	ATWELL- HICKS	FD. 1/2" ROD IN MON. BOX AT CEN. LINE INT. N.S. & W. NORTH 37.26' FD. 1/2" ROD IN MON. BOX AT CEN. LINE INT.
	8 30" MAPLE N. 68 W. 103.0'			
	9 40" MAPLE N. 19 W. 178.2'			
	10 20" MAPLE N. 84 E. 105.0'			
	11 FD. 1/4" I.P. IN MON. BOX NORTH 37.26'			
03/31/1978	R. JAGOW	6998	ATWELL- HICKS	1/2" REROD IN MON. BOX
	12 SAME AS ABOVE			
05/15/1990	BLANCHARD	27446	E.P. KUBISKE	
	13 DIST. B/T L-12 & M-12 = 2659.00'			
	14 DIST. B/T M-12 & M-11 = 2651.03'			
	15 INTERNAL ANGLE L-12, M-12, M-11 = 90 08' 30"			

APPROVED
 DATE 10/16/95
 C. J. P. P. K.