

SURVEY & REMONUMENTATION

MAR 09 1998

RECORDED
WASHTENAW COUNTY, MI

JAN 22 8 30 AM '98

SECTION

LAND CORNER RECORDATION CERTIFICATE
Filing Requirement of Act 74, Mich. P.A. 1970

PEGGY M. HAINES
COUNTY CLERK/REGISTER

For corners in

Washtenaw (county)	Located In	Corner Code #
1. Public Land Survey	T 4S R 5E	I-12
	T R	
	T R	
	T R	
2. Property Controlling in Section	S T R	
3. Miscellaneous Property in Sec.	S T R	

- COPY -
Liber 000002 Page 0020 RM
Register of Deeds Stamp & File Number

4. Lot No. _____, Recorded Plat _____
5. Private Claims _____

I, R. Timothy Tietsema, in a field survey on 16 April, 1997
do hereby certify that under the requirements of P.A. 74, Michigan P.A. of 1970, the corner points mentioned
in lines 1 and 2 above were in conformance with the regulations and rules therefore as required in the current
manual of survey instructions of the United States Department of the Interior, Bureau of Land Management of
by a decree of a Court of Law and/or that the corner points mentioned in lines 3, 4, and 5 above were in
conformance with the rules of the Michigan Board of Land Surveyors or by a Decree of a Court of Law;
established, re-established, monumented, recovered, found as expressed below.

NOTE: Not more than 4 corners, all in the same town and range, may be recorded
on this certificate.

A. Description of original monument and accessories and/or subsequent restoration:

7/30/1819	GLO	Fld. Notes	Set Original Corner	1) 8" Elm 2) 12" Red Oak	N04E S48W	14 links (9.24') 8 links (5.28')	Set Post for 1/4 Corner between Sec. 34 & 35
3/2/1979	Norm Fahrner 17620	LCRC L.S.P.214	Set 1/2" Iron Pipe on split between NE & SE corners	3) 18" Ash 4) 8" Ash 5) 10" Multi Ash 6) 5" Maple	N85E N80E N35E S65E	12.78' to nail 25.79' to nail 36.42' to nail 6.08' to nail	N-S fence line East 7.0'
3/3/1979	Norm Fahrner 17620 JOB NO:17953	Boundary	1/2" Iron Pipe	3) 18" Ash 4) 8" Ash 5) 10" Multi Ash 6) 5" Maple	N85E N80E N35E S65E	12.78' to nail 25.79' to nail 36.42' to nail 6.08' to nail	N-S fence line East 7.0'
8/18/1979	Robert Roskelly 18663 JOB NO:83-7-79	Boundary	Fnd. Iron Pipe	3) 18" Ash 4) 8" Ash 5) 10" Multi Ash 6) 5" Maple	N85E N80E N35E S65E	12.78' to nail 25.79' to nail 36.42' to nail 6.08' to nail	N-S fence line East 7.0'

B. Description of corner evidence found and/or method applied in restoring or reestablishing corner:

In April of 1997 LSC found a 1/2" Iron Pipe from three previous witnesses (3,4 & 6), a Remonumentation Cap was set on the existing iron pipe.

C. Description of monument for corner and accessories established to perpetuate locating the position of the corner:


Found 1/2 Iron Pipe and added Remonumentation Cap.

3) 24" Ash	N85E	12.78' to P.K. & r/t	N-S fence line
4) 12" Ash	N80E	25.79' to P.K. & r/t	East 7.0'
6) 10" Maple	S65E	6.08 to P.K. & r/t	
7) 14" Elm	N10E	11.80' to P.K. & r/t	

APPROVED
DATE 12/2/97
CO. REP. K

It is our opinion that this corner represents the original corner and is accepted as a careful and faithful re-establishment of the position of the original corner.

Signed by R. Timothy Tietsema
Surveyor's Michigan License No. 20712

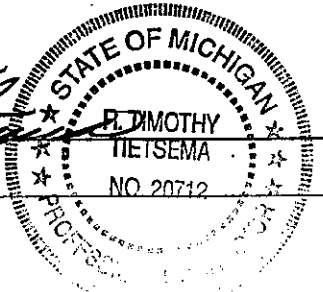

Date 2 December 1997