

MAY - 1 1995

LAND CORNER RECORDATION CERTIFICATE

Filing Requirement of Act 74, Mich. P.A. 1970

COMMISSION

L-11 Page 1

For corners in

Washtenaw

Located in: SALINE Corner Code

County

Public Land Survey

T 4 S R 5 E

L-11

Property Controlling

S

in Section

S

Miscellaneous

S

Property in Sec.

S

T	4	S	R	5	E
T			R		
T			R		
T			R		
T			R		
S			R		
S			R		
S			R		
S			R		

Lot No. _____, Recorded Plat _____

Private Claims _____

L152

1 PAGE 372 RM
COPY

Register of Deeds Stamp and File Number

Michael S. Hoben in a field survey on 06/20/1994
 I hereby certify that under requirements of P.A. 74, Michigan P.A. of 1970, the corner points mentioned in lines 1 and 2 above were in conformance with regulations and rules therefore as required in the current manual of survey instructions of the United States Department of the Interior, Bureau of Land Management, or by a decree of a Court of Law and/or that the corner points mentioned in lines 3, 4 and 5 above were in conformance with the rules of the Michigan Board of Land Surveyors or by a Decree of a Court of Law, established, re-established, monumented, re-monumented, recovered, found as expressed below.

NOTE: Not more than 4 corners, all in the same town and range, may be recorded on this certificate.

Description of original monument and accessories and/or subsequent restorations:

07/21/1819

G.L.O.

SET POST

5" SUGAR TREE S 4 W 13 LINKS

8" SUGAR TREE N 18 W 4 LINKS

(Witnesses Continued on Back ...)

Description of corner evidence found and/or method applied in restoring or reestablishing corner:

FD. 3/4" IRON PIPE

INSIDE OF 1 1/4" I.P. 6"

DEEP

Description of monument for corner and accessories established to perpetuate locating the position of the corner:

06/20/1994

HOBEN

35994

O.H.M.

REMON

- 11 SET W.C.R. CAP OVER IRON.
- 11 P.K. NAIL W/W.C.R. TAG ON S. SIDE N 30 E 44.54'
- 12 P.K. NAIL W/TAG S. SIDE D.E. POLE N 50 W 271.55'
- 13 P.K. NAIL W/W.C.R. TAG ON S. SIDE N 72 E 354.50'
- 14 P.K. NAIL W/W.C.R. TAG ON 4" BOX ELDER S 76 E 354.30'

I conclude that after careful study of the record documentation and field observations, that this corner is accepted as the best available evidence of the position of the original corner.

Signed by

Michael S. Hoben

Date

Dec 29, 1995

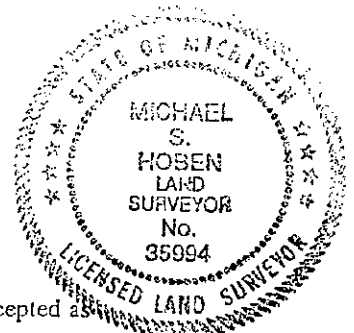
Attested by Michael S. Hoben

Surveyor's Michigan License No. 35994

Richard, Hiltz and McCliment, Inc. 34935 Schoolcraft Road Livonia, MI 48150

	A	B	C	D	E	F	G	H	I	J	K	L	M
2	6		5		4		3		2		1		
3													
4	7		8		9		10		11		12		
5													
6	18		17		16		15		14		13		
7													
8	19		20		21		22		23		24		
9													
10	30		29		28		27		26		25		
11													
12	31		32		33		34		35		36		
13													

 RECORDED
 FEB 1 8 55 AM '95
 COUNTY CLERK/REGISTER
 PEGGY M. JAINES
 -COPY-

 RECORDED
 FEB 1 8 55 AM '95
 WASHTENAW COUNTY, MI


A. (Continued) Description of original monument and accessories and/or subsequent restorations:

03/08/1933	ARMSTRONG	W.C.R.C.	BLO	FD. A LARGE STONE & RESET With 1 1/2" I.P. WITH 4 BRICKS AROUND IT
1	18" ELM N 80 E 349.75'			
2	1" CHERRY S 71 W 61.9'			
3	P.P. N 57 1/2 E 42.2'			
4	2 RIGHT-OF-WAY PIPES			
5	2689.5' EAST OF THE NW COR SEC.36			
04/27/1972	RICHARD	13040	ASSOCIATED ENGINEERS & SURVEYORS, INC..	L.2 P FD. 1 1/4" IRON PIPE & SET A 3/4" IRON PIPE INSIDE THE 1/1/4" IRON PIPE
6	TELE. PEDISTAL N 25 E 31.10'			
7	NAIL IN ELEC. POLE N 60 E 44.56'			
8	SPIKE IN TRIPLE BOX ELDER S 65 E 60.33'			
06/27/1991	RICHARD	13040	ASSOCIATED ENGINEERS & SURVEYORS, INC.	SURVEY IRON PIPE
6	TEL. PAD N25 E 30.50'			
7	P.P. N 60 E 44.53'			
9	36" ELM N 60 E 342.52'			
10	ANGLE IRON POST S 85 E 331.90'			

APPROVED

DATE 10/17/94

CO. REP. H