MAY v 6 2000

SECTION

LAND CORNER RECORDATION CERTIFICATE Filing Requirement of Act 74, Mich. P.A. 1970

For c	corners in		ı		
	WASHTENAW (County)	Located in:	Corner Code #		
,	Public Land Survey AUGUSTA TWP	T 4S R 7E T R T R T R T R		02/0	697 : 1 of 2 :7/2000 02:55P P-268
۷. ا	Property controlling in Section	S T R	Peggy M. Haines - Was	shtenaw Co. CORREM L-Z	1 244
3	Miscellaneous	S R	Regis	ster of Deeds Stamp & f	File Number
	Property in Sec.	S T R			
_		Discount Disk		ABCDEFGI	1
4. 5	Lot No	, Recorded Plat			
٥.	11144CC OIGHTS			2 - 5 - 5 5 5	1-2-1-1
				3	
				4 - - - - - - - - - - - - - - - -	,,,,,,,,,,,,,,,,,,,,,,,,,,,,,,,,,,,,,,,
	ו אמו ב מבענים	, in a field survey on OCTOBE	R 02 , 19 99	5	
do h	ereby certify that under	requirements of P.A. 74, Michigan P.A. of	1970, the corner points mentioned	6 13 17 16 7	
in h	nes i ana z abave wer	the United States Department	ent of the interior, Bureau of Land	8 -19 -29 -21	
Manc	igement or by decree of	Court of Law and/or and or corner of	Land Surveyors or by Decree of a	9	
Cour	rt of Law; established,	re-established, monumented, re-m	onumented, recovered, found as	10 30 -29 - 28	27-26-25
expr	ressed below:			11	
	1999 REMONUMENT	TATION CORNER		12 31 32 33	36-36-
				13	
A.	Description of orig	inal monument and accessories	and/or subsequent restoration:		
	C.L.O JOSEPH 1				
	SET POST		o Luise		
	8" IRONWOOD	N 49°E S 49°W	9 LINKS 32 LINKS		
	5" IRONWOOD	3 73 11	— — — — — — — — — — — — — — — — — — —		
		a tu t Bade			
		Continued on Back			
8.	Description of cor	mer evidence and/or method ap	oplied in restoring or reestablish	ning corner:	
		PIPE IN MONUMENT BOX AT TH SES, SET ALUMINUM REMON. CAP	coocotonou os unchinchal	M AND MILLOW NOO!	
	COUND FIVE (5) F	REMAINING WITNESSES.			

C. Description of monument for corner and accessories established to perpetuate locating the position of the corner:


1/2" IRON PIPE WITH ALUMINUM REMON. CAP STAMPED #41092 IN MONUMENT BOX AT INTERSECTION OF HITCHINGHAM AND WILLOW RDS.

1/2" IRON PIPE WITH ALUMIN OF HITCHINGHAM AND WILLOY 8) 22" PINE 9) 16" PINE 10) 22" PINE 7) GUY POLE 11) WOOD FENCE POST 6) U. POLE 12) P. POLE	N 40° E N 32° E N 25° E N 62° E S 17° E S 32° W N 08° W	54.92' 60.78' 67.6' 62.56' 53.98' 44.62' 116.14'	SET NAIL/TAG WEST SIDE SET NAIL/TAG WEST SIDE TO WEST CENTER OF TREE SET NAIL/TAG NW SIDE SET NAIL/TAG WEST SIDE SET NAIL/TAG NORTH SIDE SET NAIL/TAG WEST SIDE	LORI E. BEYER PROFESSIONAL BOYER NO. 41092 POFESSIONAL BOYER NO. 41092
				OFESSIONAL INTERPRETATION

AFTER CAREFUL EXAMINATION OF RECORD DOCUMENTATION AND FIELD OBSERVATIONS, I BELIEVE THIS POINT SHOULD BE ACCEPTED AS THE BEST AVAILABLE EVIDENCE OF THE POSITION OF THE ORIGINAL CORNER.

THIS CORNER WAS RATIFIED BY THE PEER REVIEW COMMITTEE ON NOVEMBER 22, 1999.

	•		APPROVED 199
Signed by Law E. Beyon	Date	Dec 03, 1999	CO. REF
Surveyor's Michigan License No. 41092		FORM APPROVED BY MICHIGAN STATE BOARD C	F LAND SURVEYORS, JAN. 28, 15 REVISED MAY 14, 19

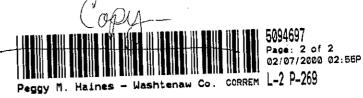

E-9 CONTINUED FROM PARAGRAPH A

MY ON

WASHTENAW COUNTY ROAD COMMISSION GRID BOOK - M. ROYCE, R. GRAF - OCTOBER 1928

FOUND PIRAMID STONE AND SET UNDER SAME 1 1/4" x 30" IRON PIPE.

1) 20" APPLE N 32' W 127.4'

2) 20" W. CHERRY S 24W 68.65'

3) 18" APPLE N 50' E 72.85'

4) 22" TAMARACK N 76' E 118.25'

WASHTENAW COUNTY ROAD COMMISSION GRID BOOK - HAND POSTED - R.B. 6-61

ASHIENAW CO MON. BOX 3) APPLE 5) T. POLE 6) E. POLE 7) T. POLE N 50° E S 15° E S 37° W N 61° E 72.10' 67.65' 44.74' TO NAIL TO NAIL 63.00

L.C.R.C. LIBER 4 PAGE 50 — ROBERT J. JAGOW #6998 — SEPTEMBER 1975

FOUND 1/2" REBAR IN MON. BOX

3) 28" APPLE N 50° E 72.7'

8) 14" PINE N 40° E 55.3'

9) 12" PINE N 35° E 60.9'

10) 14" PINE N 30° E 67.6'

WASHTENAW COUNTY ROAD COMMISSION — FIELD BOOK — ROBERT CAMPBELL, JR. #13028 — JUNE 1981 .

FOUND 3/4" REBAR IN MON. BOX

3) 25" APPLE N 52* E 72.9*
8) 15" PINE N 41* E 55.7*
9) 12" PINE N 33* E 61.1'
10) 13" PINE N 33* E 67.7*
6) P. POLE S 37* W 44.62' SET NAIL SE SIDE

SURVEY& NOTATION REN

WAY 0 3 2000

SECTION