

Plat of the Subdivision of Lot 5 of the Subdivision of the
 Place of the Regimide farm North of North St
 Detroit Michigan



Recd for record this 19th May 1854 at 10 o'clock a.m.
 Henry Conkling
 Registrar

LINE 100' OUT LOT 5 N 60° E	1	2	3	100
-----------------------------	---	---	---	---	---	---	---	---	---	----	----	-----

Recd by the above to be bound from
 Detroit April 24. 1854
 John F. Murray & Munn & Munro

145551
 FEB 14 1856
 (Clerk of Court)

We Oliver Bellair and Catherine Bellair do hereby approve and adopt
 the annexed or within plat of the Subdivision of Lot 5 of the Subdivision
 of the Place of the Regimide farm North of North Street Detroit
 Michigan and authorize the same to be recorded May 15th 1854
 Oliver Bellair's LS
 Catherine X Bellair's LS
 made

State of Michigan
 Wayne County } On this 15th May 1854 personally
 appeared before me a Notary Public in & for said County
 Oliver Bellair & Catherine his wife known to me to be the persons who
 executed the above & acknowledged the same to be their free act
 and deed and the said Catherine being by me privately examined
 separate & apart from her said husband acknowledged she
 executed the above freely without fear or compulsion of any one
 John M. Babyngple
 Notary Public
 Wayne Co Mich

G J B Crance Subdivision of Lots 32. 33. 34 Williams Subdiv.
 of Park Lots, City of Detroit Michigan

Elizabeth Street

30	30	30	30
1	2	3	4
30	30	30	30



Recd for record this 22nd July
 1854 at 12 o'clock Noon

I know all Men by these Parties that are F J B Crance
 and Anna Elizabeth his wife, of Detroit Michigan do hereby present for
 record the above plat being a Subdivision of Lots number Thirty five, Thirty
 three and thirty four of Williams Subdivision of Park Lots City of Detroit
 State of Michigan Witnesses our hands and seals this fifteenth day of May
 1854

Executed in presence of
 Walter Crance
 Henry Crance
 F J B Crance
 A E Crance

State of Michigan } On this nineteenth day of July 1854 the above
 Wayne County } named F J B Crance and Anna Elizabeth his wife
 to me known as the persons decended in and who executed the above plat
 appeared before me and duly acknowledged the execution thereof and the said Anna
 Elizabeth on a private examination separate and apart from her husband acknowledge
 knowledge she executed the same freely without fear or compulsion of her said
 husband or any one
 Walter Crance Notary Public
 Wayne Co Mich

I hereby certify that these plates are correct copies of the plates
 now on record in the Register of Deeds office being made under
 the supervision of the Auditor General by tracing the plat on
 record and affixing thereto a carefully compared copy of the
 dedication or certificate
 Dated this 11th day of May 1910
 John B La Fountain
 Clerk and Gen Dep't

Map attached

Pa 920

Li 17975

Rec 2-3-72

Wayne
10/05

By Councilman Hood:

Resolved, That all that part of the north - south public alley, 17 feet wide, in the block bounded by Orleans, Dequindre, Hale, and Mack Avenue having been platted as the westerly 17 feet of lot 33 of the Flat of the Subdivision of Lot 5 of the Subdivision of the rear of the Dequindre Farm, north of North Street, now Division Street as recorded on May 19, 1854, in Liber 53, Page 195, Deeds, Wayne County Records.

Be and the same is hereby vacated as a public alley to become a part and parcel of the abutting property, subject to the following:

Provided, That if at any time in the future it becomes necessary to remove the paved alley return and construct new curb and sidewalk, said construction will be done by City permit, according to Department of Public Works inspection and specification and the entire cost is to borne by the petitioner or his assigns, and further

Provided, That the petitioner, at his expense, perform the following:

1. Erect a cement block wall, approximately 12 feet high, along the west side of the alley proposed to be vacated. This wall to be three (3) feet, six (6) inches from the east side of the home adjacent said alley.

2. Erect a cement block wall across the south end of the seventeen (17) foot wide alley, proposed to be vacated, to tie into the existing wall along the west boundary of the Illinois Iron and Metal Company's property. This wall is to be the same height as the aforementioned existing wall.

3. Erect a loading ramp and dock in the north - south alley to be vacated to permit better use of existing access door located in the west wall of the present storage and office building.

4. Also, to have installed at his own expense a large Detroit Edison overhead light to illuminate the remaining east-west alley and the rear yards of the homes on Hale Avenue. The light is to be located on an existing telephone pole located at the east end of the twenty (20) foot wide east-west alley that is to remain open.

Adopted as follows:

Yeas — Councilmen Browne, Eberhard, Hood, Levin, Rogell, Van Antwerp, Wierzbicki, and President Ravitz — 8.

Nays — None.

STATE OF MICHIGAN) ss.
CITY OF DETROIT)

SHORT FORM--TRUE COPY CERTIFICATE

I, GEORGE C. EDWARDS, CITY CLERK of the City of Detroit, do hereby certify that the annexed paper is a True Copy of a Resolution

adopted by the Common Council on

JAN 25 1972

and approved by the Mayor on

FEB 1 1972

as appears from the Journal of said Common Council, on file in my office.

IN WITNESS WHEREOF, I have hereunto set my hand and affixed the Corporate Seal of said City, at Detroit, on 2-3-72

George C. Edwards

CITY OF DETROIT
CITY CLERK


FORWARD TO STATE
TREASURER

PETITION NO. 3087
ILLINOIS IRON & METAL CO.
1830 MACK AVE.
C/O JOE HACKER
PHONE 831-1429

APPROVED JANUARY 25, 1972

10105

REQUESTED
VACATION

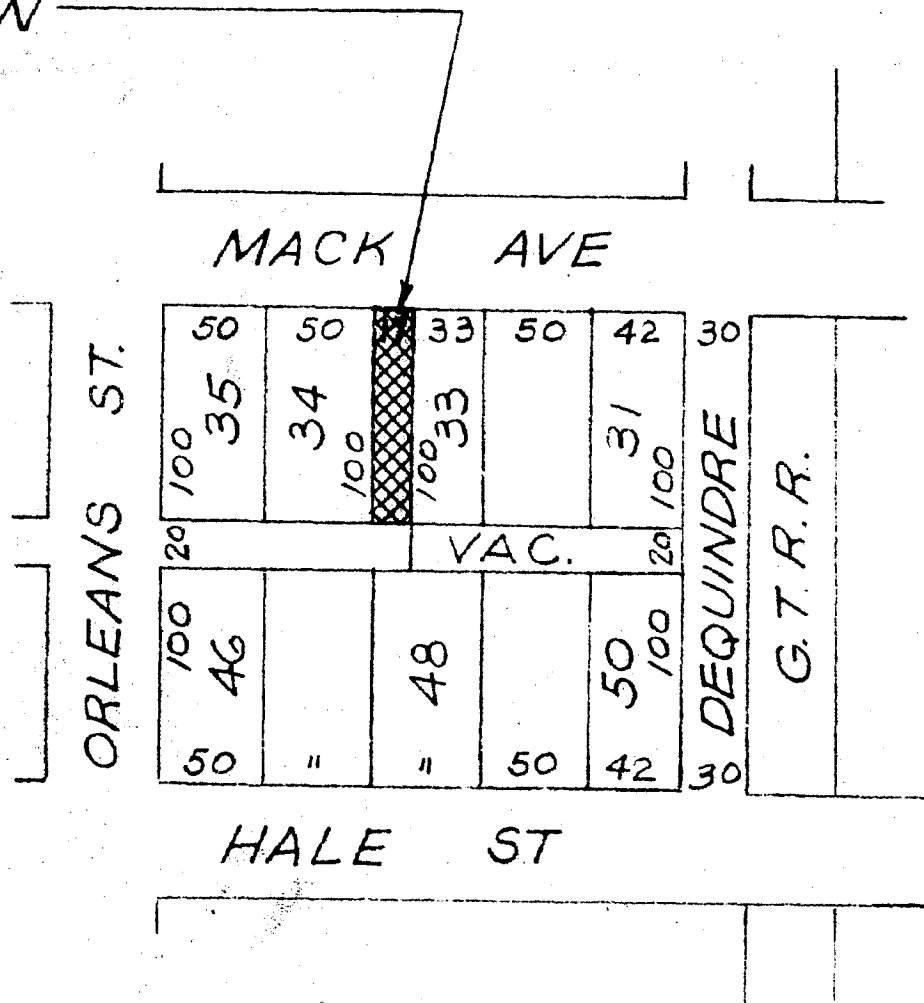

PLAT OF LOT 5 REAR
OF DEQUINDRE FARM
TOPO NO. 39 C

FOR OFFICE USE ONLY

B						REQUESTED VACATION OF THE N.-S. ALLEY S. OF MACK BET. DEQUINDRE & ORLEANS	CITY OF DETROIT Dept. of Public Works City Engineers Office		
A									
DESCRIPTION								Drwn	Chkd
REVISIONS								Appd	Date
DRAWN BY PLUNGIS		APPROVED							
TRACED BY		APPROVED							
CHECKED		APPROVED							
CITY ENGINEER									
						Job No. 1(1)			
						Drwg. No. X-3087			
						Date 10-28-71			

By Councilman Ravitz:
Resolved, That all of Pierce Street, 40 feet wide, east of Riopelle Street, as platted in P. J. B. Crane's Subdivision of Outlots 53, 54, 57 and 58 of Riopelle Farm as recorded in Liber 53, Page 346 of Deeds Wayne County Records lying south of and adjoining the westerly line of Lot 15, south of and adjoining the southerly line of the 15.64 foot public alley adjoining Lot 15, north of and adjoining the northerly line of Lot 16, north of and adjoining the southerly line of the 15.64 foot public alley adjoining Lot 15, all of the above mentioned subdivision;
Also all that part of Dequindre Street, 29.88 feet wide, south of Scott Avenue, as platted in the Plat of the Subdivision of Lot 5 of Dequindre Farm as recorded in Liber 53, Page 195 of Deeds Wayne County Records lying east of and adjoining the easterly line of Lot 17 of the above mentioned subdivision;
Also all that part of Dequindre Street, south of Scott Avenue as platted in the Subdivision of the north 60.00 feet of Outlot 6 of the Subdivision of the Dequindre Farm as recorded in Liber 12, Page 64 of Deeds Wayne County Records lying more particularly described as follows: Beginning at the northeast corner of Lot 1 of the above mentioned subdivision, thence southerly along a line 44.74 feet to a point in the southerly line of Lot 1, said point being 23.00 feet easterly of the south-west corner of said Lot 1; thence southerly along a line 23.00 feet easterly of and parallel to the west line of Lot 1, 20.00 feet to a point; thence easterly along a line 60.00 feet south-easterly of and parallel to the northerly line of Lot 1, 49.88 feet to a point in the easterly line of Dequindre Street, No. 574, being in fact the southerly line of Lot 10 and 22 of P. J. B. Crane's Subdivision of Outlots 53, 54, 57 and 58 Riopelle Farm as recorded in Liber 53, Page 346 of Deeds Wayne County Records lying north of and adjoining the northerly line of Lots 11 and 31, north of and adjoining the northerly line of the 15.64 foot alley lying between Lots 10 and 22, 10 and 22, south of and adjoining the southerly line of Lot 5, both inclusive, north of and adjoining the northerly line of Lot 5, 76 to 80 both inclusive, all of the above mentioned subdivision;
Also all of the north-south public alley, 15.64 feet wide, east of Riopelle Street between Scott Street and Hale Street as platted in P. J. B. Crane's Subdivision of Outlots 53, 54, 57 and 58, Riopelle Farm as recorded in Liber 53, Page 346 of Deeds Wayne County Records lying east of and adjoining the easterly line of Lot 5 to 10, both inclusive, west of and adjoining the westerly line of Lot 32 and 33, all of the above mentioned subdivision;
Also, all that part of the east-west public alley, 20 feet wide, east of Riopelle Street between Hale Street and Scott Street, as platted in the Plat of Subdivision of Lot 5 of Subdivision of Rear of Dequindre Farm as recorded in Liber 53, Page 195 of Deeds Wayne County Records lying north of and adjoining the northerly line of Lots 61 to 65, both inclusive, south of and adjoining the southerly line of Lots 56 to 60 both inclusive, all of the above mentioned subdivision;
Be and the same are hereby vacated as public streets and alleys to become a part and parcel of the adjoining property subject to the following provisions:
1) Provided, That by reason of the vacation of the above described street and alleys, the City of Detroit does not waive any right to the sewer located therein and at all times shall have the right to enter upon the premises, if found necessary on account of said sewer to repair, alter, or service same; and further
2) Provided, That if a building is to be constructed over said sewer, the sewer shall be replaced with cast-iron pipe of same size, rerouted or encased in 6 inches of Class "A" concrete, or in lieu of the above, such work shall be done as will be specified by the City Engineer, all of the work mentioned to be done under the supervision and inspection of the Department of Public Works and all costs entailed to be borne by the petitioners, their successors, or assigns; and further
3) Provided, That no buildings shall be constructed over said sewer without the prior approval of such building construction by the City Engineer and the Department of Buildings and Safety Engineering; and
4) Provided, That in the event that the sewer located in said street and alleys, if built upon, shall break causing damage to any construction above, the petitioners and their assigns by acceptance of the permit for building over said sewer, waive all claims for damages to such construction and agree to pay all costs incident to the repair of said broken sewer; and further
Resolved, That the petitioner at his own expense and under City specifications and inspection construct a new manhole in Scott Street at the alley east of Riopelle Street.
Adopted as follows:
Yeas—Councilmen Brickley, Connor, Patrick, Ravitz, Rogell, Van Antwerp, Wierzbicki and President Carey—8.
Nays—None.

STATE OF MICHIGAN)
CITY OF DETROIT) ss.

SHORT FORM--TRUE COPY CERTIFICATE

I, THOMAS D. LEADBETTER, CITY CLERK of the City of Detroit, do hereby Certify that the annexed paper is a True Copy of a Resolution


adopted by the Common Council on 5-21-63

and approved by the Mayor on 5-28-63

as appears from the Journal of said Common Council, on file in my office,

IN WITNESS WHEREOF, I have hereunto set my hand and affixed the Corporate Seal of said City, at Detroit, on

Thomas D. Leadbetter
City Clerk

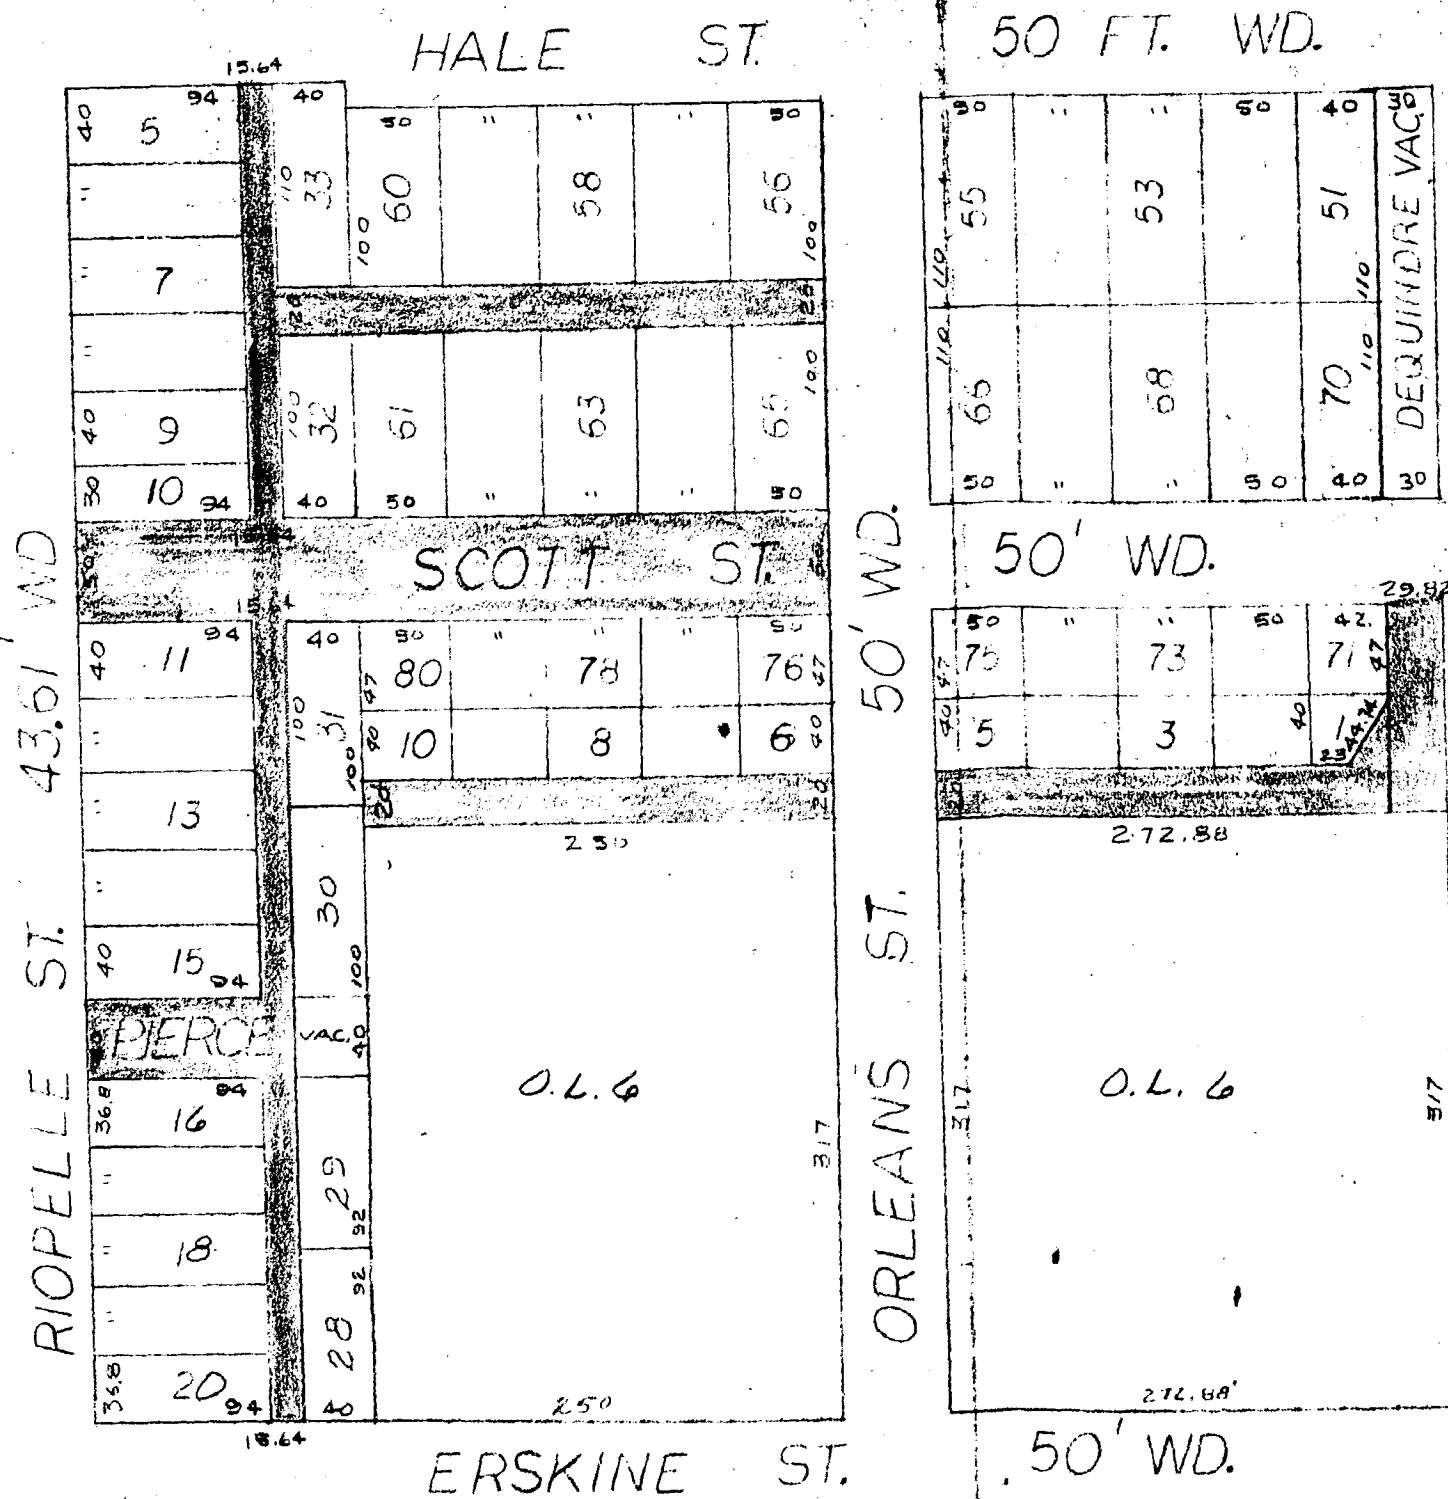

REQUESTED VACATIONS
STREETS & ALLEYS
IN RED

PETITIONER:
DEPARTMENT OF WATER SUPPLY

CRANE'S SUB'N
FARRAND'S SUB'N
PLAT OF DEQUINDRE FARM
TOPO. 39

FOR OFFICE USE ONLY

DESIGNED BY	APPROVED:	CITY OF DETROIT	REQUESTED VACATION AREAS IN RED
DRAWN BY	W. J. K.	DEPARTMENT OF PUBLIC WORKS	BOUNDED BY RIOPELLE, HALE, GRAND TRUNK RR, & ERSKINE
TRACED BY	ENGINEER OF	CITY ENGINEER'S OFFICE	BOOK NO.
CHECKED BY	R. K.	BUREAU OF DESIGN	PAGE NO.
DATE			SCALE 1" = 100'
			DATE 2-18-63
			DRG. NO. X-2192

