


# Field Notes

Sections 354 + 355 of Brawnstown owned by L CASS

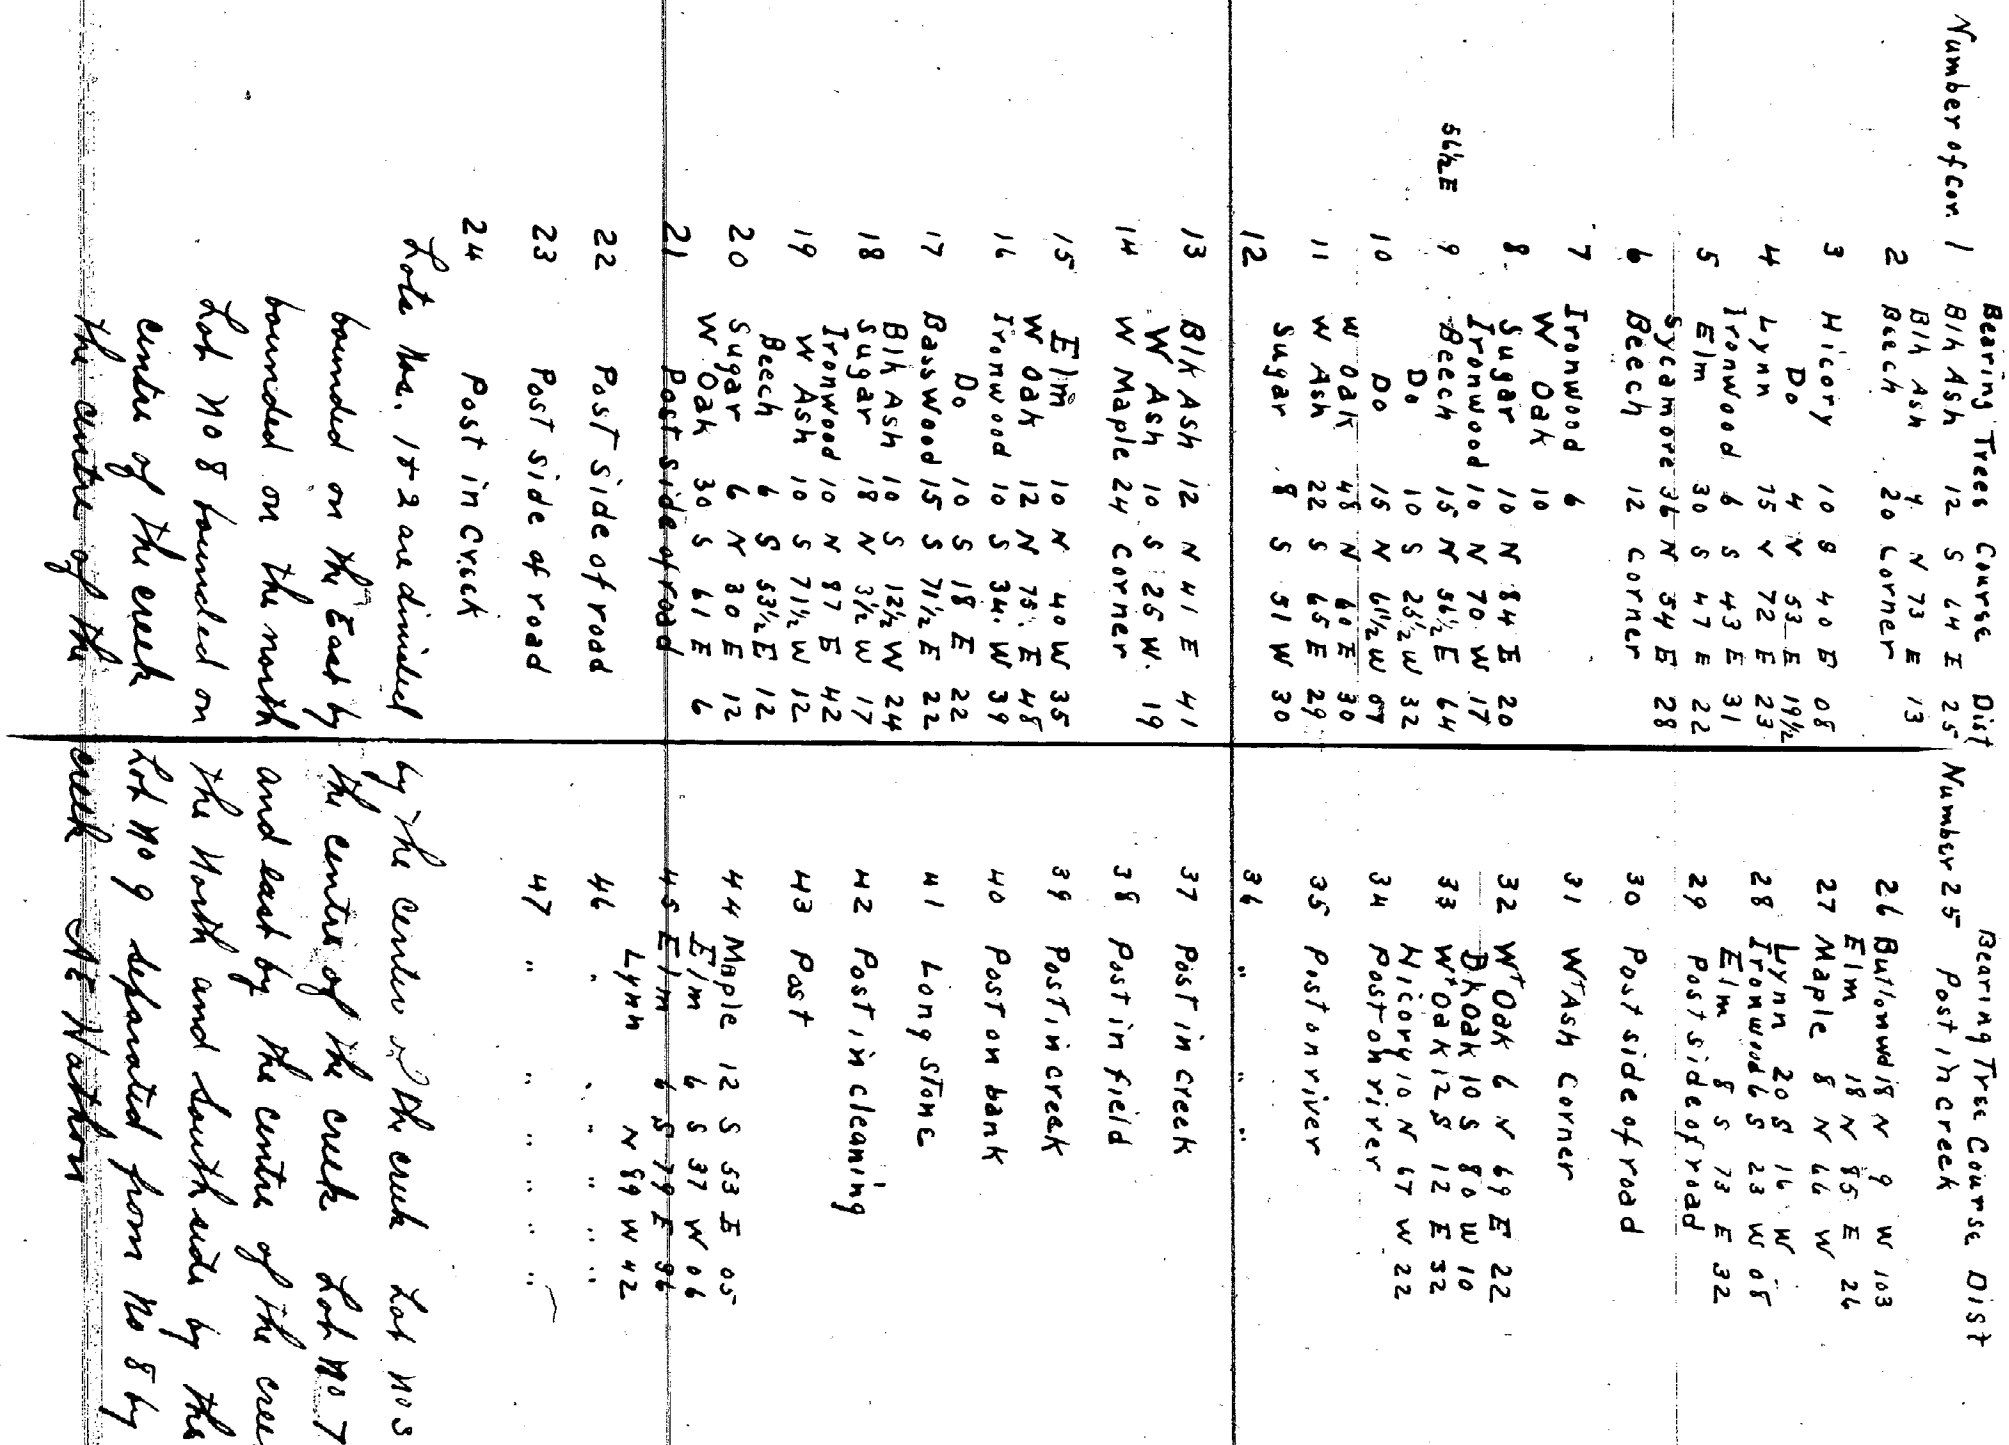

by the center of the creek lot nos  
the entire of the creek lot no 7  
and east by the entire of the creek  
the North and South sides by the  
lot no 9 separated from no 5 by  
a creek at Northern

John B. & Aunt Ann  
Black and Ben Deth.