

I certify the above to be correct from actual survey
Detroit Oct 22 nd 1866 John F. Munroe

2 John W Johnson of the City of Detroit do hereby adopt this Plan
Map of the Subdivision of Division Number Seven bounded and
Twenty nine (29) North of Chicago road for the purpose of naming the

Asme. RECORDED
In presence of
Alexander
Wm J. Watkinson

On this 31st day of October ad. 1866 James appeared before me a Notary for said County the above named J. W. Garrison to me known to be the same person who executed the above instrument and acknowledged the same to be his free act and deed W. Q. Westerman

Watson
Notary Public for
Wayne Co. Mich.

State of Michigan } On this day of A D 1866 personally appeared before
me a Notary for said county the within named
John F Myrnes to me known to be the same person who executed
this within Catholic as lawyer and acknowledged the same to
be his free act and deed

Wayne County Register office

We hereby consent to and
 approve of this deed of gift
 of the 31st of A D 1866
 N P Goldsman
 the groom
 in presence of
 J. W. Watson Notary Public
 Commissioner

in presence of
us
Jesse Watsonman Notary Public
This is to certify that the above plat has been compared with the original plat of record in the office of the Register of Deeds of Wayne County and found to be a true copy of the same
A. H. W. Linnarth A.D. 1903
Surveyor

I hereby certify that this plat is a correct copy of the plat now on record in the Registrar of Deeds office being made under the supervision of the Auditor General by tracing the plat in record and affixing thereto a carefully compared copy of the ~~deduction~~ and certificate
Dated this 26th day of May 1910
John B. Ho fountain
John Wood Sen Esq.

SULLIVAN

7
MAHA BUILDING
SUNSHINE CITY
APR 7 JUL 7 1964


PET. N. NO. 5537
PETITIONER: OMAHA BUILDING
COMPANY, ET AL.
1530C WYOMING

<h1 style="margin: 0;">RECOMMENDED EASEMENT</h1>		<h2 style="margin: 0;">BASE EASEMENT</h2>		<h2 style="margin: 0;">60' WD.</h2>	
<h3 style="margin: 0;">SECTION PARK SUB'D. NO. 1</h3>		<h3 style="margin: 0;">TOPS NO. 73</h3>		<h3 style="margin: 0;">SCALE: 1"=100'</h3>	
<h4 style="margin: 0;">FOR CITY OF DETROIT USE ONLY</h4>		<h4 style="margin: 0;">RECOMMENDED EASEMENT</h4>		<h4 style="margin: 0;">E/W 4-LEW EASEMENT OF BASEMENT & SOUTH CH</h4>	
<h4 style="margin: 0;">CITY OF DETROIT</h4>		<h4 style="margin: 0;">DEPT. OF PUBLIC WORKS</h4>		<h4 style="margin: 0;">CITY ENGINEER'S OFFICE</h4>	
<h4 style="margin: 0;">JOB NO. MC 100</h4>		<h4 style="margin: 0;">Dwg. No. 100</h4>		<h4 style="margin: 0;">Date 12-2-68</h4>	

<h1 style="margin: 0;">RECOMMENDED EASEMENT</h1>		<h2 style="margin: 0;">BASE EASEMENT</h2>		<h2 style="margin: 0;">60' WD.</h2>	
<h3 style="margin: 0;">SECTION PARK SUB'D. NO. 1</h3>		<h3 style="margin: 0;">TOPS NO. 73</h3>		<h3 style="margin: 0;">SCALE: 1"=100'</h3>	
<h4 style="margin: 0;">FOR CITY OF DETROIT USE ONLY</h4>		<h4 style="margin: 0;">RECOMMENDED EASEMENT</h4>		<h4 style="margin: 0;">E/W 4-LEW EASEMENT OF BASEMENT & SOUTH CH</h4>	
<h4 style="margin: 0;">CITY OF DETROIT</h4>		<h4 style="margin: 0;">DEPT. OF PUBLIC WORKS</h4>		<h4 style="margin: 0;">CITY ENGINEER'S OFFICE</h4>	
<h4 style="margin: 0;">JOB NO. MC 100</h4>		<h4 style="margin: 0;">Dwg. No. 100</h4>		<h4 style="margin: 0;">Date 12-2-68</h4>	

James D. Padgett
City Clerk

~~Open~~ JUL 7 1964

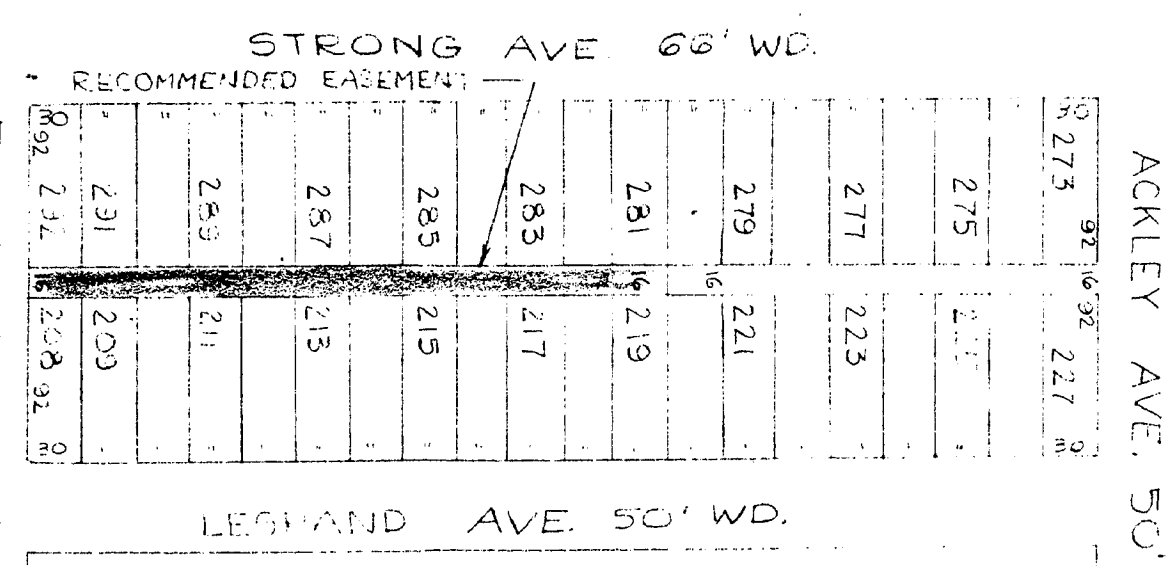

H.L. BAKER SUB'N.
TOP NO. 49
SCALE 1"=100'

CITY OF DETROIT Dept. of Public Works City Engineers Office									
Job No. MD(1)									
Drawg. No. X-2285									
Date 4-28-64									

By Councilman Browne:
WHEREAS, the City of Detroit is undertaking the rehabilitation of the area known as the Ash-Humboldt Rehabilitation Project, pursuant to Act 344 of the Public Acts of 1945, as amended, and
WHEREAS, in order to carry out the development plan for this project it is necessary for the City of Detroit to vacate certain streets and alleys in the area; therefore be it
RESOLVED, That all that part of the north-south public alley, 20 feet wide, in the block bounded by Lawton, Humboldt, Butternut, and Ash abutting lots 32 to 44 as platted in J. W. Johnston's Subdivision of east part of Private Claim 729, north of Chicago Road, as recorded in Liber 1, Page 188, Plats, Wayne County records, and abutting lots 30 to 39, as platted in Bradish and Hubbard's Subdivision of part of the Loranger Farm being section of Private Claim 474 and the westerly 1/9 of Private Claim 338, north of Michigan, Detroit, Michigan, as recorded in Liber 1, Page 133, Plats, Wayne County records; also
All that part of the north-south public alley, 20 feet wide, in the block bounded by Lawton, Humboldt, Ash, and Myrtle, being a part of the following subdivisions:
Bradish and Hubbard's Subdivision of part of Loranger Farm being section of Private Claim 474 and the westerly 1/9 of Private Claim 338 north of Michigan Avenue, Detroit, Michigan, Liber 1, Page 133.
J. W. Johnston's Subdivision of east part of Private Claim 729 north of Chicago Road, Liber 1, Page 188.
Johnston's Subdivision of Private Claim No. 727 and 729 being the central part of Private Claim 729, north of the Chicago Road, Lots 1, 2, 3, and 4 of the subdivision of the rear concession of Private Claim 729 and lots 1, 2, 3, and 4 of the subdivision of the rear concession of Private Claim 727, Liber 1, Page 139.
Otto Petzke's Subdivision of Lots 45 and 46 of Johnston's Subdivision of the east part of Private Claim 729, north of Chicago Road, Liber 9, Page 30.
and as shown on Department of Public Works drawing No. X-2491 dated September 23, 1971;
Be and the same are hereby vacated as public alleys to become a part and parcel of the abutting property, subject to the following:
FIRST, said owners hereby grant to and for the use of the Detroit Public Lighting Commission an easement or right-of-way over the northerly 40 feet of the said vacated alley in the block bounded by Lawton, Humboldt, Ash, and Myrtle hereinabove described for the purpose of maintaining, installing, repairing, removing, or replacing utilities such as electric light conduits or poles or things usually placed or installed in a public alley in the City of Detroit, with the right to ingress and egress at any time to and over said easement for the purpose above set forth.
SECOND, said owners for their heirs and assigns further agree that no

buildings or structures of any nature whatsoever including but not limited to concrete slabs or driveways, retaining or partition walls (except necessary line fence) shall be built or placed upon said easement, nor any change of surface grade made, without prior approval by the Detroit Public Lighting Commission,
THIRD, that if at any time in the future the owners of any lots abutting on said vacated alley shall request the removal and/or relocation of any existing poles or other utilities in said easement, such owners, upon whose property the poles or other utilities are located shall pay all costs incidental to such removal and/or relocation, unless such charges are waived by the utility owners.
PROVIDED FURTHER, that if any utility located or to be located in said property shall break or be damaged as a result of any action on the part of the petitioner or assigns (by way of illustration but not limitation), such as storage of excessive weights of materials or construction not in accordance with Section 2, mentioned above, then in such event the petitioner or assigns shall be liable for all costs incidental to the repair of such broken or damaged utility, and further
RESOLVED, that upon proper application, the Department of Public Works shall issue to the Detroit Edison Company and the Michigan Bell Telephone Company permits to relocate their pipes, poles and lines from the vacated alleys to public streets most conveniently located in reference to the vacated alleys and consistent with the public health, safety, convenience, and general welfare; and be it further
RESOLVED, that the Detroit Edison Company and the Michigan Bell Telephone Company are hereby directed to remove all their pipes, poles and lines from the vacated alleys without expense to the City within thirty days of receipt of a copy of this resolution; and be it further
RESOLVED, that all that part of Humboldt Street, 60 feet wide, between the south line of Butternut Street, 50 feet wide, and the south line of Myrtle Street, 50 feet wide, having been platted in the following subdivision:
Bradish and Hubbard's Subdivision of part of Loranger Farm being section of Private Claim 474 and the westerly 1/9 of Private Claim 338, north of Michigan Avenue, Detroit, Michigan, Liber 1, Page 133.
and as shown on Department of Public Works drawing No. X-2491, dated September 23, 1971; also
All that part of Butternut Street, 50 feet wide, lying easterly of the westerly line of the north-south alley, 20 feet wide, easterly of Lawton Avenue, and lying westerly of the westerly line of the north-south alley, 20 feet wide, westerly of Eighteenth Street; said Butternut Street having been platted as part of the following subdivisions:

J. W. Johnston's Subdivision of east part of Private Claim 729 north of Chicago Road, Liber 1, Page 188.
Bradish and Hubbard's Subdivision of part of Loranger Farm being section of Private Claim 474 and the westerly 1/9 of Private Claim 338, north of Michigan Avenue, Detroit, Michigan, Liber 1, Page 133.
and as shown on Department of Public Works drawing No. X-2491, dated September 23, 1971; also
All that part of Ash Street, 50 feet wide, between Lawton Avenue and the westerly line of the north-south alley, 20 feet wide, westerly of Eighteenth Street, said Ash Street having been platted as part of the following subdivisions:
Bradish and Hubbard's Subdivision of part of Loranger Farm being section of Private Claim 474 and the westerly 1/9 of Private Claim 338, north of Michigan Avenue, Detroit, Michigan, Liber 1, Page 133.
J. W. Johnston's Subdivision of east part of Private Claim 729, north of Chicago Road, Liber 1, Page 188.
Otto Petzke's Subdivision of Lots 45 and 46 of Johnston's Subdivision of the east part of Private Claim 729, north of Chicago Road, Liber 9, Page 30.
and as shown on Department of Public Works drawing No. X-2491, dated September 23, 1971,
Be and the same are hereby vacated as public streets and are hereby converted into public easements for subsurface utilities of the full width of the streets, which easements shall be subject to the following covenants and agreements, uses, reservations and regulations, which shall be observed by the owners of the lots abutting on said streets and by their heirs, executors, administrators and assigns forever to wit:
FIRST, said owners hereby grant to and for the use of the public easements or rights-of-way in said vacated public streets hereinabove described for the purposes of maintaining, installing, repairing, removing, or replacing subsurface public utilities such as water mains, sewers, gas lines or mains, telephone, electric light conduits or things usually placed or installed under public streets in the City of Detroit, with the right to ingress and egress at any time to and over said easements for the purpose set forth.
SECOND, said owners for their heirs and assigns further agree that no buildings or structures of any nature whatsoever including but not limited to concrete slabs or driveways, retaining or partition walls (except necessary line fence) shall be built or placed upon said easement, nor any change of surface grade made, without prior approval by the Department of Public Works.
THIRD, that if at any time in the future the owners of any lots abutting on said vacated streets shall request the removal and/or relocation

of any existing utilities in said easement, such owners, upon whose property the utilities are located shall pay all costs incidental to such removal and/or relocation, unless such charges are waived by the utility owners.
PROVIDED FURTHER, that if any utility located or to be located in said property shall break or be damaged as a result of any action on the part of the petitioner or assigns (by way of illustration but not limitation), such as storage of excessive weights of materials or construction not in accordance with Section 2, mentioned above, then in such event the petitioner or assigns shall be liable for all costs incidental to the repair of such broken or damaged utility, and be it further
RESOLVED, that the Detroit Edison Company and the Michigan Bell Telephone Company are hereby directed to remove all their overhead lines and poles from the vacated streets without expense to the City within thirty (30) days after receipt of a copy of this resolution; and be it further
RESOLVED, That the four fire hydrants of the Detroit Fire Department, located in Humboldt Avenue may remain in place until such time as relocation is necessary. When such relocation is necessary, the entire cost of said relocation shall be borne by the petitioner, his assigns, executors, or administrators, and be it further
RESOLVED, That the City Clerk is hereby directed to mail to the Detroit Edison Company, the Michigan Bell Telephone Company, and the Michigan Consolidated Gas Company a certified copy of this resolution.
Adopted as follows:
Yeas — Councilmen Browne, Eberhard, Hood, Levin, Rogell, Van Antwerp, Wierzbicki, and President Ravitz — 8.
Nays — None.

Wayne
10/67
11443

STATE OF MICHIGAN)
CITY OF DETROIT) ss.

SHORT FORM--TRUE COPY CERTIFICATE

I, GEORGE C. EDWARDS, CITY CLERK of the City of Detroit, do hereby certify that the annexed paper is a True Copy of a Resolution

MAY 16 1972

adopted by the Common Council on

MAY 23 1972

And approved by the Mayor on

as appears from the Journal of said Common Council, on file in my office.

IN WITNESS WHEREOF, I have hereunto set my hand and affixed the Corporate Seal of said City, at Detroit, on

JUN 6 1972
George C. Edwards
City Clerk

Map attached
Li: 18086
Pa: 435
Rec: 6-6-72

FORWARD TO STATE TREASURER

PETITION NO. 2491
DETROIT HOUSING COMMISSION
% H.R. VARNER
PHONE: 963-0955

APPROVED MAY 16, 1972

10167
11443


PLAT OF WEITZEL'S RE-SUB'N.
LOTS FROM 26 TO 36 INCL. LOTS FROM
38 TO 45 INCL. LOTS FROM 49 TO 57 INCL.
ALL LYING BETWEEN BUTTERNUT AND
MAGNOLIA STS. AND W. OF 18TH ST.
CITY OF DETROIT L.5 P.18

BRANDISH AND HUBBARD'S SUB'N OF
PART OF LORANGER FARM BEING SEC'N.
OF PC. 474 AND THE W'LY. 1/9 OF PC.
338 N. OF MICHIGAN AVE. DETROIT, MICH.
L.1 P.133

J.W. JOHNSTON'S SUB'N. OF E. PART OF
PC. 729 N. OF CHICAGO RD. L.1 P.188

JOHNSTON'S SUB'N. OF PC. NO. 727 & 729
BEING THE CENTRAL PART OF PC. 729
N. OF THE CHICAGO RD. LOTS 1,2,3 & 4
OF THE SUB'N. OF THE REAR CONCESSION
OF PC. 729 AND LOTS 1,2,3 & 4 OF THE
SUB'N. OF THE REAR CONCESSION OF
PC. 727 L.1 P.139

OTTO PETZKE'S SUB'N. OF LOTS 45 & 46
OF JOHNSTON'S SUB'N. OF THE E. PART
OF PC. 729 N. OF CHICAGO RD.
L.9 P.30

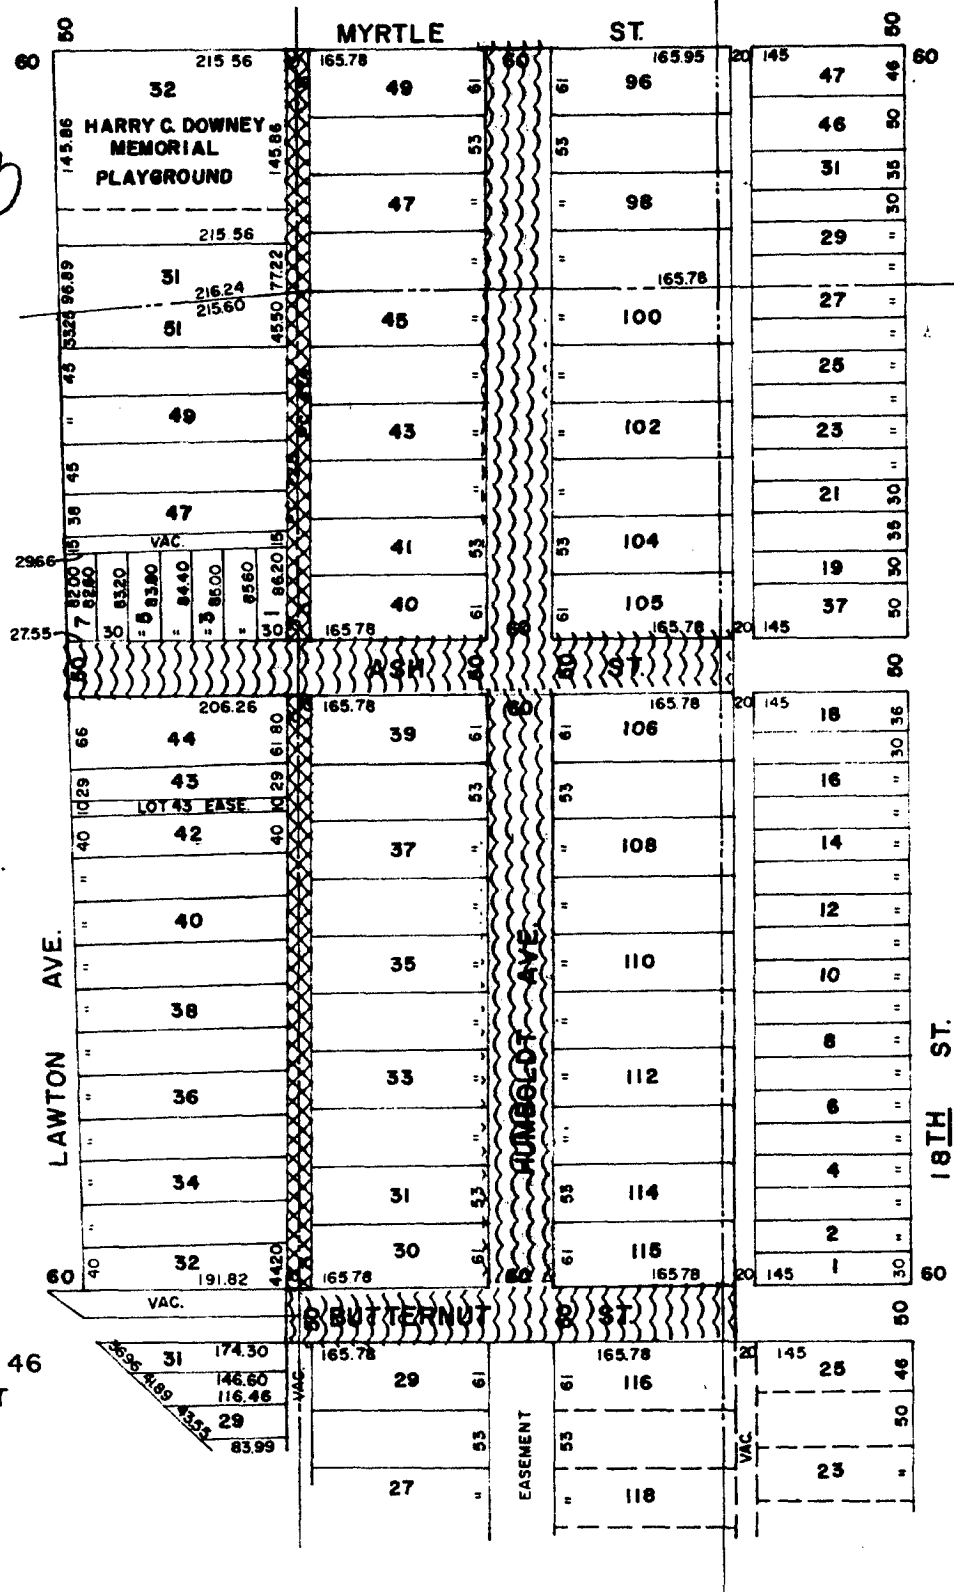

VACATION



VACATION SUBJECT TO UNDERGROUND EASEMENT

FOR OFFICE USE ONLY

TOPO NO. 19-B
SCALE: 1" = 200'

B				
A				
DESCRIPTION		Drawn	Chkd	Appd
REVISIONS				
DRAWN BY	APPROVED			
A. MORRIS				
TRACED BY	APPROVED			
CHECKED	APPROVED			
CITY ENGINEER				

REQUESTED VACATION OF THE N./S. ALLEYS
BETWEEN LAWTON AND HUMBOLDT AVENUES,
S. OF MYRTLE ST. AND N. OF BUTTERNUT ST.
REQUESTED VACATION SUBJECT TO
UNDERGROUND EASEMENT OF HUMBOLDT AVE.
BETWEEN MYRTLE AND BUTTERNUT STREETS,
ASH ST. BETWEEN LAWTON AVE. AND ALLEY E.
OF HUMBOLDT AVE, BUTTERNUT ST. BETWEEN
ALLEY E. OF LAWTON AVE. AND ALLEY E. OF
HUMBOLDT AVE.

CITY OF DETROIT
Dept. of Public Works
City Engineers Office

Job No. 1(1)

Drwg. No. X - 2491

Date SEPT. 23, 1971