


MAP
OF THE VILLAGE
OF LAMONT,
On the "Steel Farm" formerly Steels Landings
Steel Property
located in the W 1/4 NE 1/4 Section 7
T 7 N R 35 W + in SE 1/4 of NE 1/4 of Sec 20

State of Michigan, ss. I, the Clerk of the Court, do hereby certify that the within and foregoing plat of the village of Lamont, Michigan, and that the same was duly recorded and acknowledged before me and the said Clerk of the Court, on the 1st day of June 1911, at the County of St. Joseph, Michigan, and that the same is a true and correct copy of the original plat of the village of Lamont, Michigan, as the same appears from the records of the County of St. Joseph, Michigan, and that the same is a true and correct copy of the original plat of the village of Lamont, Michigan, as the same appears from the records of the County of St. Joseph, Michigan.

It is thus bearing part of the plat in line 34 of line page 616.

Notice
Lots, streets and parcels marked "v" are vacated by order of Circuit Court Feb. 5th 1880 See Voucher No 341-1914 The above plat recorded as Steel Farm Addition L.P. 51 see file 71-27

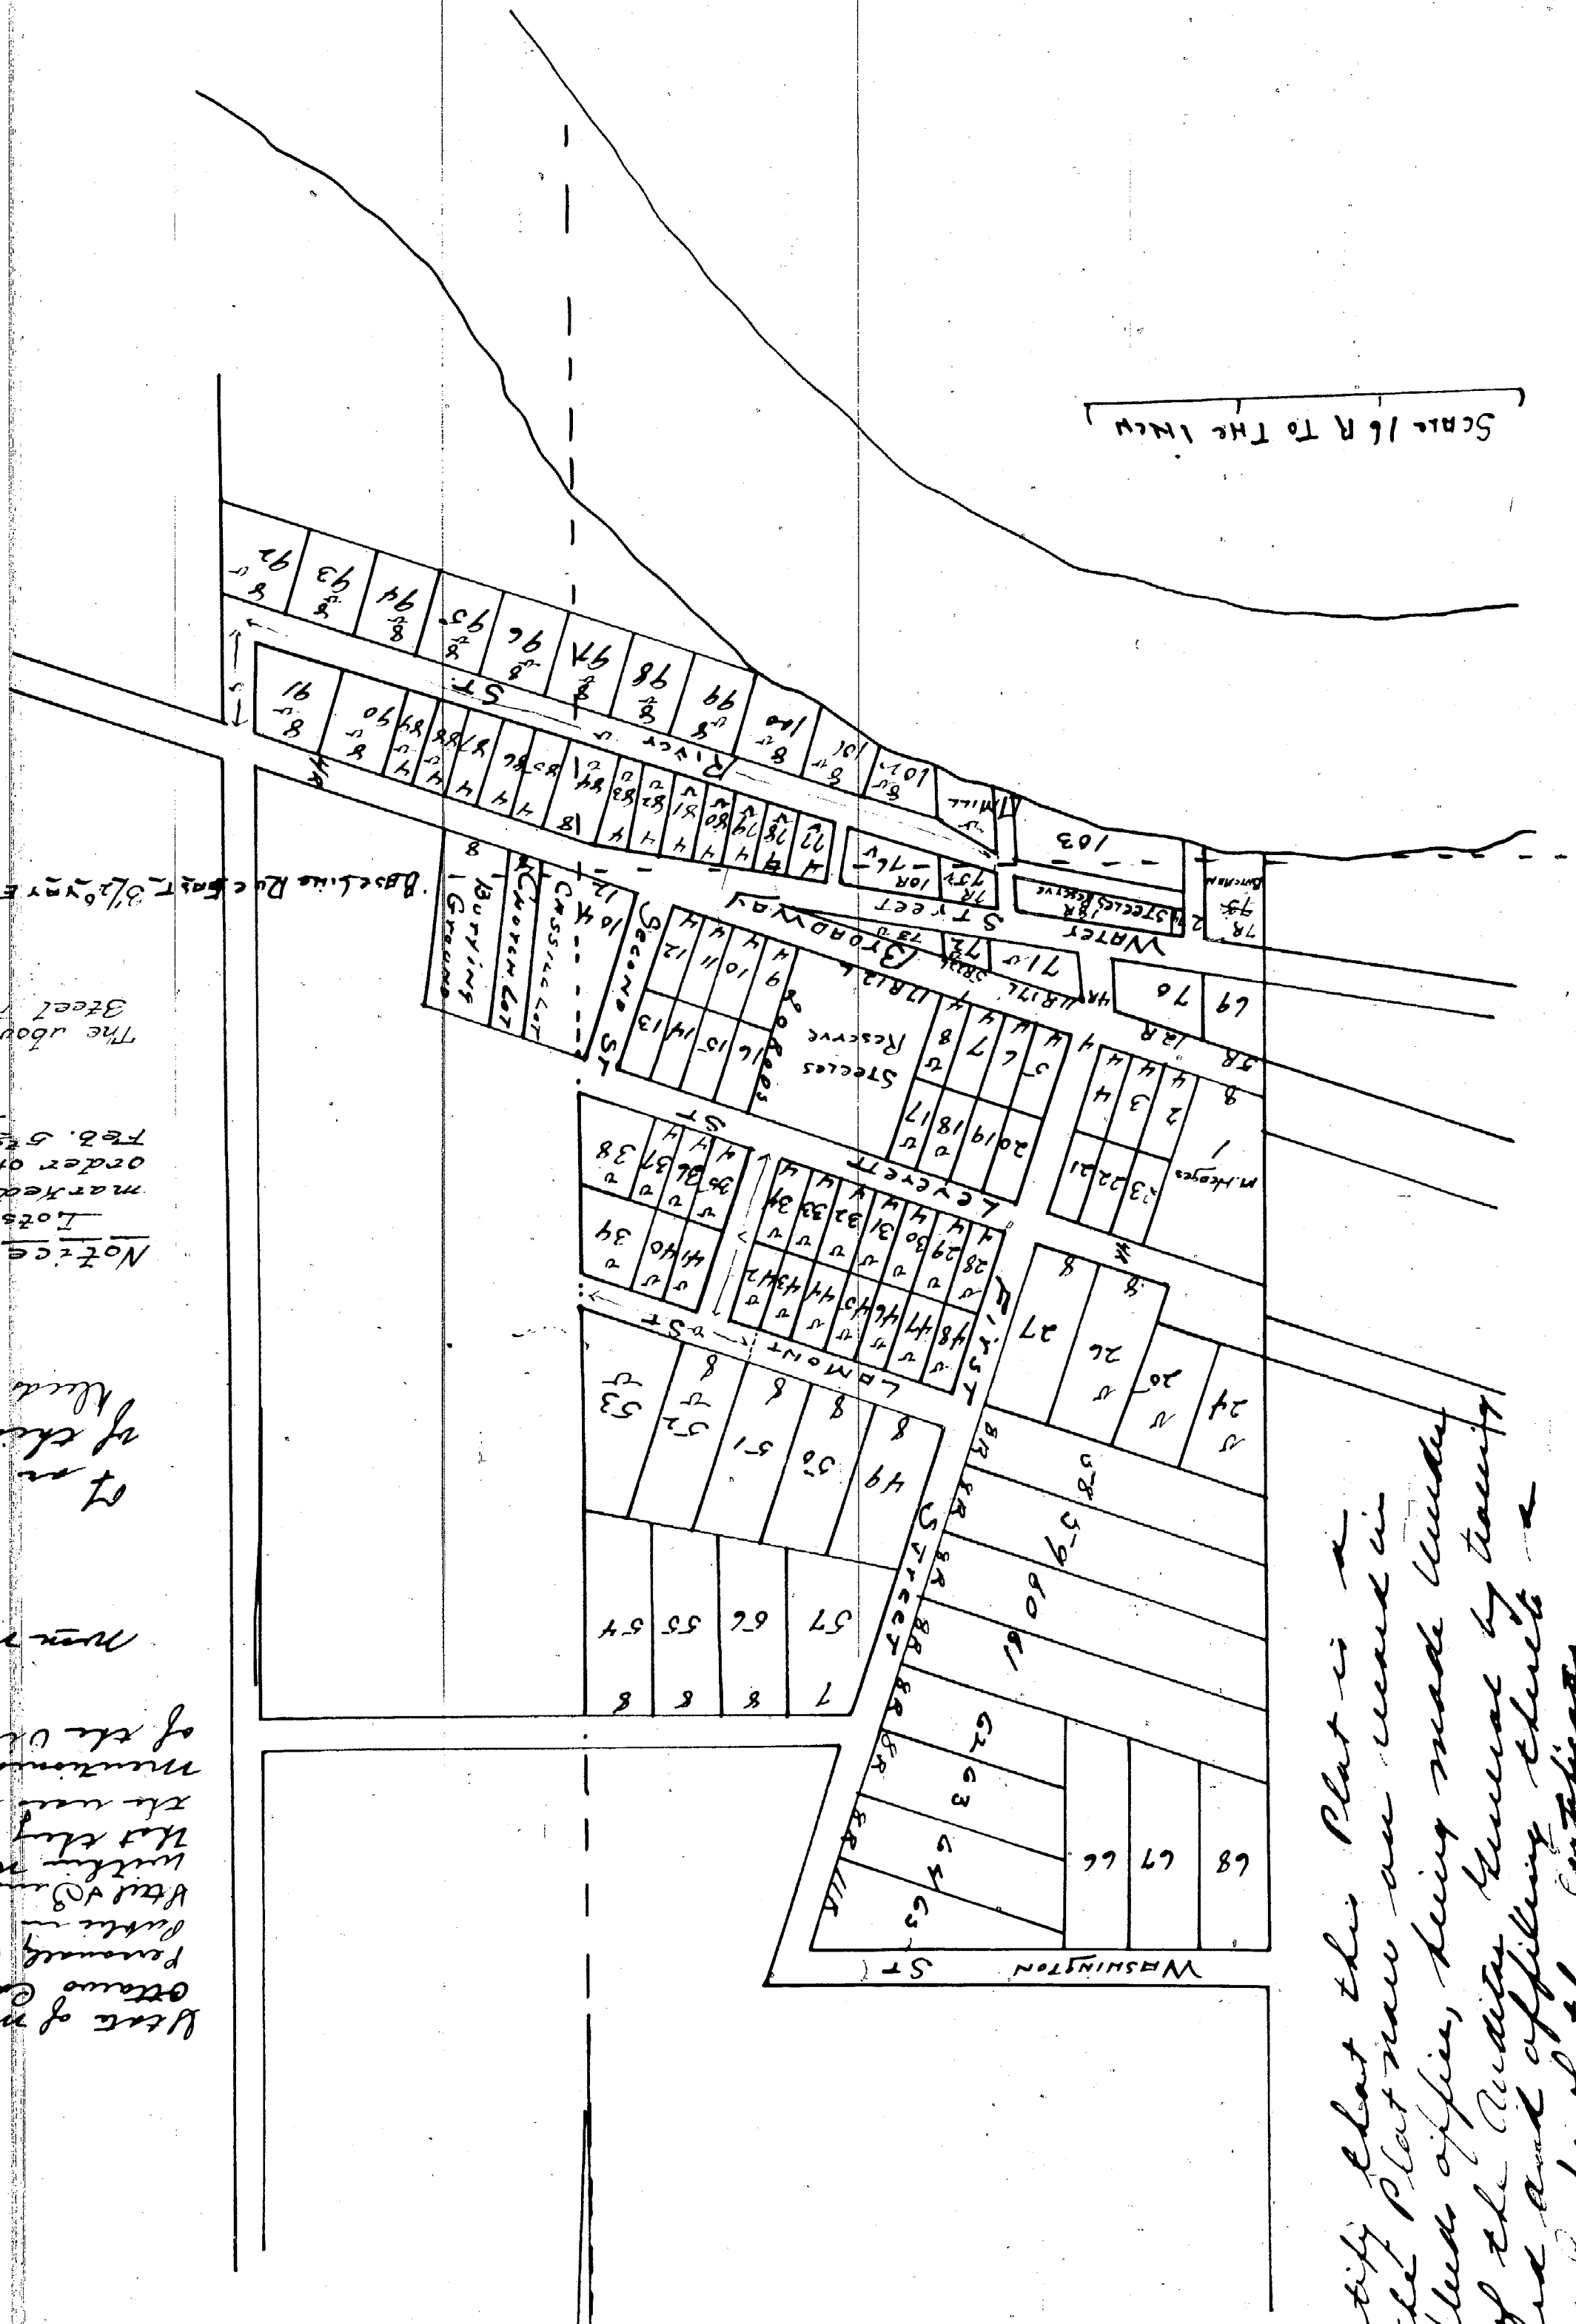

I hereby certify that the Plat is a correct copy of the Plat now on record in the Register of Deeds office, being made under the supervision of the Auditor General by the Plat are rec'd and affixed thereto a copy of the same.

Witness this 1st day of June 1911
J. C. Warner
Clerk, and Gen. Supt.

PLAT --- SLANDERS ADDITION TO THE CITY OF SEWLAND.

C O November 27, 1908.

All Vacated.

Recorded November 30, 1908.
Liber 127. Page 148.

Vol. 78. Page 5188. ✓

PLAT --- SWANSON PARK, STREETS VACATED.

C O November 8, 1908.

That Dewey Avenue from North Shore
Drive to the Waters of Macatawa Bay,
Hawwood Avenue from Dewey Avenue to
North Shore Drive and from the South
line of Lot 15 to Dewey Avenue and
the two Parks are hereby vacated.

Received November 9, 1908.
Liber 117. Page 480.

Vol. 78. Page 5189. ✓

Curtis & Taylor
Plat Examiners

PLAT --- STEEL FARM ADDITION TO LAMONT, PART VACATED.

Feb. 8, 1900.

All Lots, Streets and Parcels marked
V are vacated by order.

C O Journal E. Page 384.

Voucher 341 ----- 1914.

Vol. 138. Page 10333. ✓

PLAT --- VILLAGE OF HENTON, STREET VACATED.

That part of Third Street lying east-
erly from Pine Street in said Village
and ending in the waters of Spring
Lake is vacated.


C O March 23, 1910.

Voucher 848 ----- 1914.

Recorded March 23, 1910.
Liber 127. Page 488.

Vol. 138. Page 10338. ✓

Curtis & Taylor
Plat Examiners

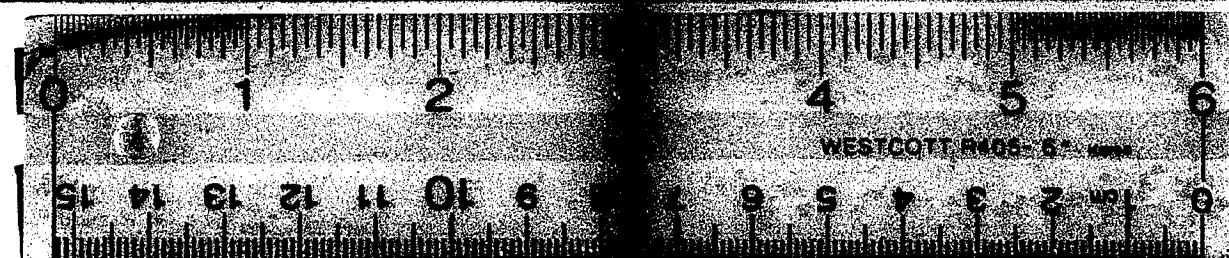

16 X