

CITY OF DETROIT

— "BETWEEN CATHARINE & LARNED STS."

— "CHENE FARM," —

OF THE

- SUBDIVISION

ST 26° 0' N	60 FT WIDE	ST 30° 0' N	60 FT WIDE	ST 33° 0' N	60 FT WIDE	ST 36° 0' N	60 FT WIDE	ST 39° 0' N	60 FT WIDE	ST 42° 0' N	60 FT WIDE	ST 45° 0' N	60 FT WIDE	ST 48° 0' N	60 FT WIDE	ST 51° 0' N	60 FT WIDE	ST 54° 0' N	60 FT WIDE	ST 57° 0' N	60 FT WIDE	ST 60° 0' N	60 FT WIDE
CATHARINE ST 50 FT WIDE N 60° E	10	11	12	13	14	15	16	17	18	19	20	21	22	23	24	25	26	27	28	29	30	31	32
MULLETT ST 50 FT WIDE N 60° E	10	11	12	13	14	15	16	17	18	19	20	21	22	23	24	25	26	27	28	29	30	31	32
CLINTON AVE 80 FT WIDE N 60° E	10	11	12	13	14	15	16	17	18	19	20	21	22	23	24	25	26	27	28	29	30	31	32
MACOMB ST 50 FT WIDE N 60° E	10	11	12	13	14	15	16	17	18	19	20	21	22	23	24	25	26	27	28	29	30	31	32
ROGHAN ST 50 FT WIDE N 60° E	10	11	12	13	14	15	16	17	18	19	20	21	22	23	24	25	26	27	28	29	30	31	32
LAFAETTE ST 50 FT WIDE N 60° E	10	11	12	13	14	15	16	17	18	19	20	21	22	23	24	25	26	27	28	29	30	31	32
PORT ST 50 FT WIDE N 60° E	10	11	12	13	14	15	16	17	18	19	20	21	22	23	24	25	26	27	28	29	30	31	32
CONGRESS ST 60 FT WIDE N 60° E	10	11	12	13	14	15	16	17	18	19	20	21	22	23	24	25	26	27	28	29	30	31	32
LEARNED ST 60 FT WIDE N 60° E	10	11	12	13	14	15	16	17	18	19	20	21	22	23	24	25	26	27	28	29	30	31	32

This is to certify that the above plat has been compared with the original plat of record in the office of Register of Deeds of Wayne County, and found to be a true copy of the same

A. H. Williams

Surveyor

A. H. Willmott

Σταυρός

Sept 1-57

We hereby consent to a
in the City of Detroit-

We hereby consent to and approve the within plat of part of the above named

Wayne County

The Audubon
Notary

Board of Commissioners
upon the plan of the
City of Detroit.

W. P. Baldwin

State of Michigan } ss On the second day of October A.D. 1857 before me
a Notary Public in and for said County Personally appeared the above named
Gustaf Olson and Marianne Olson known to be the per-
sons mentioned in and who executed the foregoing instrument and act.
I recognized the same respectively to be their free act and deed. And the
said Marianne wife of the said Gustaf upon a private examination by
me had and held separate and apart from her said husband advised
that she executed the foregoing instrument fully and without any
fear restraint or compulsion of her said husband or any one
in witness whereof I have said husband or any one
day of October A.D. 1857

Robert Lee Chew
Marion Chew

on printing of
Anthony Cant
the Auditors

Record day of October 1857

It is recommended that the Cabinet Office and Manpower should be kept within
 the proportion of the land described in the written and foregoing plot do
 having acknowledge the said plot as overgrown and dead and further do
 by their purchase grant 1/2 and dedicate to the public use forever the
 whole and all the said plot laid out and designated as such.
 The witness whereof we have hereunto set our hands and seals the
 18th day of March 1857.

James D. Roberts
Register of Trade

Received the 2nd October 1857 at 5-0'clock P.M.

map attached

By Councilman Kelley:

Whereas, the City of Detroit is undertaking the rehabilitation of the area known as Elmwood Park Project No. 3 pursuant to Act 344 of the Public Acts of 1945, as amended, and

Whereas, in order to carry out the development plan for this project it is necessary to vacate certain streets and alleys and to dedicate the land necessary for the street turnaround in Macomb Street; therefore be it

Resolved, that all that part of Monroe Avenue, 50 feet wide, between and abutting the easterly line of Chene Street and the westerly line of Joseph Campau; also

All that part of the east-west alley, 20 feet wide, in the block bounded by Chene, Joseph Campau, Lafayette, and Monroe Avenue; also

All that part of the north-south alley, 20 feet wide, in the block bounded by Chene, Joseph Campau, Lafayette, and Monroe Avenue; also

All that part of the east-west alley, 20 feet wide, in the block bounded by Chene, Joseph Campau, Monroe, and Macomb;

The above street and alleys appear in the following subdivisions:

1) Subdivision of part of Chene Farm between Catherine and Larned Streets as recorded in Liber 1, Page 29, Plats, Wayne County records;

2) G. W. Lee's Section of the Chene Farm being subdivision of lots 7, 8, 9, 10, 11, and 12, on the north and south sides of Congress, Fort, Lafayette, Croghan, and Macomb Streets (Croghan now Monroe) as recorded in Liber 1, Page 143, Plats, Wayne County records;

3) Theodore J. Campau's Subdivision of Block 22, Private Claim 609, as recorded in Liber 1, Page 213, Plats, Wayne County records;

4) Alexander T. Campau's Subdivision of Block 20, Private Claim 609, as recorded in Liber 1, Page 215, Plats, Wayne County records;

Be and the same are hereby vacated as a street and alleys to become a part and parcel of the abutting property subject to the following easement provisions:

An easement in the northerly 20 feet of the southerly 28 feet of the

above described Monroe Avenue, 50 feet wide, is hereby reserved for the use of the public a subsurface easement or right of way under said vacated public street hereinabove described for the purposes of maintaining, installing, repairing, removing, or replacing public utilities such as water mains, sewers, gas lines or mains, telephone, electric light conduits or things usually placed or installed in a public street in the City of Detroit, with the right to ingress and egress at any time to and over said easement for the purpose above set forth.

Said owners for their heirs and assigns further agree that no buildings or structures of any nature whatsoever including but not limited to concrete slabs or driveways, retaining or partition walls (except necessary line fence) shall be built or placed upon said easement nor any change of surface grade made, without prior approval by the Department of Public Works.

That if at any time in the future the owners of any lots abutting on said vacated street shall request the removal and/or relocation of any existing utilities in said easement, such owners, upon whose property the utilities are located shall pay all costs incidental to such removal and/or relocation, unless such charges are waived by the utility owners.

Provided Further, that if any utility located or to be located in said property shall break or be damaged as a result of any action on the part of the petitioner or assigns (by way of illustration but not limitation), such as storage of excessive weights of materials or construction not in accordance with Section 2, mentioned above, then in such event the petitioner or assigns shall be liable for all costs incidental to the repair of such broken or damaged utility, and be it further

Resolved, that upon proper application, the Department of Public Works shall issue to the Detroit Edison Company and the Michigan Bell Telephone Company permits to relocate their poles and lines from the areas vacated to public streets most conveniently located in reference to the vacated alleys and consistent with the public health, safety, convenience, and general welfare; and be it further

Resolved, That the Detroit Edison Company and the Michigan Bell Telephone Company are hereby directed to remove all their poles and lines from the vacated streets and alleys within thirty days after receipt of a copy of this resolution; and further

Resolved, That the Community Development Commission is hereby authorized and directed to pay the following estimated charges for

private utility removal or relocation:

Detroit Edison Company \$494.00
Michigan Bell Telephone Co.

\$9,270.00

and be it further

Resolved, That the following described land is hereby dedicated for street purposes for the construction of the turnaround in Macomb Street westerly of Joseph Campau:

Land in the City of Detroit, Wayne County, Michigan, being a part of lots 1 to 8 of Theodore J. Campau's Subdivision of Block No. 22, Private Claim No. 609, as recorded on June 23, 1868, in Liber 1 on Page 213, Plats, Wayne County records, more particularly described as: Beginning at a point in the southerly line of Macomb Street, 50 feet wide, said point being N. 59 deg. 51 min. 29 sec. E. 645.18 from the intersection of the easterly line of Chene Street, 120 feet wide and the southerly line of Macomb Street, 50 feet wide, thence 72.26 feet along the arc of a curve, concave to the south, which has a radius of 69.00 feet, a delta of 60 deg. 0 min. 0 sec. and a long chord of 69.00 feet which bears N. 89 deg. 51 min. 29 sec. E., to a point of reverse curve; thence 180.64 feet along the arc of a curve, concave to the west, which has a radius of 69.00 feet, a delta of 150 deg. 0 min. 0 sec. and a long chord of 133.30 feet which bears N. 44 deg. 51 min. 29 sec. E., to a point on the southerly line of Macomb Street; thence S. 59 deg. 51 min. 29 sec. W., to the point of beginning.

and be it further

Resolved, That the City Clerk is hereby directed to mail to the Detroit Edison Company and the Michigan Bell Telephone Company a certified copy of this resolution.

Adopted as follows:

Yeas — Councilmen Browne, Cleveland, Kelley, Mahaffey, and President Levin — 5.

Nays — None.

Wayne
10705
11380
10647
10626

Li 18729
Ca: 450
Rec: 2-19-74

STATE OF MICHIGAN)
CITY OF DETROIT) ss.

SHORT FORM - TRUE COPY CERTIFICATE

I, JAMES H. BRADLEY, CITY CLERK of the City of Detroit, do hereby certify that the annexed paper is a True Copy of a Resolution

adopted by the Common Council on February 5, 1974

and approved by the Mayor on February 12, 1974

as appears from the Journal of said Common Council, on file in my office.


IN WITNESS WHEREOF, I have hereunto set my hand and affixed the Corporate Seal of said City, at Detroit, on

February 15, 1974

James H Bradley
City Clerk

FORWARDED TO STATE
TREASURER

10705
11380
10647
10624

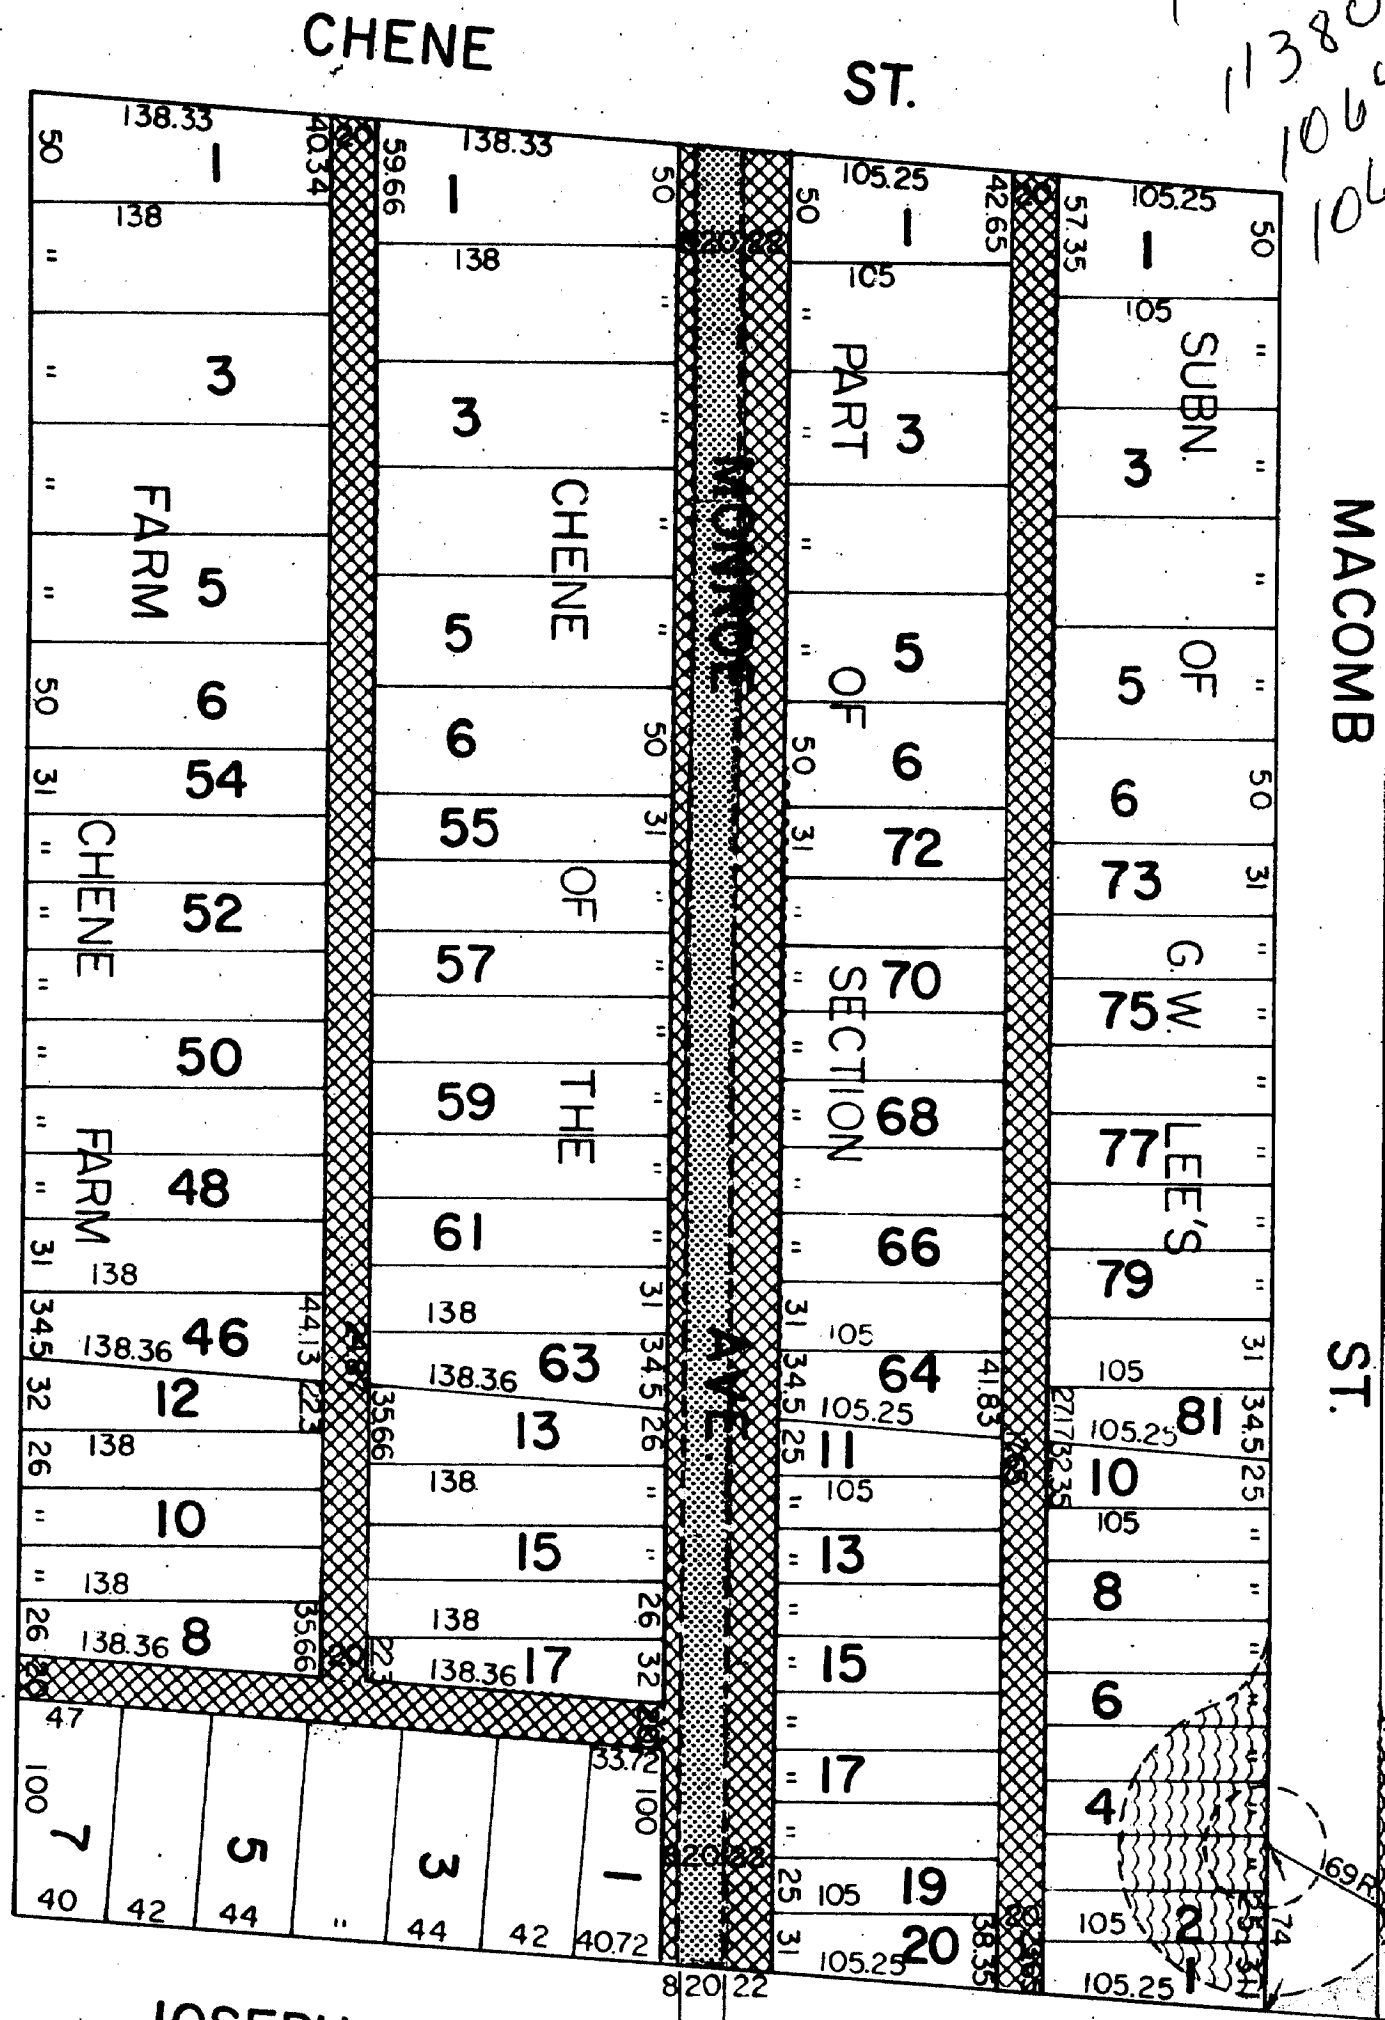

PETITION NO. 5985
COMMUNITY DEV. COMM.
350 E. CONGRESS
2-5-74 *apud*

JOSEPH CAMPAU AVE.
REQUESTED VACATION
REQUESTED DEDICATION
REQUESTED EASEMENT

DEPARTMENT OF PUBLIC WORKS CITY ENGINEER'S OFFICE SURVEY BUREAU	
Scale 1" = 100'	Drawing No. X-5985
Drawn By D.J.P.	Date 3-20-73