

MILLER'S SUBDN

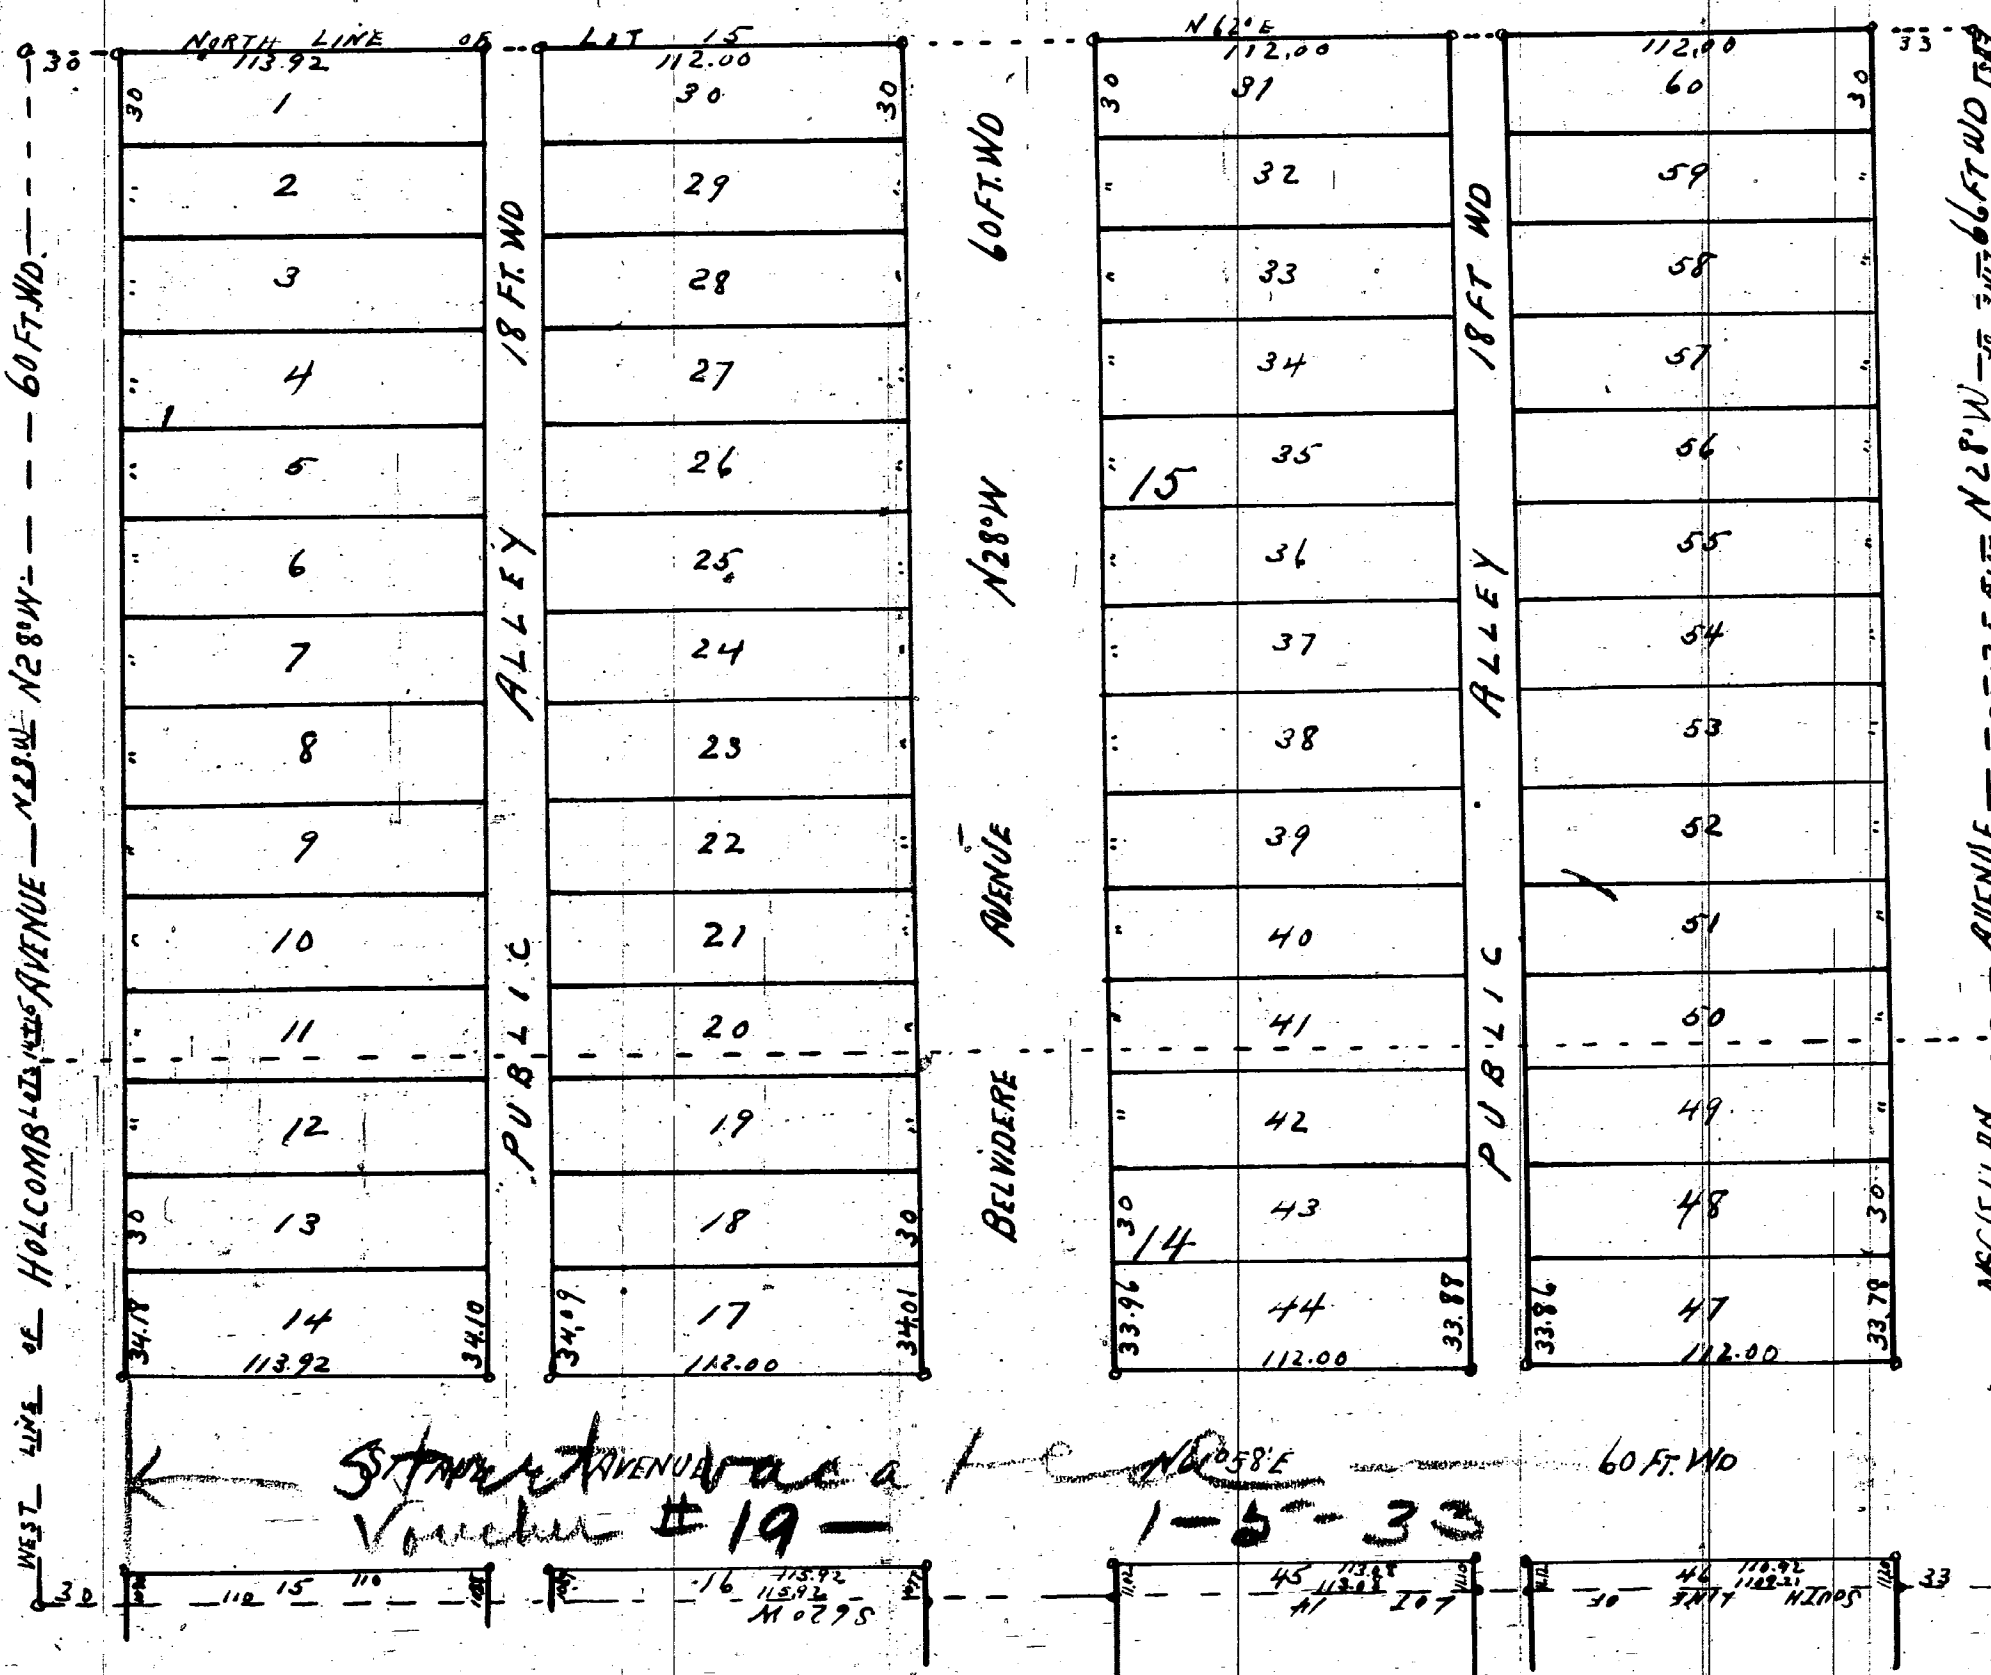
OF LOTS 14 AND 15 OF SUB OF ROBERT BEAUBIENEST P.C. 10

CITY OF DETROIT WAYNE CO.,

MICHIGAN

MARCH 1893

SCALE 60 FEET PER INCH

MASON L. BROWN
ENGINEER & SURVEYOR
DETROIT MICH

I hereby certify that the above plat is correct, and that Monuments consisting of Oak Stakes 1 1/4 inches square and 15 inches long have been placed in the ground at all angles in the boundaries and at the intersection of all streets or streets and alleys as shown on plat by O.

Detroit April 13th 1893

Mason L. Brown
Engineer and Surveyor

KNOW ALL MEN BY THESE PRESENTS that We August Miller and Annie Miller his wife

Have caused the land embraced in the above plat to be surveyed, laid out and plotted to be known as Miller's Sub of Lots 14 & 15 of Sub of Robert Beaubienest P.C. 10 City of Detroit Wayne Co Michigan and that the streets and alleys shown on said plat are hereby dedicated to the use of the public.

Witness our hands and seals this the 13 day of April A. D. Eighteen Hundred and Ninety three

In presence of August Miller [L.S.]
Annie Miller [L.S.]

Frank Higham

I hereby certify that this plat is a correct copy of the plat now on record in the Register of Deeds office being made under the supervision of the Auditor General by tracing the plat on record and affixing thereto a carefully compared copy of the dedication and certificates

Dated this 3rd day of March 1911

John B. La Fontaine
Clerk and Gen. Dep.

STATE OF MICHIGAN } ss
County of Wayne

On this the 13 day of April 1893 before a Notary Public in and for said county, personally appeared the above named August Miller and Annie Miller his wife

known to me to be the same persons who executed the above dedication and who acknowledged the same to be their free act and deed

Leo M. Whipple Notary Public
Wayne County Michigan

STATE OF MICHIGAN } ss
County of Wayne

We Elgin A. Heames Dep. Register of Deeds and Mason L. Brown Surveyor hereby certify that we have each carefully compared this copy with the original plat of Miller's Sub of Lots 14 & 15 of Sub of Robert Beaubienest P.C. 10 City of Detroit Wayne Co Mich. and that it is an exact copy thereof and of the whole of such original map or plat

Elgin A. Heames Dep. Register of Deeds
Mason L. Brown Surveyor

Examined and Approved
April 20-1893
D. B. Ainger
Deputy Auditor General.

REGISTER'S OFFICE } ss
County of Wayne
Received for Record The 26th day
of May A. D. 1893 at
3:00 o'clock P. M. and Re-
corded in Liber 18 of Chate
on Page 73
Elgin A. Heames
Dep. REGISTER

APPROVED May 26, 1893
John M. Uican
James Dean
Jacob. L. Leland

BOARD OF PUBLIC WORKS
CITY OF DETROIT
WAYNE CO MICHIGAN