

LAWRENCE SUB.


of Lot 8 and South 2.50 Acres of Lot 7 of Fr'l Sec 29 in
T.3.S.R.11.E

WAYNE CO. MICHIGAN

FEB 20 1893

Scale 100 Feet to an Inch

Mason L. Brown
Civil Engineer & Surveyor
24 to 27 Dodge Bldg
Detroit Mich.

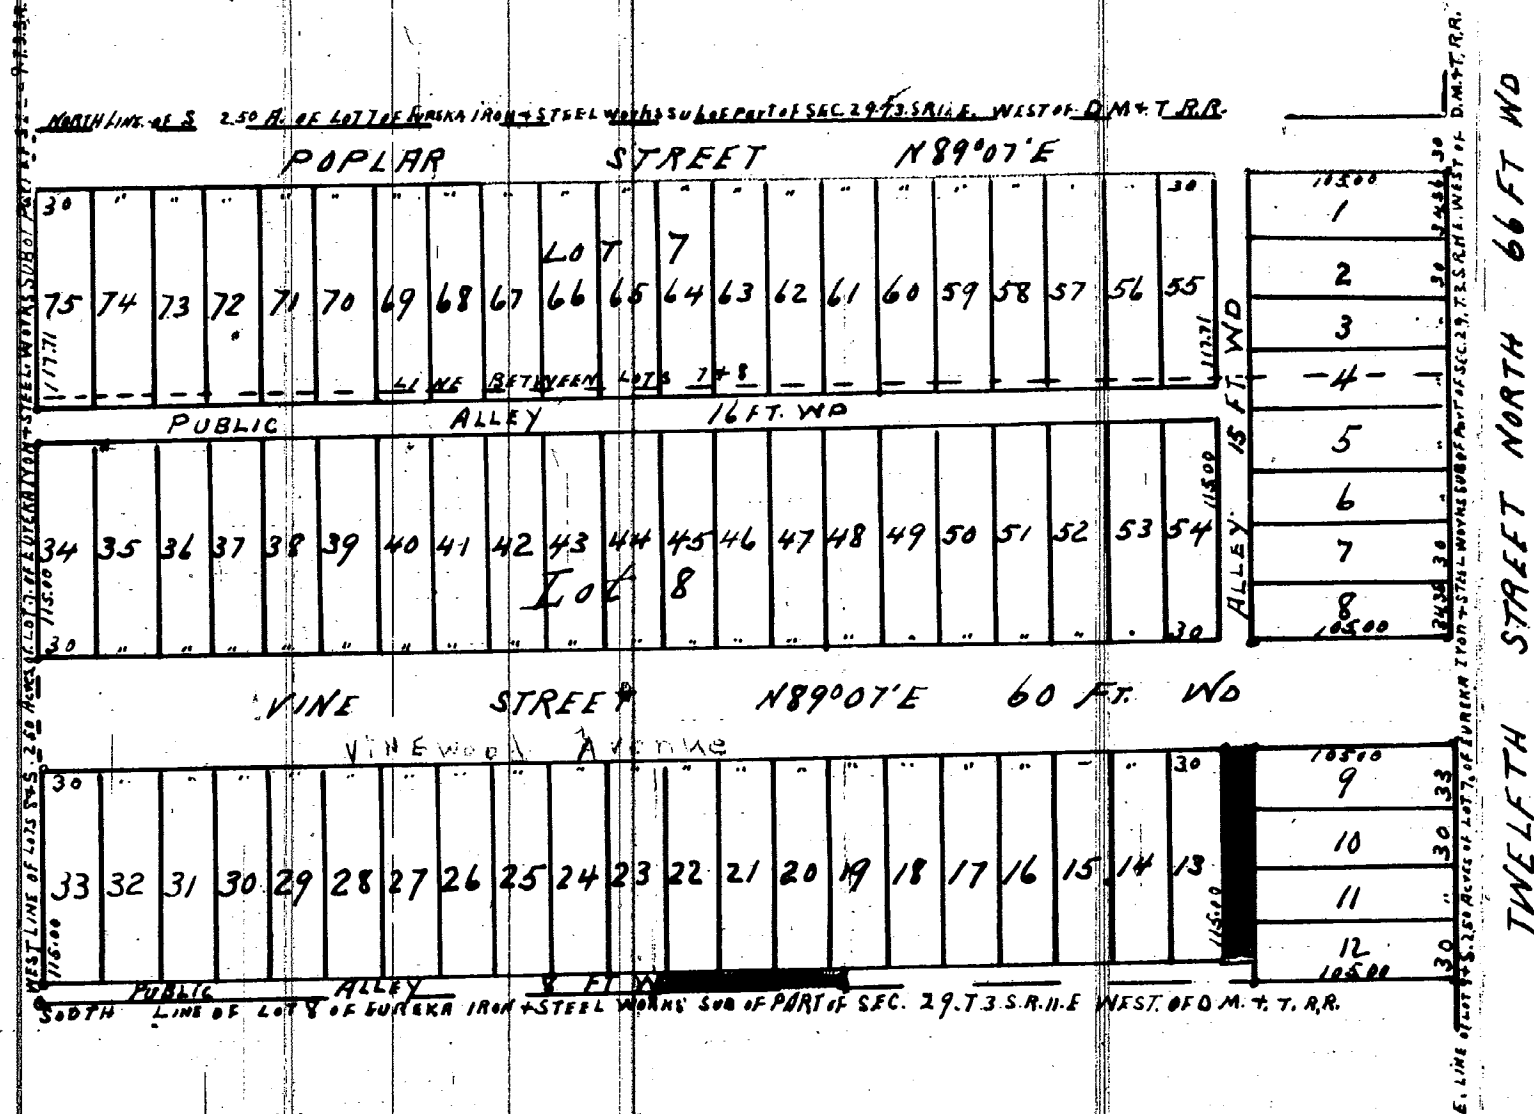

City Council
September 28, 1898
504-58

City Council
Jan. 26, 1956
504-56

I hereby certify that the above plat is correct, and that monuments consisting of Oak Stakes 1/4 inches square and 15 inches long have been placed in the ground at all angles in the boundaries and at the intersection of all streets or streets and alleys as shown on plat by

Detroit Feb 20 1893

Mason L. Brown
Engineer and Surveyor

STATE OF MICHIGAN }
County of Wayne }

On this the 21st day of February 1893 before me, a Notary Public in and for said county, personally appeared the above named Edwin Lawrence (unmarried), Alvin O. Van Wagoner (unmarried), known to me to be the same persons who executed the above dedication and who acknowledged the same to be their free act and deed

Charles M. Johnson Notary Public
Wayne County Michigan

KNOW ALL MEN BY THESE PRESENTS, that WE, Edwin Lawrence (unmarried), Alvin O. Van Wagoner (unmarried), have caused the land embraced in the above plat to be surveyed, laid out, and plotted to be known as Lawrence Sub of lot 8 and south 2.50 acres of lot 7 of fr'l sec. 29 in T.3.S.R.11.E, Wayne Co. Michigan and that the streets and alleys shown on said plat are hereby dedicated to the use of the public. Witness our hands and seals this the 21st day of February A. D. Eighteen Hundred and Ninety Three

In presence of Ed. Lawrence [L.S.]
Charles M. Johnson Alvin O. Van Wagoner [L.S.]
F. O. Ray.

STATE OF MICHIGAN }
County of Wayne }

We John A. Heames Register of Deeds and Mason L. Brown Surveyor hereby certify that we have each carefully compared this copy with the original plat of Lawrence Sub of lot 8 + South 2.50 Acres of lot 7 of Fr'l Sec. 29 in T.3.S.R.11.E, Ecorse Wayne Co. Michigan and that it is an exact copy thereof and of the whole of such original map or plat.

John A. Heames Register of Deeds
Mason L. Brown Surveyor

The Property hereon platted is described as follows
Lot Eight (8) and south 2.50 acres of Lot Seven (7)
of the Eureka Iron & Steel Works Sub of part of Fractional
Section Twenty nine (29) T.3.S.R.11.E

Examined and Approved
February 28-1893
H. R. Pratt
Deputy Auditor General

REGISTERS OFFICE }
County of Wayne }
Received for Record, the 8th day
of March A. D. 1893 at
3:00 o'clock P. M. and Re-
corded in Liber 18 of Plats
on Page 30
John A. Heames
REGISTER

I hereby certify that this plat is a correct copy of the plat now on record in the Register of Deeds office being made under the supervision of the Auditor General by tracing the plat on record and affixing thereto a carefully compared copy of the dedication and certificates

Dated this 11th day of Feb'y 1911
John B. La Fontaine
Clerk and Gen. Dept

RESOLUTION

Wyandotte, Michigan
March 7, 1966

RESOLUTION by Councilman Frank J. Zulewski

At a regular session of the City Council of the City of Wyandotte.

RESOLVED BY THE CITY COUNCIL OF THE CITY OF WYANDOTTE.

WHEREAS this Council by resolution has deemed it advisable and necessary for the health, welfare, comfort and safety of the people of the City of Wyandotte, to vacate, discontinue, and abolish the hereinafter described land in the City of Wyandotte, County of Wayne, State of Michigan, as a public alley, more particularly described as:

The ten (10) foot wide alley located east of 15th Street from Vinewood Avenue to the alley ^{South} ~~North~~ of Poplar Street, more particularly described as the alley abutting Lot 34, Lawrence Subdivision, of Lot 8 and South 2.50 acres of Lot 7 of Fractional Section 29 in Town 3 South, Range 11 East, Ecorse, Wayne County, Michigan, according to the plat thereof as recorded in Liber 18 of Plats, at page 20, said Wayne County Records; and Lots 81 to 83, both inclusive, and the south 25 feet of Lot 80, of Mizner's Subdivision of Lot 28 of the Subdivision of North half of Section 30, Town 3 South, Range 11 East, Ecorse, Wayne County, Michigan, according to the plat thereof as recorded in Liber 20, of Plats, at page 47, said Wayne County Records;

and

WHEREAS, due notice has been given of the hearing on objections to said vacation; and

WHEREAS, said hearing having taken place in accordance with such notice, and objections having been offered, and this Council still being of the opinion that said vacation is advisable; now, therefore,

BE IT RESOLVED that the above described alley shall be and the same is hereby declared VACATED, DISCONTINUED AND ABOLISHED as a public alley, reserving to the City of Wyandotte, a Municipal

Corporation of the State of Michigan, its successors and assigns forever and in perpetuity from the date hereof, an easement on, over, under, across, and within the 10-foot right-of-way of the above described alley for the purpose of constructing, operating, maintaining and repairing existing and future public utilities, sewers and drains, and that said City of Wyandotte, its contractors, employees, agents, successors, assigns and lessees shall at all times have free ingress to and egress from said alley to construct, operate, maintain and repair said existing and future utility lines of every nature, and said sewers and drains, and reserving to the Michigan Bell Telephone Company, its successors and assigns, an easement on, over, across and within said 10-foot alley right-of-way for the purpose of constructing, erecting, operating, maintaining, and repairing its existing and future system of telephone poles, lines, wires, cables and apparatus; and that said Michigan Bell Telephone Company, its contractors, employees, agents, successors and assigns shall at all times have free ingress to and egress from said 10-foot alley right-of-way for the purpose of constructing, erecting, operating, maintaining and repairing its existing and future system of telephone poles, lines, wires, cables and apparatus.

BE IT FURTHER RESOLVED that no structures shall be constructed or maintained on, over, under, across, or within the 10-foot wide right-of-way of the above-described alley, and that in the exercise of the easement and ingress and egress rights heretofore reserved herein, neither said City of Wyandotte nor said Michigan Bell Telephone Company shall be liable for any injury or damage to, or disturbance of, nor shall they or either of them have any duty to pay for or replace, any animate or inanimate improvement on, over, under, across, or within said 10-foot right-of-way.

I move the adoption of the foregoing resolution.

Councilman Frank J. Zulewski

Supported by Councilman Smith

YEAS	COUNCILMEN	NAYS
☒	Clack	☐
☒	Groat	☐
☒	Palamara	☐
☒	Smith	☐
☒	Sullivan	☐
☒	Zulewski	☐

ABSENT NONE

STATE OF MICHIGAN, } ss.
County of Wayne,
City of Wyandotte

I, STANLEY RATYNSKI, City Clerk of the City of Wyandotte, in said county and state, do hereby certify that the annexed is a true copy of a resolution adopted by the City Council of the said City of Wyandotte, on the 7th day of March A.D. 1966. That I have compared the same with the original resolution on file in my office, and that said copy is a full, true and correct transcript therefrom and of the whole of said resolution.

In Witness Whereof I have hereunto set my Hand and have caused the corporate seal of the City of Wyandotte to be hereunto affixed, this 15th day of March A.D. 1966
Stanley Ratynski
City Clerk.

CERTIFICATE

I, Stanley Ratynski, City Clerk of the City of Wyandotte, Michigan, do hereby certify that on March 7, 1966, the City Council of the City of Wyandotte, adopted a Resolution, a certified copy of which is attached hereto, vacating a public alley in the City of Wyandotte, County of Wayne, State of Michigan, said alley being more particularly described as:

The ten (10) foot wide alley located east of 15th Street from Vinewood Avenue to the alley ^{South} ~~North~~ of Poplar Street, more particularly described as the alley abutting Lot 34, Lawrence Subdivision, of Lot 8 and South 2.50 acres of Lot 7 of Fractional Section 29 in Town 3 South, Range 11 East, Ecorse, Wayne County, Michigan, according to the plat thereof as recorded in Liber 18 of Plats, at Page 20, said Wayne County Records; and Lots 81 to 83, both inclusive, and the south 25 feet of Lot 80, of Mizner's Subdivision of Lot 28 of the Subdivision of North half of Section 30, Town 3 South, Range 11 East, Ecorse, Wayne County, Michigan, according to the plat thereof as recorded in Liber 20, of Plats, at page 47, said Wayne County Records.

I do further certify that the name or names of any plat, subdivision or addition in said City affected by such Resolution are as follows:

Lawrence Subdivision, of Lot 8 and South 2.50 acres of Lot 7 of Fractional Section 29 in Town 3 South, Range 11 East, Ecorse, Wayne County, Michigan, according to the plat thereof as recorded in Liber 18 of Plats, at page 20, said Wayne County Records;

Mizner's Subdivision of Lot 28 of the Subdivision of North half of Section 30, Town 3 South, Range 11 East, Ecorse, Wayne County, Michigan, according to the plat thereof as recorded in Liber 20, of Plats, at page 47, said Wayne County Records.

Dated: March 10, 1966.

Stanley Ratynski
Stanley Ratynski
City Clerk

STATE OF MICHIGAN)
COUNTY OF WAYNE) ss

On this 10th day of March, 1966, before me,
a Notary Public in and for said County, personally came Stanley
Ratynski, known to me to be the person described in and who
executed the foregoing certificate, and being by me first duly
sworn, did depose and say that he is the duly elected City Clerk
of the City of Wyandotte, Michigan, and that the foregoing
certificate is true of his own knowledge, and he acknowledged that
he executed the same for the intents and purposes therein set
forth.

Lena Jozwiak
Notary Public, Wayne County, Michigan

My commission expires: April 7-1968

