


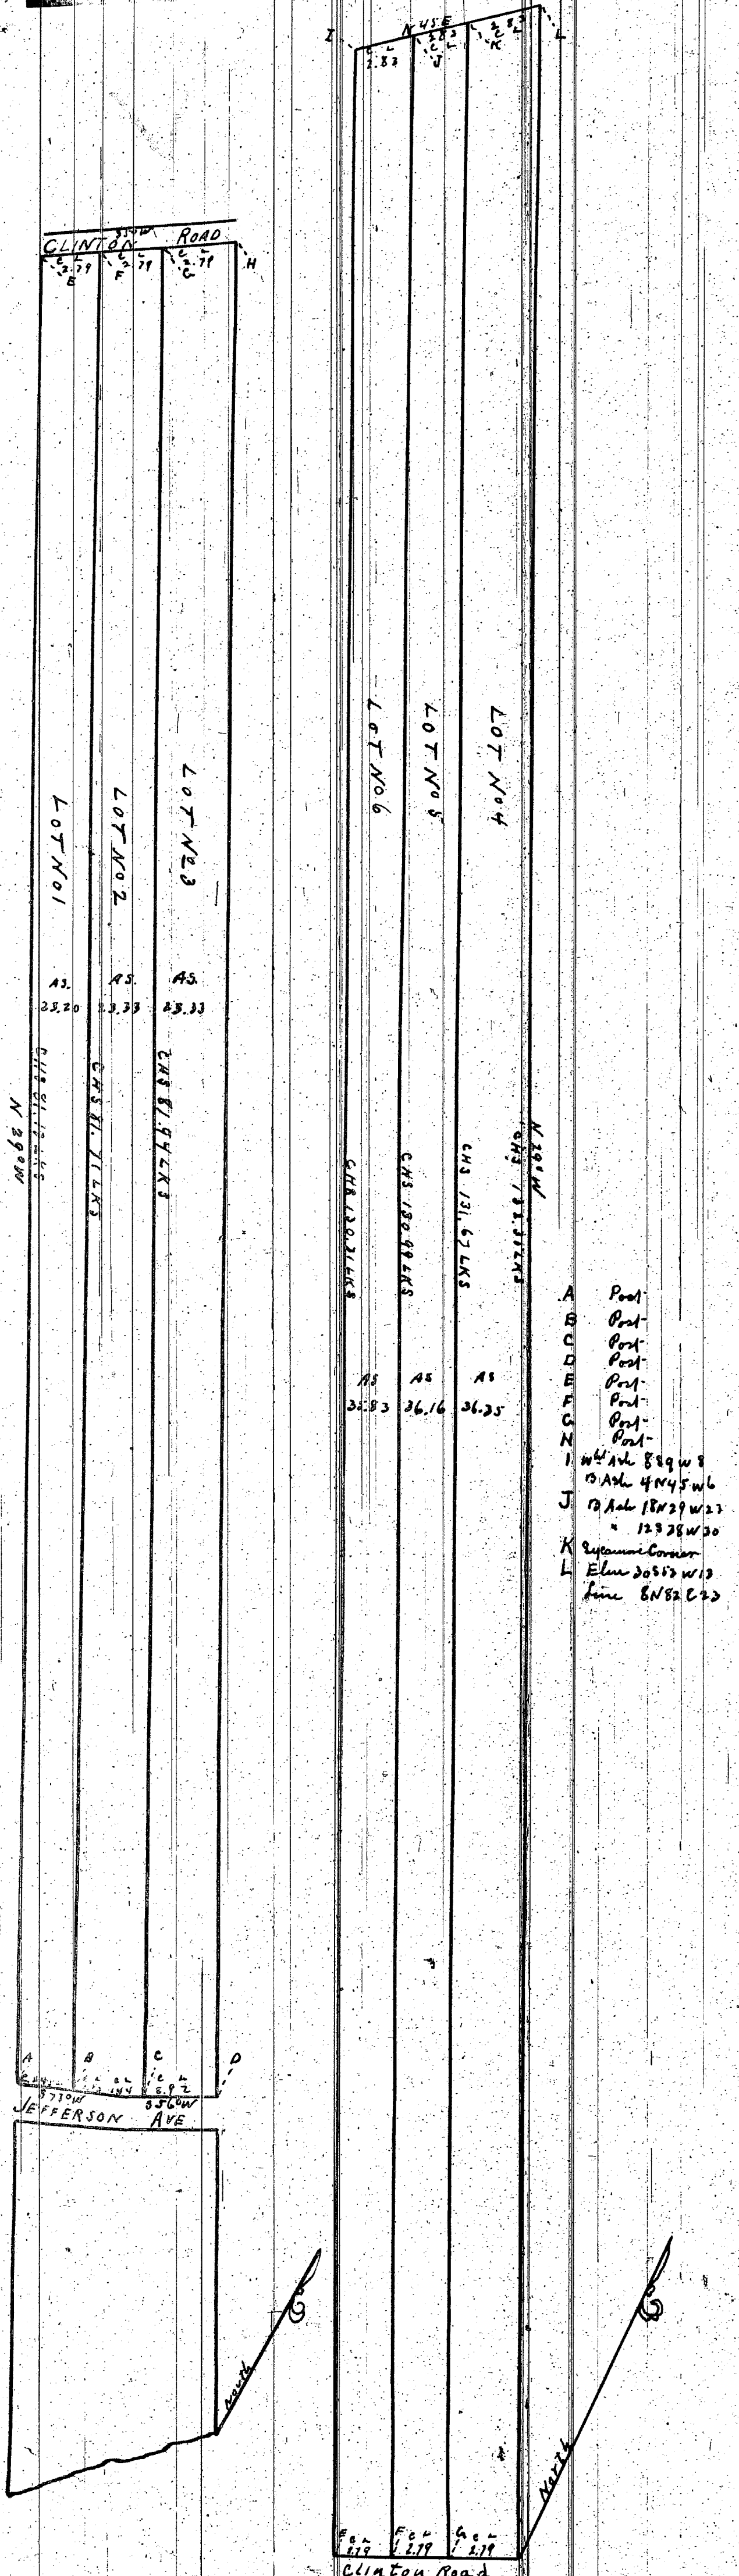


I hereby certify that this plat represents the subdivision of the front and rear concessions of Private Claim No. 585, as made by me from actual survey and calculation for the proprietor Adolphus Page, and is a correct representation of the subdivision of said claim into six lots, No. 1, 2, 3, 4, 5, 6, from Jefferson Ave to the Mack Road, and 4, 5, 6, from the Mack Road to the rear line of the additional donation so-called Detroit Marsh, 7th 1872.

Received for record March 11th 1872, at 11 o'clock A.M. along Eaton Register
 Know all men by these presents that I, Adolphus Page, of the Township of Grosse Pointe, Wayne Co. Michigan, do hereby dedicate to the public use the streets laid out on the within plat of the Subdivision of Front and Rear Concessions of Private Claim Number Five hundred and eighty-five (585) in said Township of Grosse Pointe and do by these presents adopt and approve of said subdivision as my free act and deed Dated March 7th 1872.
 In presence of
 Henry Campau
 Edwin Jerome, Jr.
 Adolphus Page

State of Michigan }
 County of Wayne } ss On this 7th day of March A.D. 1872 personally appeared before me a Notary Public in and for said County the above named Adolphus Page who acknowledged that he executed the above instrument for the purposes therein stated and as his free act and deed.
 Henry Campau
 Notary Public
 Wayne Co. Mich.

This is to certify that the above plat has been compared with the original plat of record in the office of Register of Deeds of Wayne County, and found to be a true copy of the same.
 A. H. Willmarth
 Surveyor

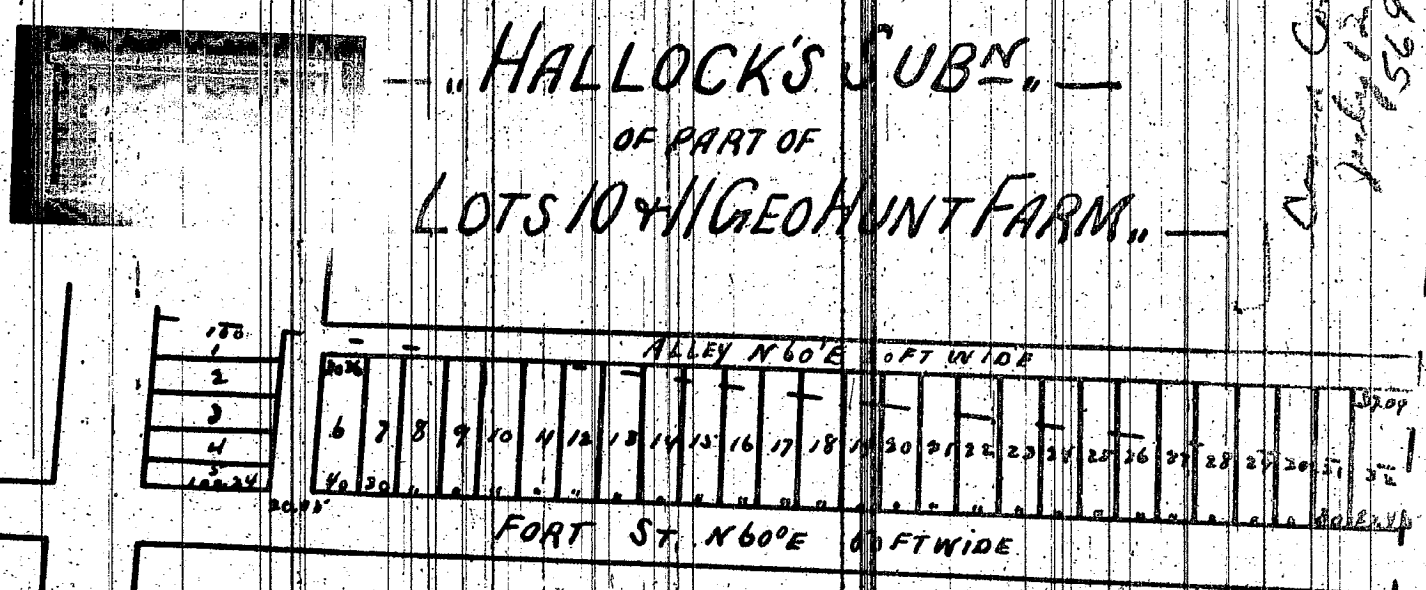

Approved Sept 2, 1872 J. M. Ford
 Emory Wardell
 Thos J. Campau
 Received for Record September 2nd 1872 at 11 1/4 o'clock A.M. along Eaton Register
 Eugene Robinson City Surveyor

I hereby certify the above map to be correct
 State of Michigan }
 County of Wayne } ss On this twenty-third day of June A.D. 1868 personally came before me a Notary Public in and for said County Eugene Robinson City Surveyor of the City of Detroit and acknowledged the within plat to be correct.
 John F. McWilliam
 Notary Public.

Know all men by these presents that I, Horace Hallock, of Detroit Wayne County Michigan do present for record the within plat of Hallock's Subdiv. of part of Lots 10 and 11, Hunt Farm City of Detroit Mich for the purpose of having the same recorded according to law, Whereas my land and seal this 3rd day of September 1872.
 In presence of
 Henry Campau
 Along Eaton
 Horace Hallock

State of Michigan }
 County of Wayne } ss On this 3rd day of September A.D. 1872, before me a Notary Public for said County Horace Hallock known to me to be the person who executed the above and acknowledged the same to be his free act and deed.
 Henry Campau
 Notary Public
 Wayne County, Mich.

This is to certify that the above plat has been compared with the original plat of record in the office of Register of Deeds of Wayne County, and found to be a true copy of the same.
 A. H. Willmarth
 Surveyor

I hereby certify that these plat are correct copies of the plat now on record in the Register of Deeds office, being made under the supervision of the Auditor General by tracing the plat on record and affixing thereto carefully compared copies of the dedications and certificates.
 Dated this 9th day of July 1910.
 Geo. W. Churchill
 Clerk Aud. Genl. Dept.

Surveyor
 July 12-55
 1569-55

mg attached
Li 17144
Pa. 174

Rec 9-18-69

Wayne
11521

By Councilman Hood:
Resolved, That all that part of Fort Street, 50 feet wide, between Elmwood and the east line of Ellery Avenue lying south of and abutting the southerly line of Ellery Avenue, 50 feet wide, lying southerly of and abutting the southerly line of the westerly 13.57 feet of lot 26, lying southerly of and abutting the southerly line of the easterly 3.49 feet of lot 25 inclusive of Hallock's Subdivision of part of lots 10 and 11, George Hunt Farm, Detroit, Wayne County, Michigan, as recorded in Liber 2, Page 16, Plats, Wayne County records; lying northerly of and abutting the northerly line of lot 6, northerly of and abutting the northerly line of the vacated north-south alley, 20 feet wide, between lots 6 and 7; lying northerly of and abutting the northerly line of the westerly 17.06 feet of lot 5 inclusive of Miller and Hallock's Subdivision of Lot 9 and part of Lot 10, George Hunt Farm, Detroit, Wayne County, Michigan, as recorded in Liber 5, Page 22, Plats, Wayne County records; also

All that part of the public utility easement, (formerly Fort Street), 50 feet wide, between Ellery Avenue and Leib Street, lying easterly of the easterly line of Ellery Avenue, lying southerly of and abutting the southerly line of Lots 28 to 32 inclusive of Hallock's Subdivision of part of lots 10 and 11, George Hunt Farm, Detroit, Wayne County, Michigan, as recorded in Liber 2, Page 16, Plats, Wayne County records; lying southerly of and abutting the southerly line of lots 8 and 9 of James Dewey's Subdivision of the west part of lot 4, Leib Farm as recorded in Liber 1, Page 283, Plats, Wayne County records; lying southerly of and abutting the southerly line of the easterly 170.21 feet of the westerly 231.96 feet of lot 4

of the subdivision of the Leib Farm as recorded in Liber 45, Pages 664, 665, 666, and 667, Deeds, Wayne County records; lying northerly of and abutting the northerly line of lots 1 to 4 and the easterly 12.94 feet of lot 5, all inclusive of Miller and Hallock's subdivision of lot 9 and part of lot 10, George Hunt Farm, as recorded in Liber 5, Page 22, Plats, Wayne County records; lying northerly of and abutting the northerly line of lots 6 and 7 of James Dewey's Subdivision of the west part of lot 4, Leib Farm, as recorded in Liber 1, Page 283, Plats, Wayne County records; lying northerly of and abutting the northerly line of the north-south public alley, 16 feet wide, first west of Leib Street; lying northerly of and abutting the northerly line of lot 4 lying southerly of Fort Street of the subdivision of the Leib Farm as recorded in Liber 45, Pages 664, 665, 666, and 667, Deeds, Wayne County records.

Be and the same are hereby vacated to become a part and parcel of the abutting property subject to the following:

An easement of the full width of the above described street is retained for the Michigan Bell Telephone Company for the maintenance of its facilities. Construction plans will be submitted to the Michigan Bell Telephone Company for their approval.

Adopted as follows:

Yeas — Councilmen Hood, Ravitz, Tindal, Van Antwerp, Wierzbicki and President Pro Tem Miriani—6.

Nays—None.

STATE OF MICHIGAN)
CITY OF DETROIT)

ss.

SHORT FORM — TRUE COPY CERTIFICATE

I, THOMAS D. LEADBETTER, CITY CLERK of the City of Detroit, do hereby certify that the annexed paper is a True Copy of a Resolution

adopted by the Common Council on SEP 9 1969

and approved by the Mayor on SEP 15 1969

as appears from the Journal of said Common Council, on file in my office.

IN WITNESS WHEREOF, I have hereunto set my hand and affixed the Corporate Seal of said City, at Detroit, on

SEP 18 1969


Thomas D. Leadbetter
City Clerk

FORWARD TO STATE TREASURER

PETITION NO. 8827
SNYDER CORP.
S. DAVID HARRISON

APPROVED: SEPTEMBER 9, 1969

11521

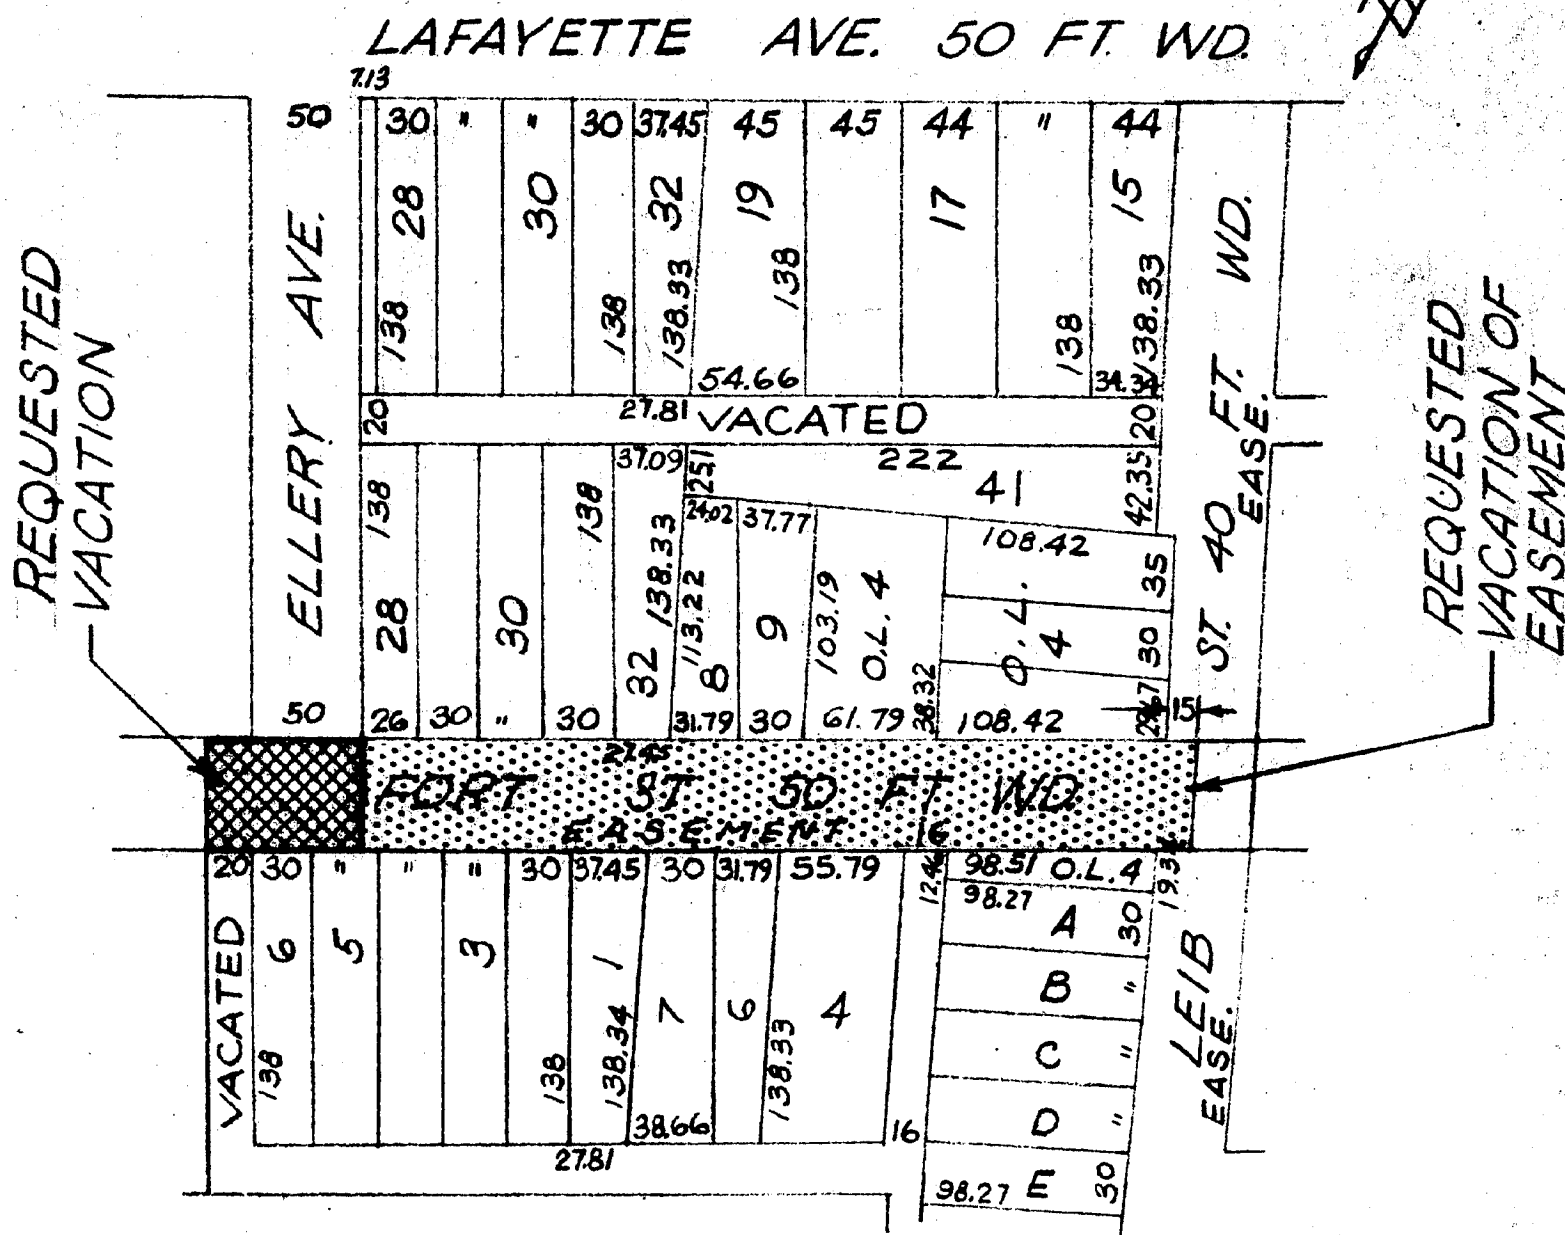

PLEASE NOTE REVISIONS
SUBN. OF THE LEIB FARM
TOPO NO. 38
SCALE 1"=100'

PLEASE RUSH REPLY

FOR OFFICE USE ONLY

B		REQUESTED VACATION		CITY OF DETROIT Dept. of Public Works City Engineers Office	
A REVISED		REQUESTED VACATION OF EASEMENT			
DESCRIPTION		Drwn	Chkd	Appd	Date
REVISIONS					
DRAWN BY PLUNGIS		APPROVED			
TRACED BY		APPROVED			
CHECKED K.E.		APPROVED			
CITY ENGINEER					
				Job No. MO 1(1)	
				Drwg. No. X-8827	
				Date 7-24-69	