

West Boundary Line of Lot 3 Section 6 Township 35 North Range 32 West

23 1/2

in 1882
Center of S. 32 W
Town 35 N R 32 W

Wm. Harris
Addition to

TORCHLAKE CITY

Examined and Approved

State of Michigan

County of Stoughton

July 23 1895

Attestation

Plat of land made this 23rd day of July A.D. 1895

inasmuch that the undersigned William Harris of the City of Torch Lake in the County of Stoughton and State of Michigan

is the proprietor of the land embraced in the plat hereon shown

and that the undersigned Otto Stahmann an Engineer of Torch Lake in the County and State of Michigan is the person who made this plat that said plat embrace all the portion of Lot No 3

of Section 6 in Township Number 35 North of Range 32 West in said County of Stoughton commencing at a point in the west

boundary line of Lot No 3 33 1/2 feet south of the center of said section & thence running south 39 1/2 feet thence in an easterly direct

line 707 1/2 feet thence in a southerly direction 210 feet along the

west line of Schoolcraft Street thence northerly 788 feet to the place of beginning being known as Block I of children and Douglas's addition to the City of Torch Lake

in witness whereof we have hereunto set our hands and seals this day and year first above written

Witness my hand and seal in presence of

A. D. Wilson
Frank Green

State of Michigan County of Stoughton

On this 23rd day of July 1895 the above named William Harris personally appeared before me a Notary Public in and for said County personally appeared

Wm. Harris and Otto Stahmann to me known to be the persons named above and who executed the within instrument who acknowledged the same to be their free and voluntary act and deed

A. D. Wilson Notary Public in and for Stoughton Co. Mich



State of Michigan

County of Stoughton

Shed & Harris

Register of Deeds and Otto Stahmann

Engineer hereby certify that

we have personally examined the

plat and found the same correct and

that the duplicate plat of the same

is on file in the office of the

Register of Deeds and the duplicate

plat is recorded

Witness my hand and seal

Shed & Harris

Register

Otto Stahmann

Engineer

REGISTER'S OFFICE

Received for record the 4th day

of August A.D. 1895 at 2

o'clock P.M. and recorded in Vol.

1 of Plats page

Witness my hand and seal

Shed & Harris

Register

John B. Fountain

Clerk and Sec. Dept.

Dated this 25th day of May 1911

General by placing the plat in

record and affixing thereto a carefully

comparing copy of the dedication and certificate

of the Auditor General

of the plat now on record in the

Register of Deeds

of the plat

now on record in the

Register of Deeds

of the plat

now on record in the

COUNTY CLERK'S OFFICE

FILED

AUG 4 1895

This is the Middle Register

HOUGHTON County

Vacations and alterations
of
PLATS

PLAT- WM HARRIS ADDITION TO TORCH LAKE CITY

In re petition)
WM Harris to)
Vacate part of)
Harris Street)

ORDERED: That that part of Harris Street in said Addition described as "Commencing at a point in North and South center Section line of Section 6, Town 55 N R 32 W, 417.41 feet, South of Center said Section thence ~~15.09~~ running South on said center section line 15.09 feet, thence North 89° 39' 30" East 56.33 feet, thence in a direct line 57.98 feet to place of beginning, containing an area of 600.89 square feet" be and the same is hereby VACATED and is attached to Lot 12 Block 3, of said Addition.

Order Judge Wm B Williams
May 25, 1886
Cal No. 605

Aud Gen Dept Vol 145

Page ~~11162~~

11816 ✓

E & B Plat Examiners
September 1915
~~Recess~~

PLAT - WEST HOUGHTON

In re petition)
Anna Smith)
al to Vacate)
part of First Street)

ORDERED: That that portion of said FIRST Street from a point on said Street where it joins the Street marked Montezuma, to the Point on said First Street where the same joins the Street marked "Albion" be and the same is hereby VACATED. The title of said lands so described and vacated shall vest in the person or persons owning the property on each side to the center of said street, and shall be attached to the Lots bordering on said Street.


Order Judge Wm B Williams
May 21, 1888
Cal No. 700

Aud Gen Dept Vol ~~87~~ 171

Page ~~4155~~

13971 ✓

E and B Plat Examiners
September 1915

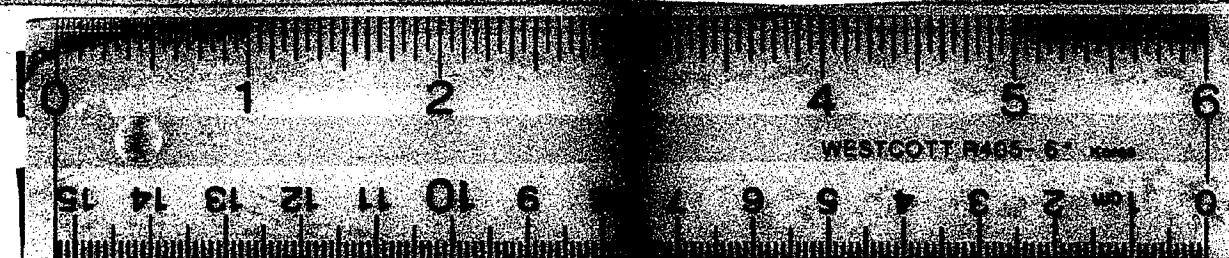

16 X