


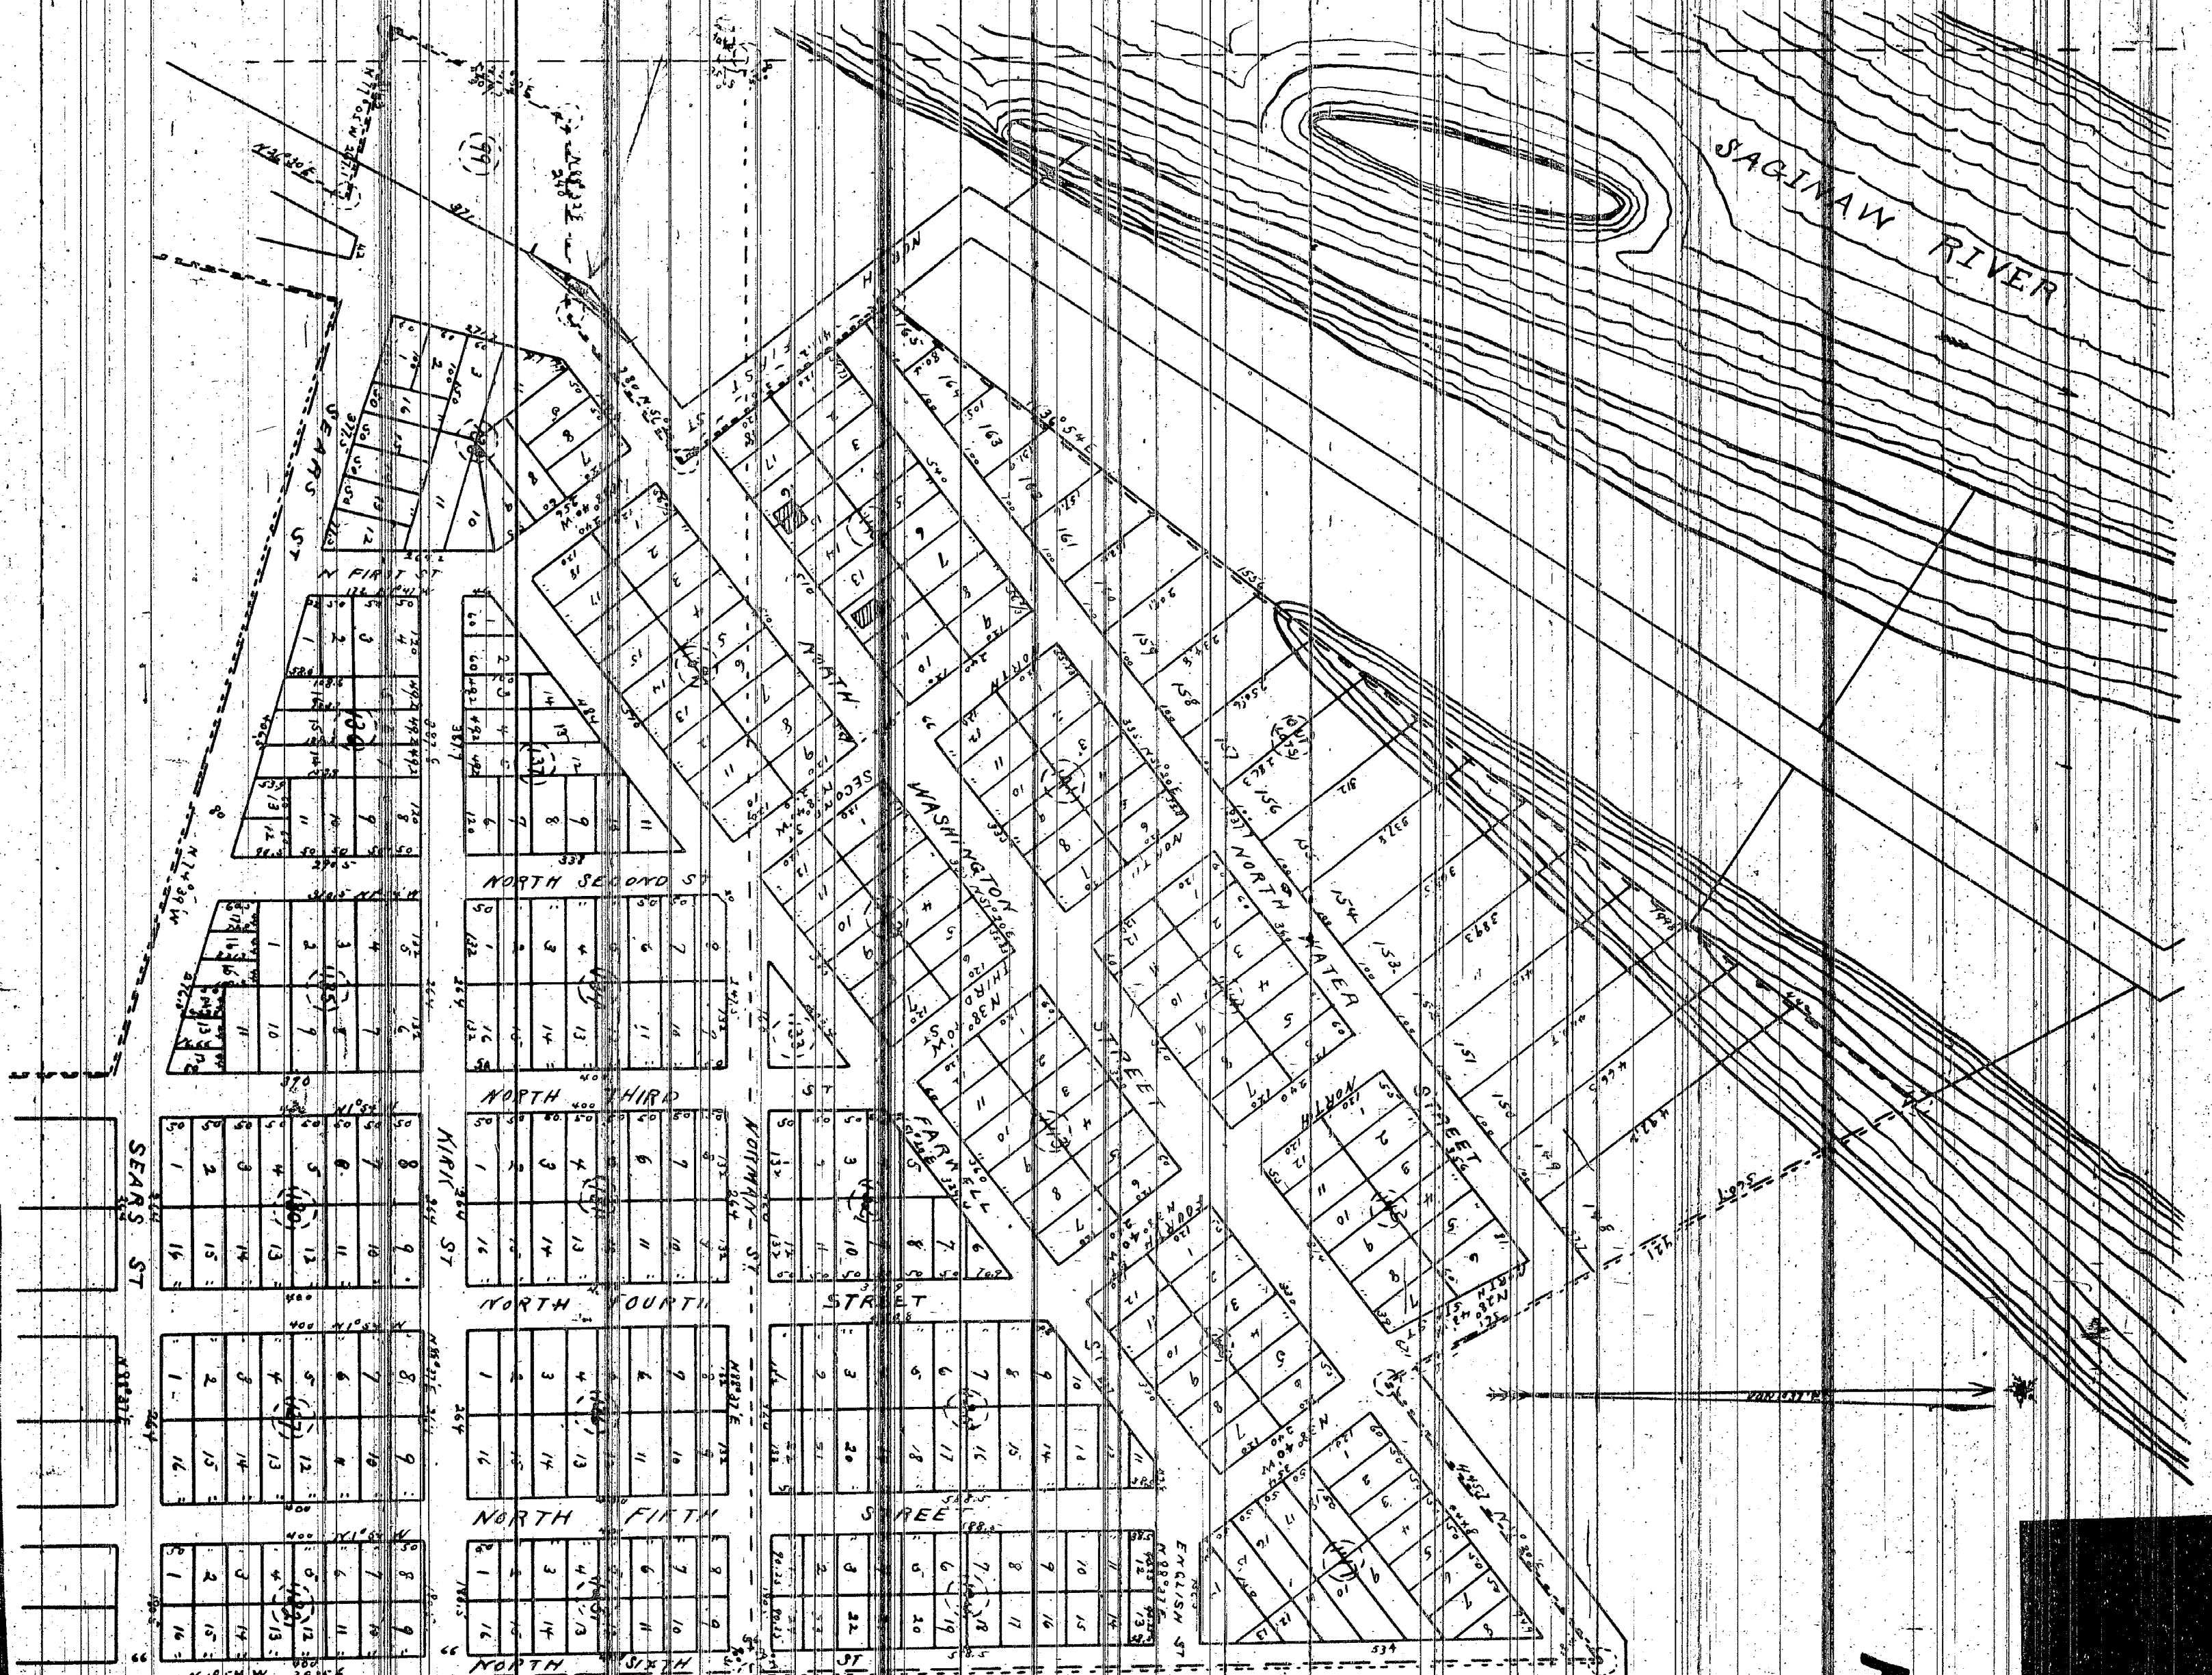

HOYT'S NORTHERN ADDITION
to the City of

EAST AFRICA

for

Dissected
The sand here Shuttled is a portion of the N. E. half of Section Eighteen
on S 12 N of R 5 E & a small portion of the S. E. part of a portion of
Section Twentieth on S 12 N of R 5 E. Bounded & described as
follows Commencing at the South Quarter East of Section Eight-
een - Thence N 1/2 S 1/4 W 39.2.5.6 On N & S quarter line to Centre of N. E. 1/4 of

-cen - 3 hours N 103.4 W 3325.6 On N x S quarter line to Centre of Road at
 " S. 51.20 N. 545.7 along to Centre of Washington Street
 N 28.9 43 W 921.7 On the S. E. of the 1st south line

" S 36° 24' N 1498 116 Quatre of boxes to north of 2nd St
" S 38° 40' E 410 ? NW 1/4 of 1st St to south of 4th St
" S 38° 40' E 410 ? NW 1/4 of 1st St to south of 4th St

" S 51°20' W 280 Along base of shore to angle of sheet
to 6171 ft. S 47° 0'

2603014	309.5	Dec "	"	East	Lucie
---------	-------	-------	---	------	-------

" " 87705 E 267.1 W D. J. M. Railway Route of Main St
" " 26030 W 7732 Along Route of Hamilton St to Bridge St
" " 26030 W 7732 Along Route of Hamilton St to Bridge St

[illegible]

" N 88° 34' 36" E 1204.9 Along Nodal line of major faultation to N.E. cor
all 8 11 11 50 0

"	D 1051 E	6557	Along coast line of "	"	" DE, Car
N 86° 21' E	1211.9		Along south line of section between place		

of beginning

Shewling early, that this Plat is a correct copy of
the Plat now on Record in the Register of Middlebury
Office, being made under the supervision of the Author
of the same, the same is Plat on Record and all
the other a duly certified copy of the said records
Dated the 26th day of July 1911

Olton B. Ford

Elek und sein Hof

Registers Office }
Saginaw County }
Received for Record July 15th AD 1864
at 11³⁴ O'Clock A.M. and Recorded in Liber
N^o 28 of Deeds Plate & Maps Page 63
Jas. H. Carter, Register

Know all men by these Presents that the Land laid out or Platted in the Margin is owned by George Hoyt of the County and City of New York

That said Map or Plat is now executed by the said
as Producers and
W^m B. Sears and S. P. Kirby as Surveyors in accordance with the
provisions of the Act to provide for recording Town Plats and for vacating
the same in certain cases and the Act of American duties hereto and for the
purpose of being recorded as Town's Northern Addition to the
City of East Saginaw County of Saginaw State of
Michigan The Size of the Lots all within of the Streets are given
on said map in Feet and Decimal parts of feet
In Witness Whereof we have hereunto set our hands and Seals
this 21st day of May A. D. One thousand Eight hundred & Sixty
four

In presence of
 Leonard (Marline &)
 Theodore & visited past few days
 John B Lodge } as to S. Kirby
 C. L. Gage } & W. B. Sears

State of New York } ss:
County of New York }
On the 24th day of May, A.D. 1964 before me the undersigned a Commissioner appointed by the Governor of the State of New York to take the acknowledgment of instruments in writing of the State of Michigan and its administrator acting and affirmations personally appeared the above named Jesse Hays, Jr. to me known to be the same person(s) described in and who executed the foregoing instrument and acknowledged to me that he had executed the same for the purposes herein expressed.


In Witness Whereof I have hereunto set my hand and affixed my seal of office the day and year aforesaid.

Wm Brewster
Commissioner for the State of Michigan
residing in the City of New York

[SEAL]

State of Michigan } under this 6th day of
January aforesaid }
I, the undersigned, being a Notary Public
in and for the County of Saginaw, do hereby
attest Stephen P. Kirk and William H. Reed
survivors known to me to be two of the heirs who signed the
 foregoing instrument and acknowledged the execution of the
 same to be their free act and deed

[SEAL] C. H. Eggle
Notary Public Saginaw County


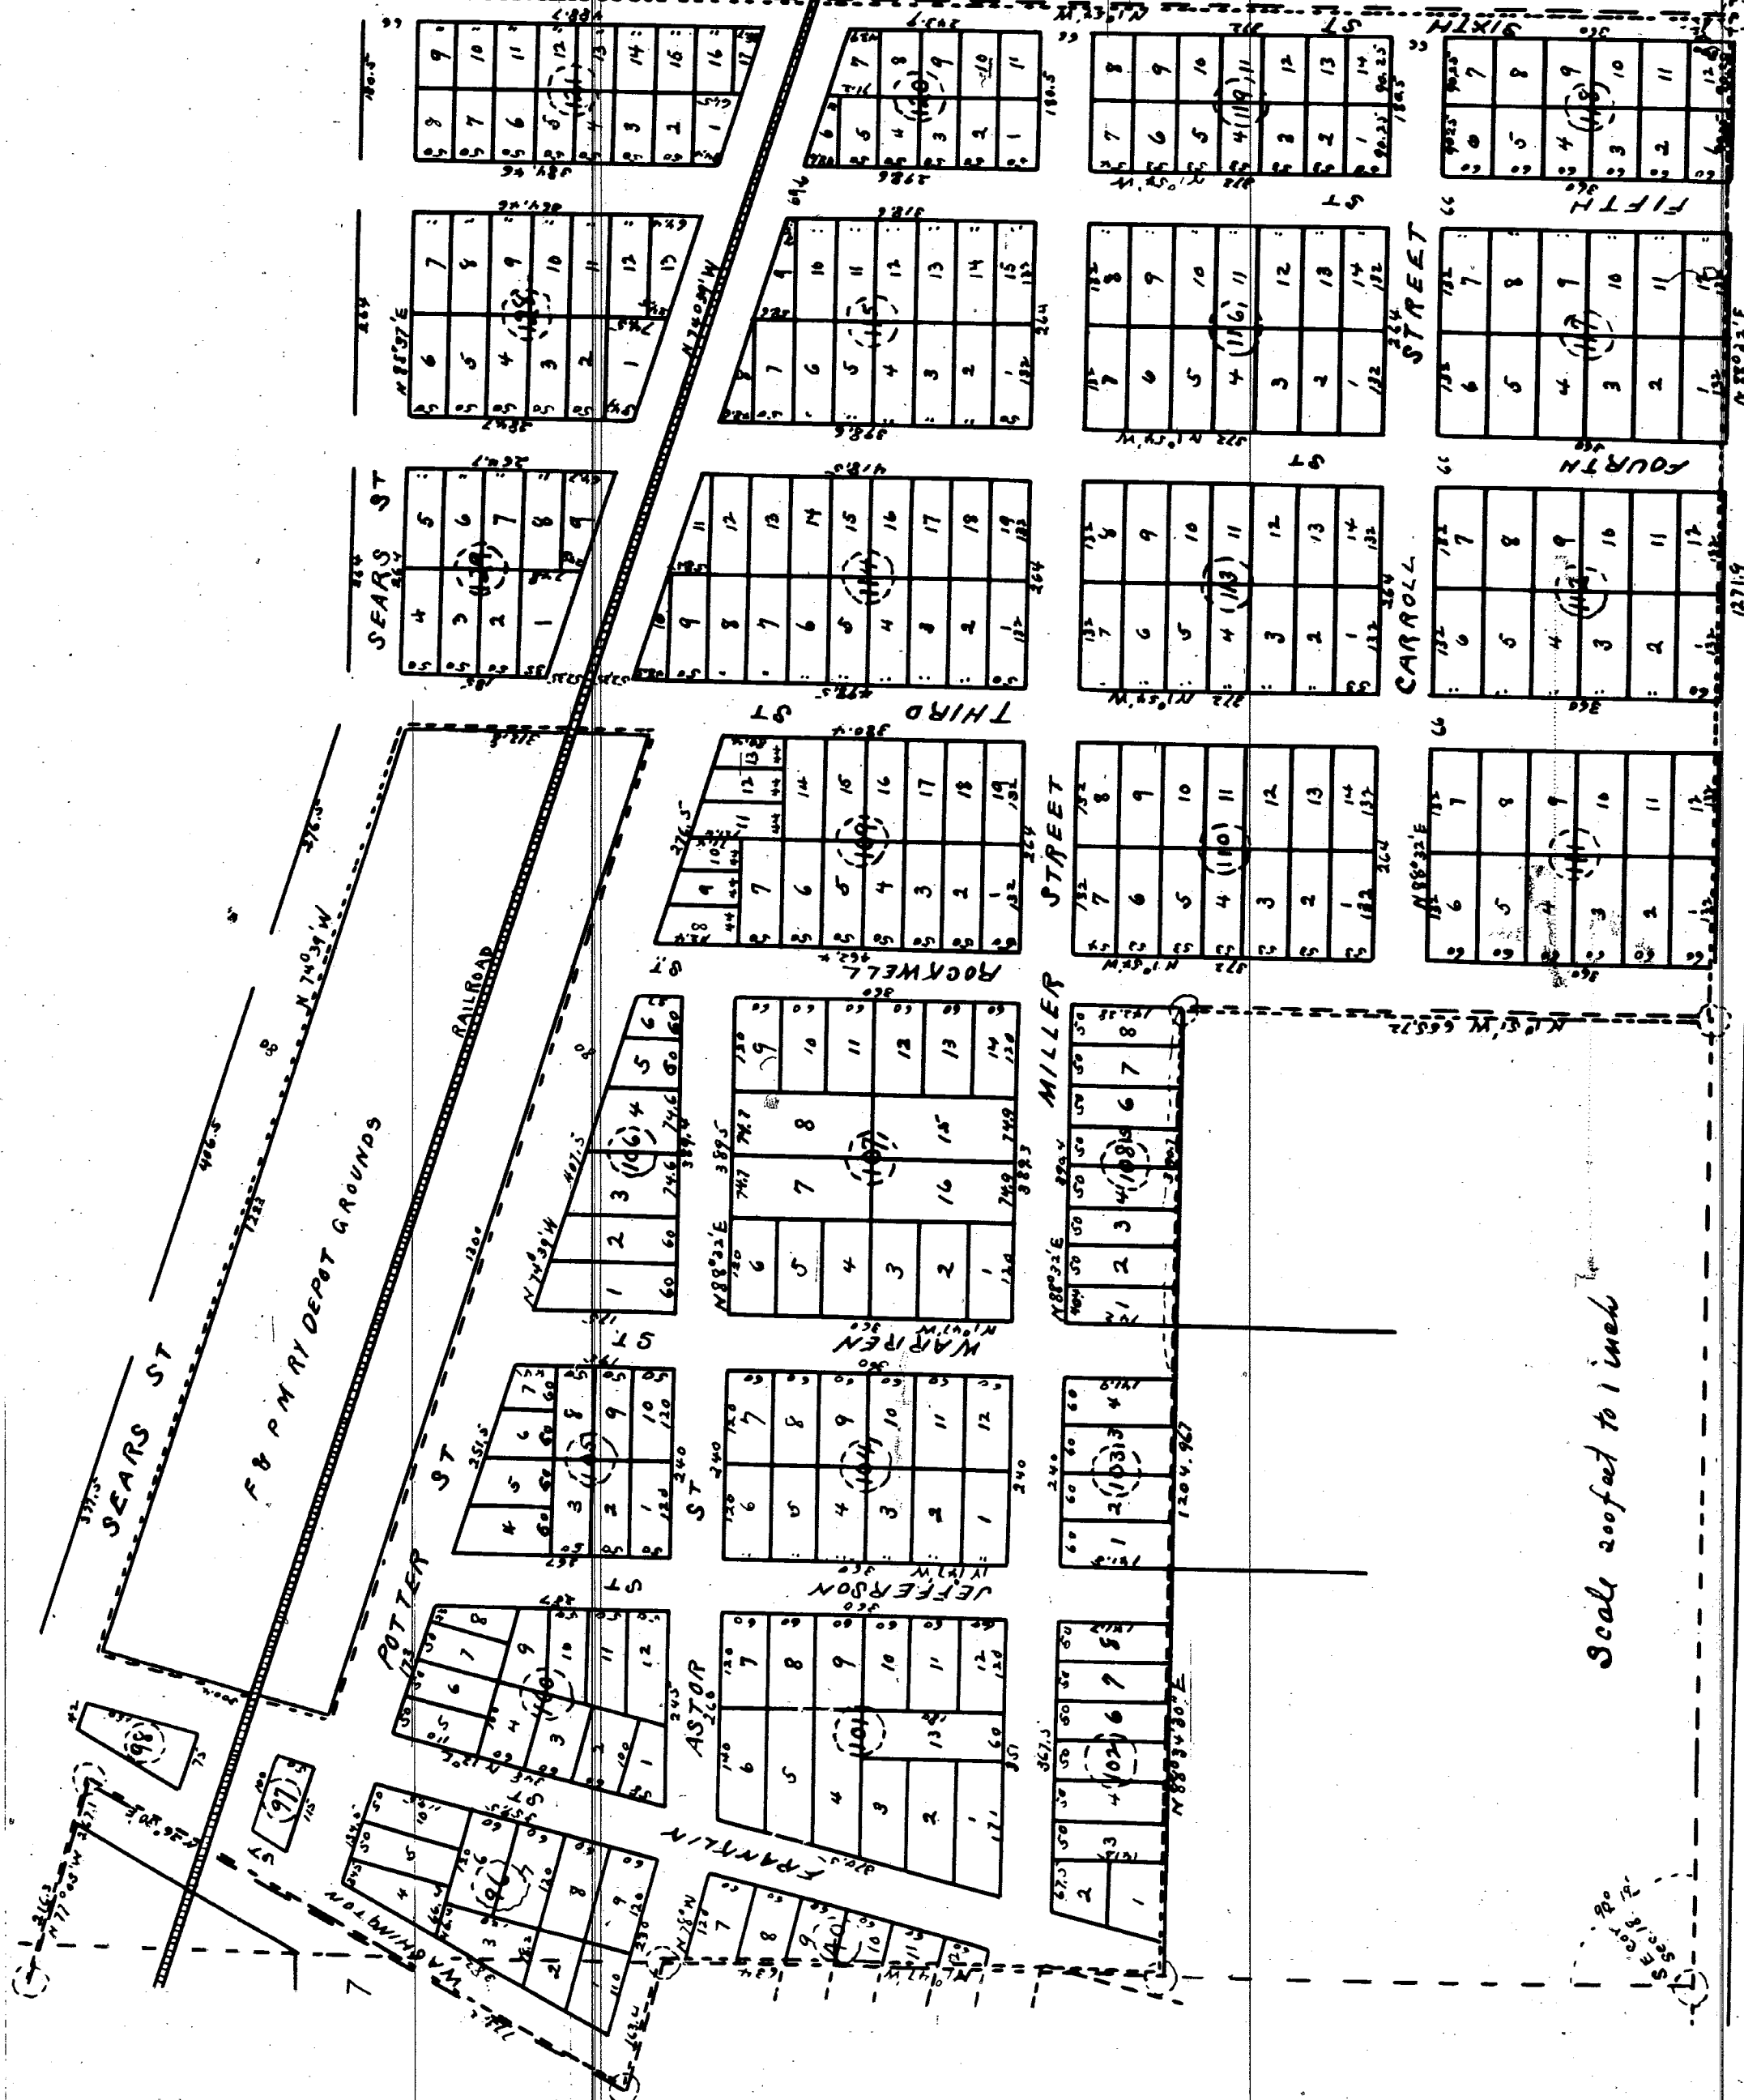


Scale 200 feet to 1 inch

27381
11438477 NO: 92-1990
90 99170
CITY OF FARMINGTON HILLS
STREET VACATION RESOLUTION NO. 2
At a session of the City Council of the City of Farmington Hills, Oakland County, State of Michigan, held in the City Hall on the 14th day of May, 1990, at 7:30 o'clock, P.M.
Present: Bates, Fox, Grant, Lichtman, Marks, Sever and Vagnozzi
Absent: Nine
The following resolution was offered by Bates and supported by Marks:
WHEREAS, the Council of the City of Farmington Hills did on the 16th day of April, 1990, determine that it is advisable to vacate, discontinue or abolish the following road, street or alley, located in the City of Farmington Hills, and subject to the jurisdiction of the City of Farmington Hills.
The westerly 30 ft. of the previously vacated Bramwell Street located between Lot 4 and Outlot A in the Supervisor's Plat of Forest Hills, Section 14, City of Farmington Hills, Oakland County, Michigan
Outlot A is in Orchard Corporate Center
23-14-126-014-DLA 8932 REG/DEEDS PAID
0001-JUN-27-90 081428
126-003-L014 3300 HISC 11.00
WHEREAS, the Council has met and heard any and all objections to such vacation, discontinuance or abolition and having determined to proceed in accordance with the Farmington Hills City Code, Chapter 10, Article VI, 10.430.
NOW THEREFORE, BE IT RESOLVED:
1. That the above-captioned road, street or alley is hereby vacated, discontinued or abolished.
2. That there is hereby reserved along, across and upon such vacated road, street or alley an easement for public or private utility
-1-
11.00
OK

11438478
purposes, the use of which shall be subject to the approval of the Council of the City of Farmington Hills.
3. That the City Clerk is hereby directed to file certified copies of this resolution with the Oakland County Register of Deeds and the Secretary of State of the State of Michigan, as required by statute.
Ayes: Bates, Fox, Grant, Lichtman, Marks, Sever and Vagnozzi
Nays: None
Abstentions: None
This resolution was adopted.
STATE OF MICHIGAN }
COUNTY OF OAKLAND } SS.
I, the City Clerk of the City of Farmington Hills, hereby certify that the foregoing is a true and correct copy of a resolution of the City Council of the City of Farmington Hills, adopted at a regular meeting of said Council held on the 14th day of May, 1990, the original of which is on file in my office.
Kathryn A. Dornan
City Clerk
Kathryn A. Dornan
/s/

When recorded, return to:
Kathryn A. Dornan, City Clerk
31555 Eleven Mile Road
Farmington Hills, MI 48018

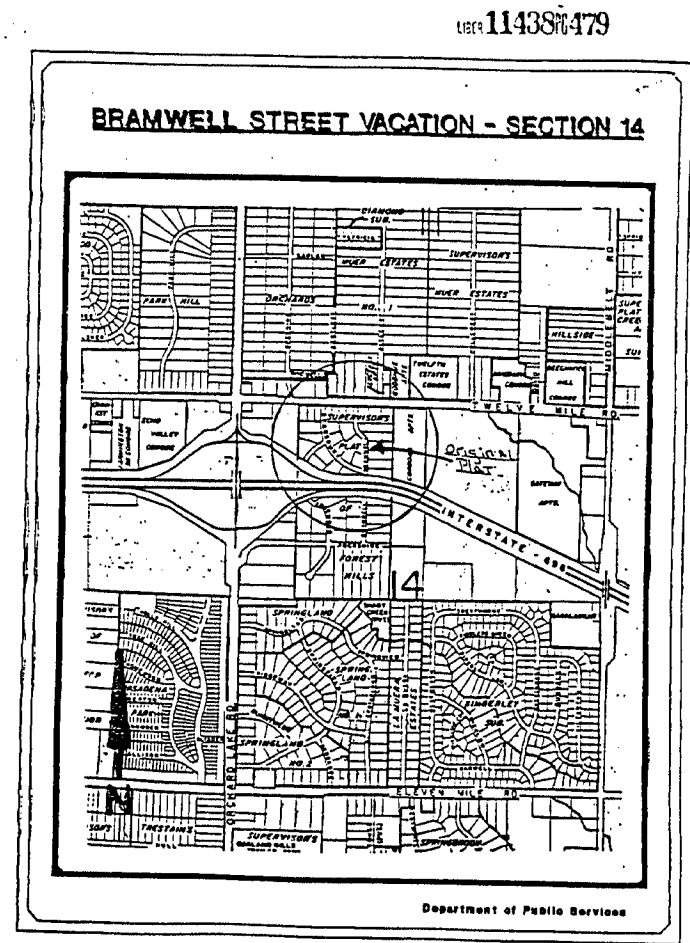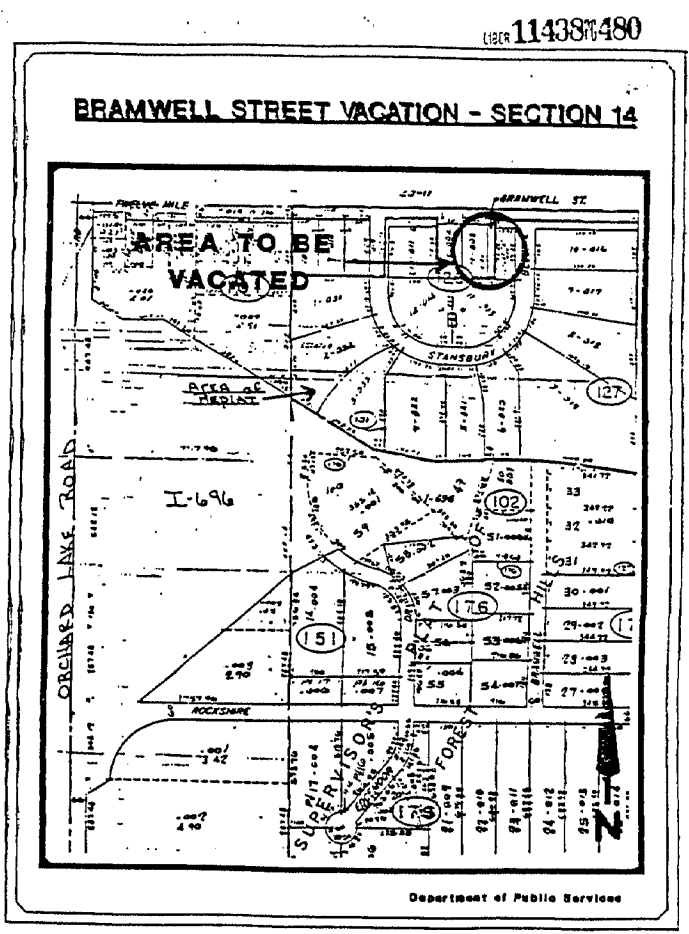

✓ PLAT - HOYT'S PLAT CITY SAGINAW

In the matter of the Petition
of Wicks Bros, for the
vacation of certain
streets and parts of streets in
Hoyts Plat of the city
of Saginaw.

Chancery Liber K Page 12
File 7975
dated December 2nd, 1907

On motion of Beach and Okufe and Rockwith,
solicitors, for said petitioners, it is ordered, adjudged and decreed and this
court, by virtue of the authority therein, vested and in pursuance of the statute
in such cases made and provided doth order adjudge and decree that Carlisle
Street from Washington Avenue, to Water Street, Astor Street, from Washington,
Avenue, to the Baginaw River, Water Street from the North line of Carlisle
Street to Astor Street and three feet off the easterly side of Water Street
extending across Carlisle Street and also three feet off the easterly side of
Water Street in front of lots one to six inclusive, all in Block fourteen in
Hoyts Plat, to the city of East Saginaw, now a part of the city of Saginaw,
be vacated, altered and abandoned and said plat is hereby modified, to this
effect.

Curts & Taylor
Plat Examiners

Vol- 146- Page- 12057 ✓

✓ PLAT -HOYTS NORTHERN ADDITION CITY SAGINAW

In the matter of the petition
of Pere Marquette Railroad
Company, for vacation, of certain, parts of
north Washington Avenue in Hoyts, Northern Addition
of the city of East Saginaw, now Saginaw, Michigan/

C C Calendar K Page 44 1
File 8831

dated Feb 20, 1911


ORDERED: adjudged and decreed that that part of North Washington
Avenue, viz: A strip of land commencing at a point on the east line of North
Washington, Avenue, Three Hundred ninety six (396) feet north of the north
line of Porter Street, Thence northerly on said east line of Washington, Avenue,
seventy five, (75) feet, to a point four hundred seventy one (471) feet from
said north line of Porter Street thence at right angles with said east
line of north Washington, Avenue westerly a distance, of Twenty five, (25)
feet to a point Thence southerly parallel with said westerly line of north
Washington Avenue a distance of ~~seventy five~~ (25) feet. Thence easterly a distance
of twenty five, (25) feet to place of beginning. Being parts of north Washington
Avenue, in Hoyts Northern Addition to the city of East Saginaw, now a part of
the city of Saginaw, Michigan, is hereby modified to this effect and the court,
doth further order that the proceedings, in this cause, be recorded by the Re-
gister of this court, with the records of this court,

Wm G Gage,
Circuit Judge

Countersigned, A.C. Leace,
Depty, Recorder.

Curts & Taylor
Plat Examiners

Vol- 146- Page- 12054 ✓

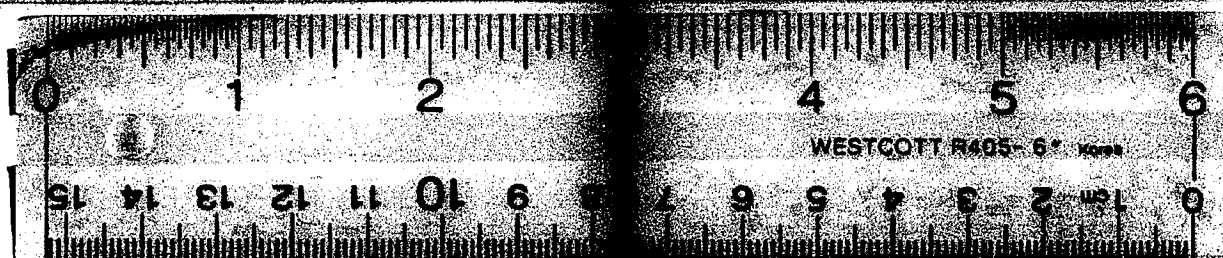

16 X