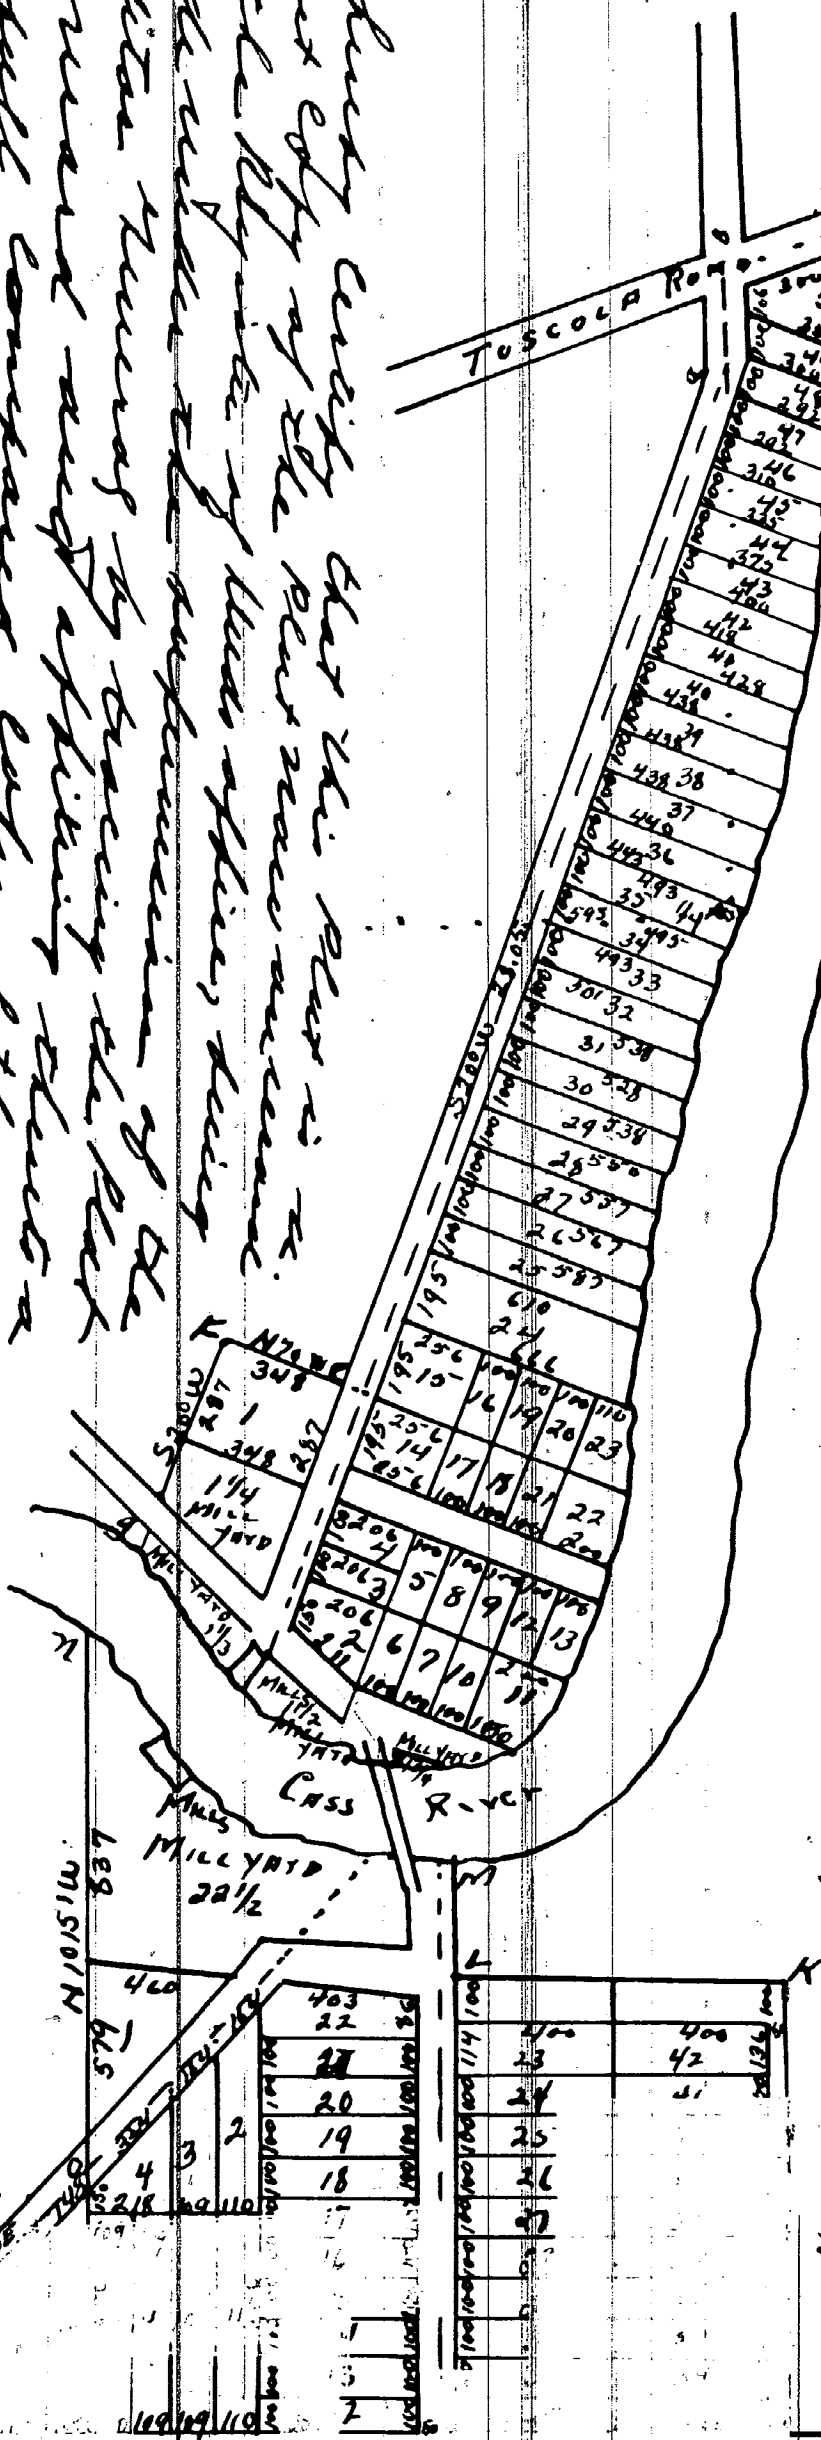


May the 19th day of July, 1938
 Jay Ellsworth
 Chief, Que. Min. Dept.

I trust every one that this Plot is a
 correct copy of the Manuscript we received
 in the Polytechnic of these officers, being
 made under the supervision of the
 American Bureau by tracing the Plot
 on several good copying sheets a
 perfectly complete copy of the
 information very complete

[illegible]

Map
of the
Village of Frankenhmuth

The Union Village of Frankenthal as being noted by the Plot is intended
to remain in the office of Registry of Mts. for registration County seat.
Campuses three hundred during June 72 acres no set point in the
survey and upon the Government Agency from there, named and
the distance of the property is that the within Plot Chalkyburn
and take the place of the original survey for the purpose of
more Community according the property herein existing also
that the street grid along thereon provided are hereby given
as public highway and subject to the same restrictions
as any other highway.
Witness my hand & seal this 16 day of March, 1859 at New York

State of Michigan } On the 10th day
County of Wayne } Notary Public in and for said County
Examd the above named George W. Belmont & being personally
known, we certified the within Power and acknowledged that he
the same for the purpose therein expressed Geo. Belmonts notes
State of Michigan } On the 23rd day of March A.D. 1859 before me
County of Wayne } Notary Public in and for said County personally
above named John S. Kirtland & known to me to be the person
executed the within Power and acknowledged that he executed
same for the purpose therein expressed Geo. Belmonts notes
Register of said } Record made 21st 1859 at
Wayne County } P.m. Geo. Belmonts
Notary

500	500	500	204	267	500	500	500	500	10.00	10.00	10.00	4.00	5.00
52	52	52	254	267	5A	5A	5A	5A	202	202	202	92	112
51	50	49	48	47	46	45	44	43	76	77	78	79	80
500	500	500	204	267	500	500	500	500	500	500	500	500	500
873	873	873	873	11.32	573	573	573	573	573	573	573	573	573
440	440	440	440	573	573	573	573	573	573	573	573	573	573
52	52	52	52	64	64	64	64	64	64	64	64	64	64
508	508	508	508	508	508	508	508	508	508	508	508	508	508
443	443	443	443	573	573	573	573	573	573	573	573	573	573
53	53	53	53	65	65	65	65	65	65	65	65	65	65
508	508	508	508	508	508	508	508	508	508	508	508	508	508
443	443	443	443	573	573	573	573	573	573	573	573	573	573
54	54	54	54	66	66	66	66	66	66	66	66	66	66
508	508	508	508	508	508	508	508	508	508	508	508	508	508
443	443	443	443	573	573	573	573	573	573	573	573	573	573
55	55	55	55	67	67	67	67	67	67	67	67	67	67
508	508	508	508	508	508	508	508	508	508	508	508	508	508
443	443	443	443	573	573	573	573	573	573	573	573	573	573
56	56	56	56	68	68	68	68	68	68	68	68	68	68
508	508	508	508	508	508	508	508	508	508	508	508	508	508
443	443	443	443	573	573	573	573	573	573	573	573	573	573
57	57	57	57	69	69	69	69	69	69	69	69	69	69
8.24	8.24	8.24	8.24	11.32	11.32	11.32	11.32	11.32	1000	1000	1000	1000	1000

Part of Plat shown in red is vacated and altered by order of the Circuit Court at a session held Nov. 17, 1936.

LIBER 1763 PAGE 188

RESOLUTION NO. 90-11

A RESOLUTION VACATING A 33 FOOT RIGHT-OF-WAY ON THE SOUTH SIDE OF THE FRANKENMUTH AGRICULTURAL PARK

BE IT RESOLVED BY THE CITY COUNCIL OF THE CITY OF FRANKENMUTH, that:

The attached street right-of-way is hereby vacated and abandoned.

Action APPROVED

Date FEB. 6, 1990

GARY C. RUPPRECHT, MAYOR

CHARLES B. GRAHAM, CLERK



LIBER 1763 PAGE 1881

12267

RECORDED

Description For: City of Frankenmuth
240 West Genesee
Frankenmuth, Michigan 48734


FEB 20 3 39 PM '90

MILDRED H. DODAK
REGISTER OF DEEDS
SAGINAW COUNTY MICH.

DESCRIPTION VACATING A 33 FOOT RIGHT-OF-WAY
ON THE SOUTH SIDE OF THE PROPOSED
FRANKENMUTH AGRICULTURAL PARK

A 33.00 feet wide, measured at right angles, strip of land in the South 1/2 of the Southwest 1/4 of the Northwest 1/4 of Section 35, T.11N.-R.6E., City of Frankenmuth, Saginaw County, Michigan, lying South of and adjacent to the South line of Lots 83 and 84, Map of the Village of Frankenmuth, South of the Cass River, according to the Plat thereof recorded in Liber 38, Page 297 of Plats, Saginaw County Records, described as follows: To fix the point of beginning commence at the West 1/4 corner of Section 35; thence N.00°-09'-15"E., on the West line of said Section, 33.00 feet; thence S.89°-19'-11"E., parallel with the East and West 1/4 line of said Section, 33.00 feet to the Southwest corner of Lot 84, Map of the Village of Frankenmuth, South of The Cass River; thence continuing S.89°-19'-11"E., on the South line of said Lot 84, 27.00 feet to the point of beginning of this description; thence S.89°-19'-11"E., on the South line of Lots 83 and 84, 1,244.79 feet to the Southeast corner of said Lot 83; thence S.00°-00'-39"E., on the Southerly extension of the East line of said Lot 83 being also the West 1/8 line of said Section, 33.00 feet to the Southeast corner of the Southwest 1/4 of the Northwest 1/4 of said Section; thence N.89°-19'-11"W., on said East and West 1/4 line, 1,244.89 feet; thence N.00°-09'-15"E., on a line which is parallel with and 60.00 feet, measured at right angles, East of said West Section line, 33.00 feet to the point of beginning.

Prepared By: John M. Juras
Licensed Land Surveyor Number 33980
Advocate Engineering
305 South Franklin Street
P.O. Box 148
Frankenmuth, Michigan 48734

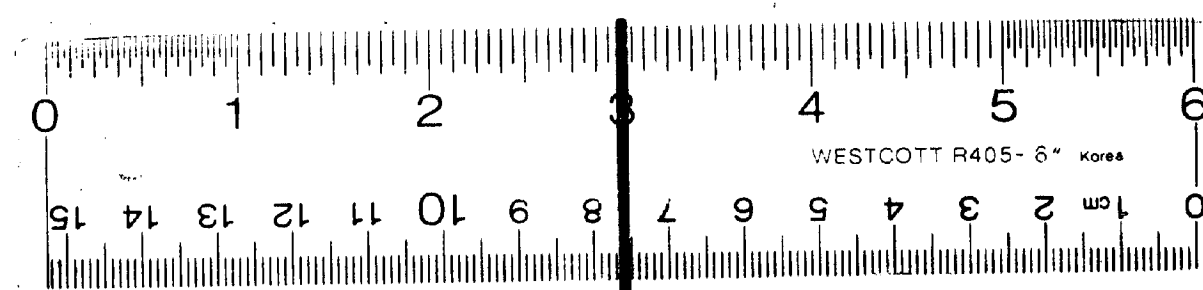

16 X