

[illegible]

where in 1868
Osgood County
Michigan

Joe E. Johnston
Paragon of Illinois

I should certify that this Part is a carefully compared copy of the Chart now in Record in the Register of Deeds Office, & that I made under the supervision of the auditing General by having the Chart on Record and approving that a carefully compared copy of the certificate dated the 18 day of September 1911

Attest, B. B. Wood,
Clerk, and Sec. Regt.

Clark, und der Rest.

Clark, and her self.

R. H. WEIDEMANN & CO'S
SECOND ADDITION
TO
THE VILLAGE
PLAT
OF
WEST BRANCH

Carleton Office } ss
Lepman County }

We do hereby certify that we have carefully compared the covered master plat with the original Master Plat of P. M. Weidemann & Co. Second Addition to the Village Plat of West Branch Township, Michigan and that it is an exact duplicate thereof and of the whole of such Master Plat.

Seeds w/ 6 feet to the bush

Register Office }
Magnum Indict }
1855

Record for Record January 29th 1892
at 30 Jackson's Record in New City of New York
at page 891

James E. Johnston
Register

[Handwritten signature]

[illegible]

Vacated See L 16 of Allende
 Page 244
 H L H 9 1 E

[illegible]

29	29	29	29
29	29	29	29
29	29	29	29
29	29	29	29

Hand-drawn map of a property with dimensions and area calculations:

- Top horizontal dimension: 132
- Left vertical dimension: 66
- Bottom-left vertical dimension: 55
- Bottom horizontal dimension: 155
- Right vertical dimension: 77
- Area calculations: 8712, 4620, 4095, 4620
- Internal horizontal dimension: 138
- Internal vertical dimension: 66
- Internal area calculation: 2

8190412

5th
Road

I

0

۷

५

T

7

Q

✓

4

3

17

2

U

三

CHARLES W. JENNINGS
DEMETRE J. ELLIAS

JENNINGS AND ELLIAS, P.C.
ATTORNEYS AT LAW
575 COURT STREET
P. O. BOX 487
WEST BRANCH, MICHIGAN 48661

January 28, 1986

(517) 345-5330

State of Michigan
Commerce Department
Plat Unit
P. O. Box 30004
Lansing, MI 48909

Gentlemen:

Enclosed please find copy of a recorded certified copy of a Resolution of the Council of the City of West Branch vacating the non-developed portion of Sixth Street located in the plat of R. H. WEIDEMANN & CO. SECOND ADDITION TO THE VILLAGE (NOW CITY) OF WEST BRANCH, Michigan, according to MCLA 560.256 and 257.

Yours very truly,

JENNINGS AND ELLIAS, P. C.

Demetre J. Ellias
Demetre J. Ellias

DJE:emb
cc: file
enclosure

PREPARED BY:
Demetre J. Ellias
JENNINGS AND ELLIAS
ATTORNEYS AT LAW
575 COURT STREET
P. O. BOX 487
WEST BRANCH, MICH.
48661

LIBER 304 PAGE 771

12329

RESOLUTION

WHEREAS, the Council of the City of West Branch, being advised that the requirements of Section 7.5 of the City's Charter of notice of public hearing, publication and posting, have been completed, and

WHEREAS, on its regular meeting having held a public hearing on the vacation of the non-developed portion of Sixth Street located in the plat of R.H. WEIDEMANN & CO. SECOND ADDITION TO THE VILLAGE (NOW CITY) OF WEST BRANCH, Michigan, described generally as:

Part of the SW 1/4 of the SW 1/4 of Section 19, Town 22 North, Range 2 East, lying East of and adjacent to Lot 1 in Block 3 of R.H. WEIDEMANN & COMPANY'S SECOND ADDITION TO THE VILLAGE (NOW CITY) OF WEST BRANCH, OGEMAW COUNTY, Michigan, and commencing at the Northeast corner of said Block 3, and running thence South 132 feet, thence East 66 feet, thence North 132 feet, thence West 66 feet to point of beginning.

THEREFORE, BE IT RESOLVED:

That the City Council vacates Sixth Street as described above; that the title to the vacated street hereinbefore described shall be vested in the title holders of lots abutting thereon; and that the City of West Branch reserves an easement in said street for public utility purposes and other public purposes in accordance with MCLA 560.256, 257, as amended.

Moved by Councilman Arnold Dunbar
and supported by Councilman Phil Foltz
to be recommended for approval.

Yeas: Mayor Richard Werth, Council Members Jean David,
Arnold Dunbar, Phil Foltz, Keith Sharrow, Todd
Thompson

Nays: None

Absent: None

Motion carried.

Gloria M. Oswald
Gloria M. Oswald, City Clerk

STATE OF MICHIGAN)
COUNTY OF OGEMAW) ss.

We hereby certify that the foregoing is a true and complete copy of a Resolution offered and adopted by the City Council at a regular meeting held on the 20th day of January, 1986.

(SEAL)

Gloria M. Oswald
Gloria M. Oswald, City Clerk


RECORDED
OGEMAW COUNTY, MI

Liber 304-Page 771-3 incl.

1986 JAN 22 PM 3:04

Noted in File
12329


000194

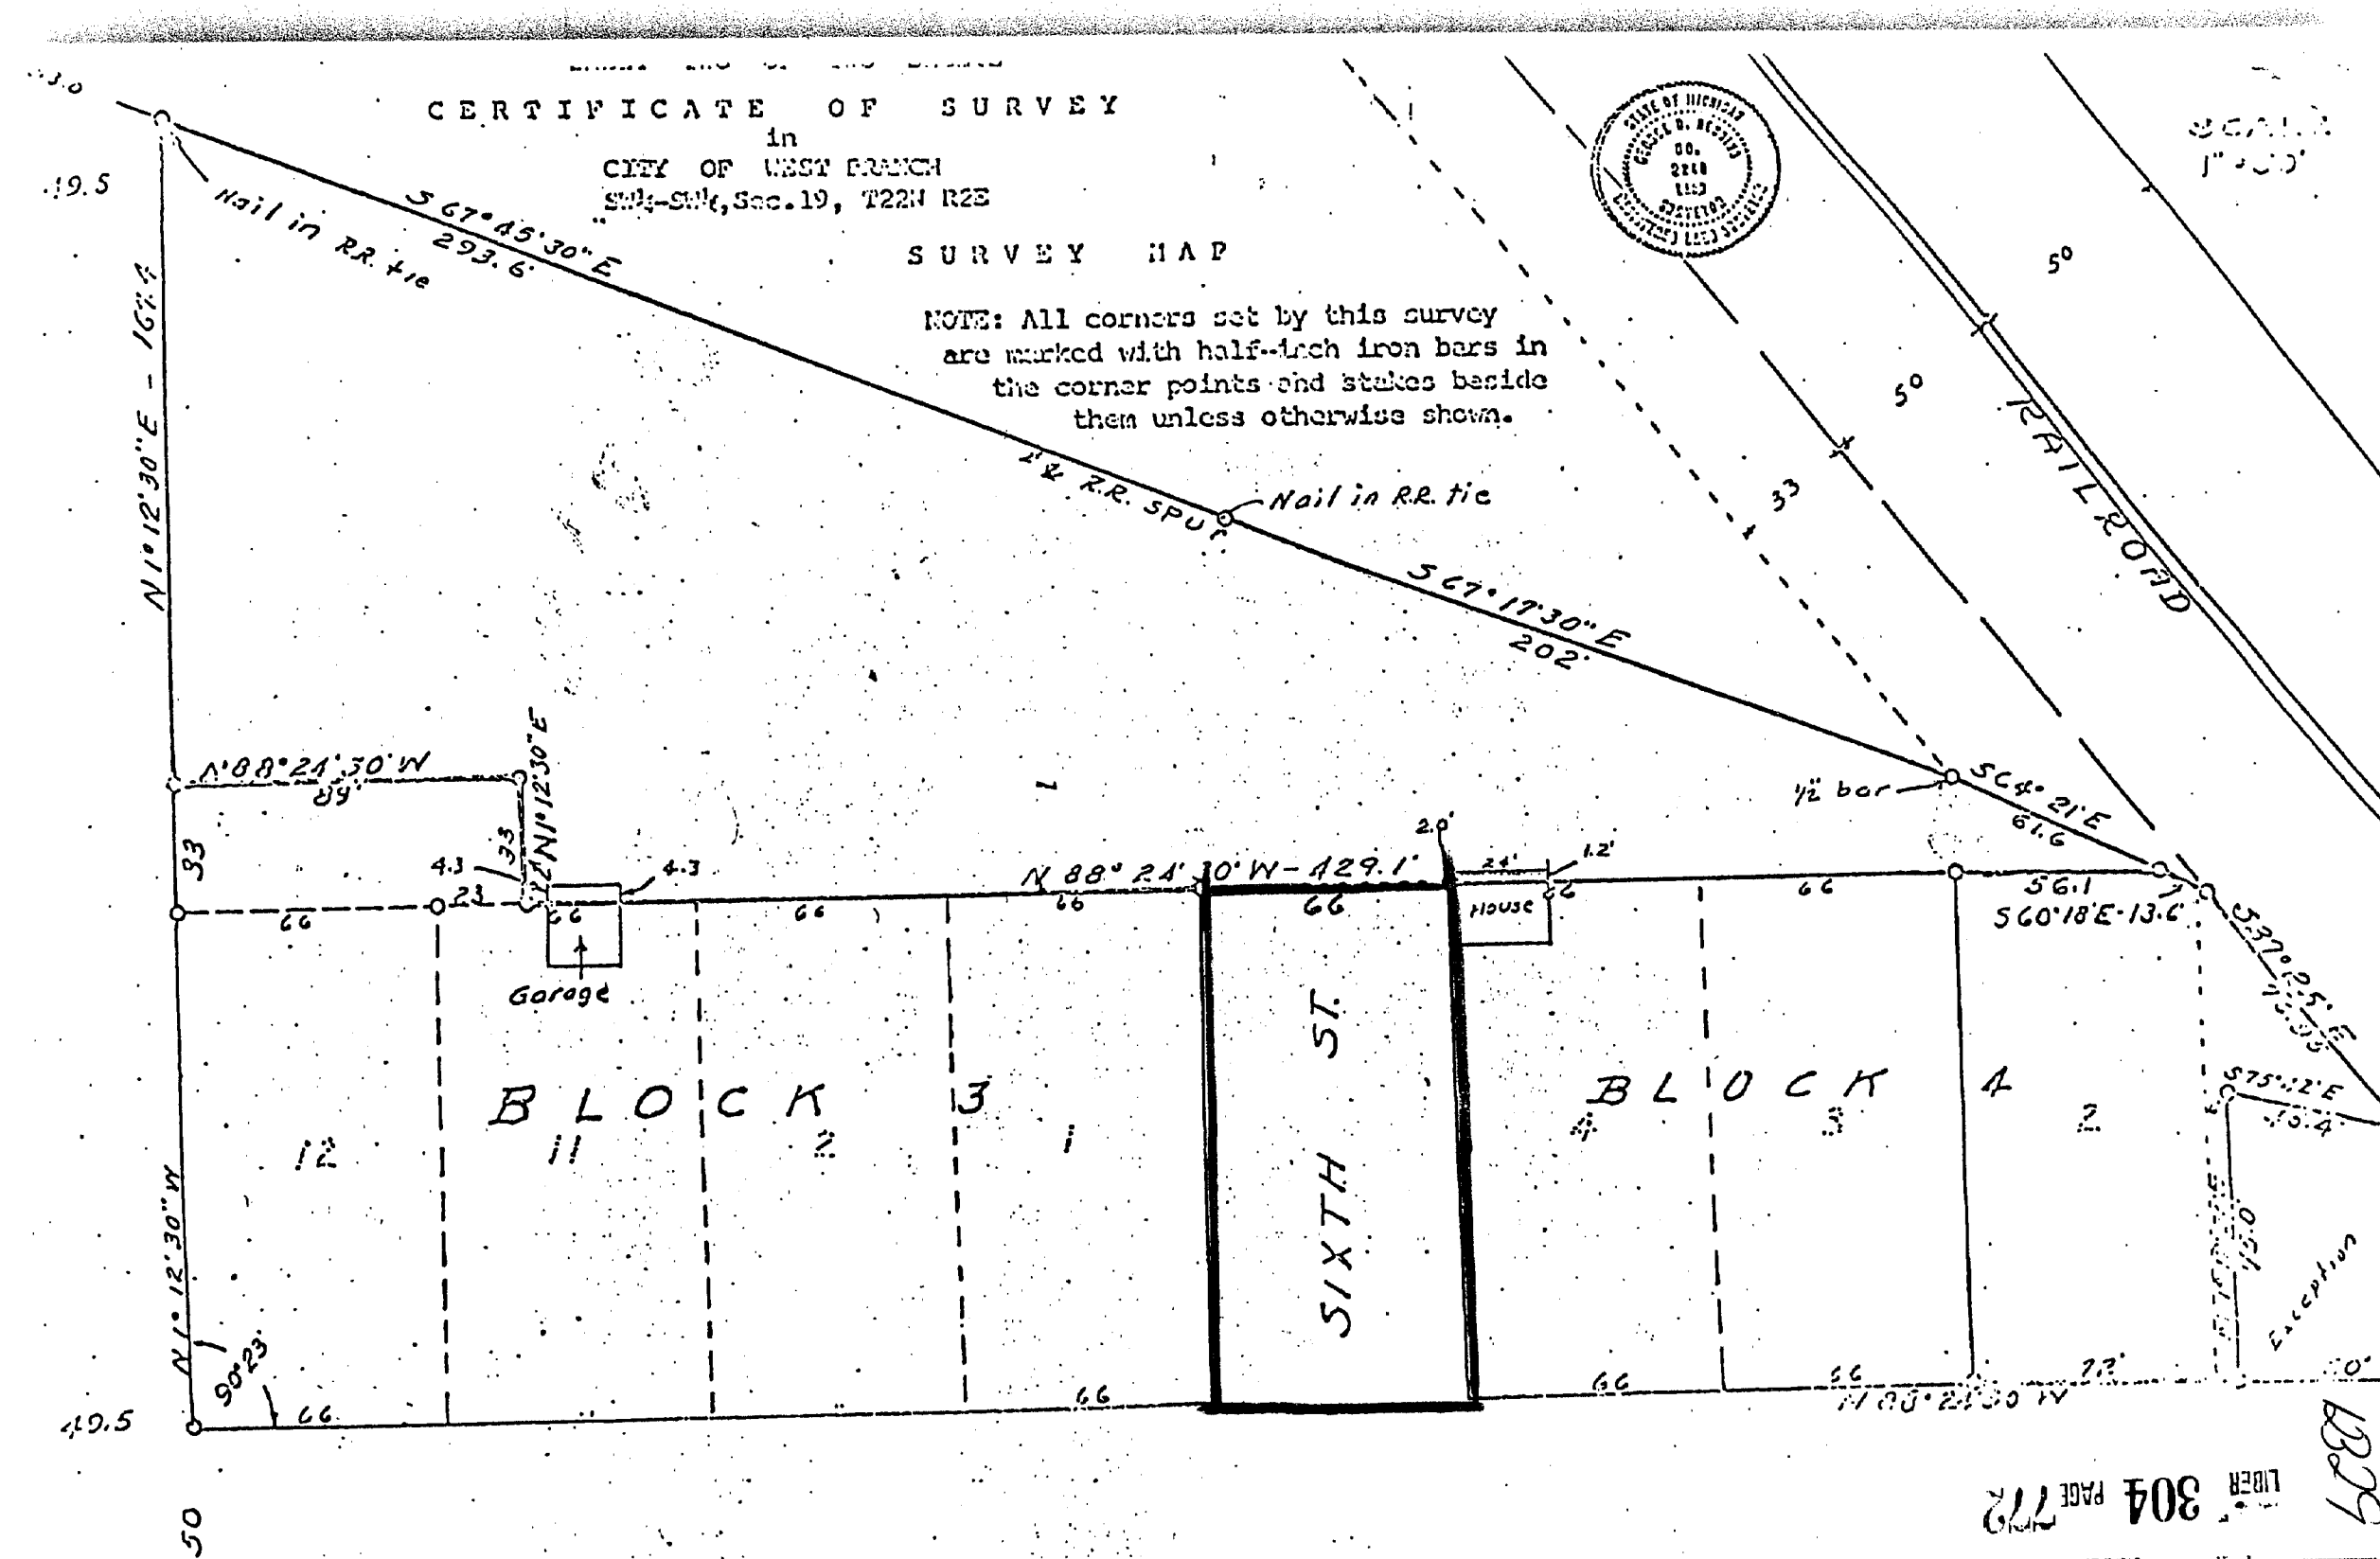

County of Tonn Plats and in creating the same in certain cases and the acts and
acts thereto and for the purpose of being recorded as an addition to the village of West
Branch situated in the South West quarter of the East West quarter of Section Nineteen (19)
Tonn Township Tonn County Tonn State of Michigan
The size of the lots and the width of the streets are given in feet and hundredths of
feet
In witness whereof we have hereunto set our hands and seals this Fifth day of November
A.D. 1911
Signed and sealed
in presence of
Notary Public
State of Michigan ss
County of Tonn
On Fifth day of November A.D. 1911 before me a Notary Public personally
came the above named Robert H. Weidmann and George H. Weidmann and the said
and who being known to me to be the persons who executed the above and who each acknowl-
edged the execution of the same for the purposes therein expressed

RAILROAD COMPANY
SECOND
TO ADDITION
THE
VILLAGE PLAT
OF
WEST BRANCH

Robert H. Weidmann
George H. Weidmann
We do hereby certify that in view of the above and the annexed plat of the
village of West Branch in Tonn Township Tonn County Michigan
and that it is an exact duplicate of the original of such plat of West
Branch
Notary Public
State of Michigan
County of Tonn

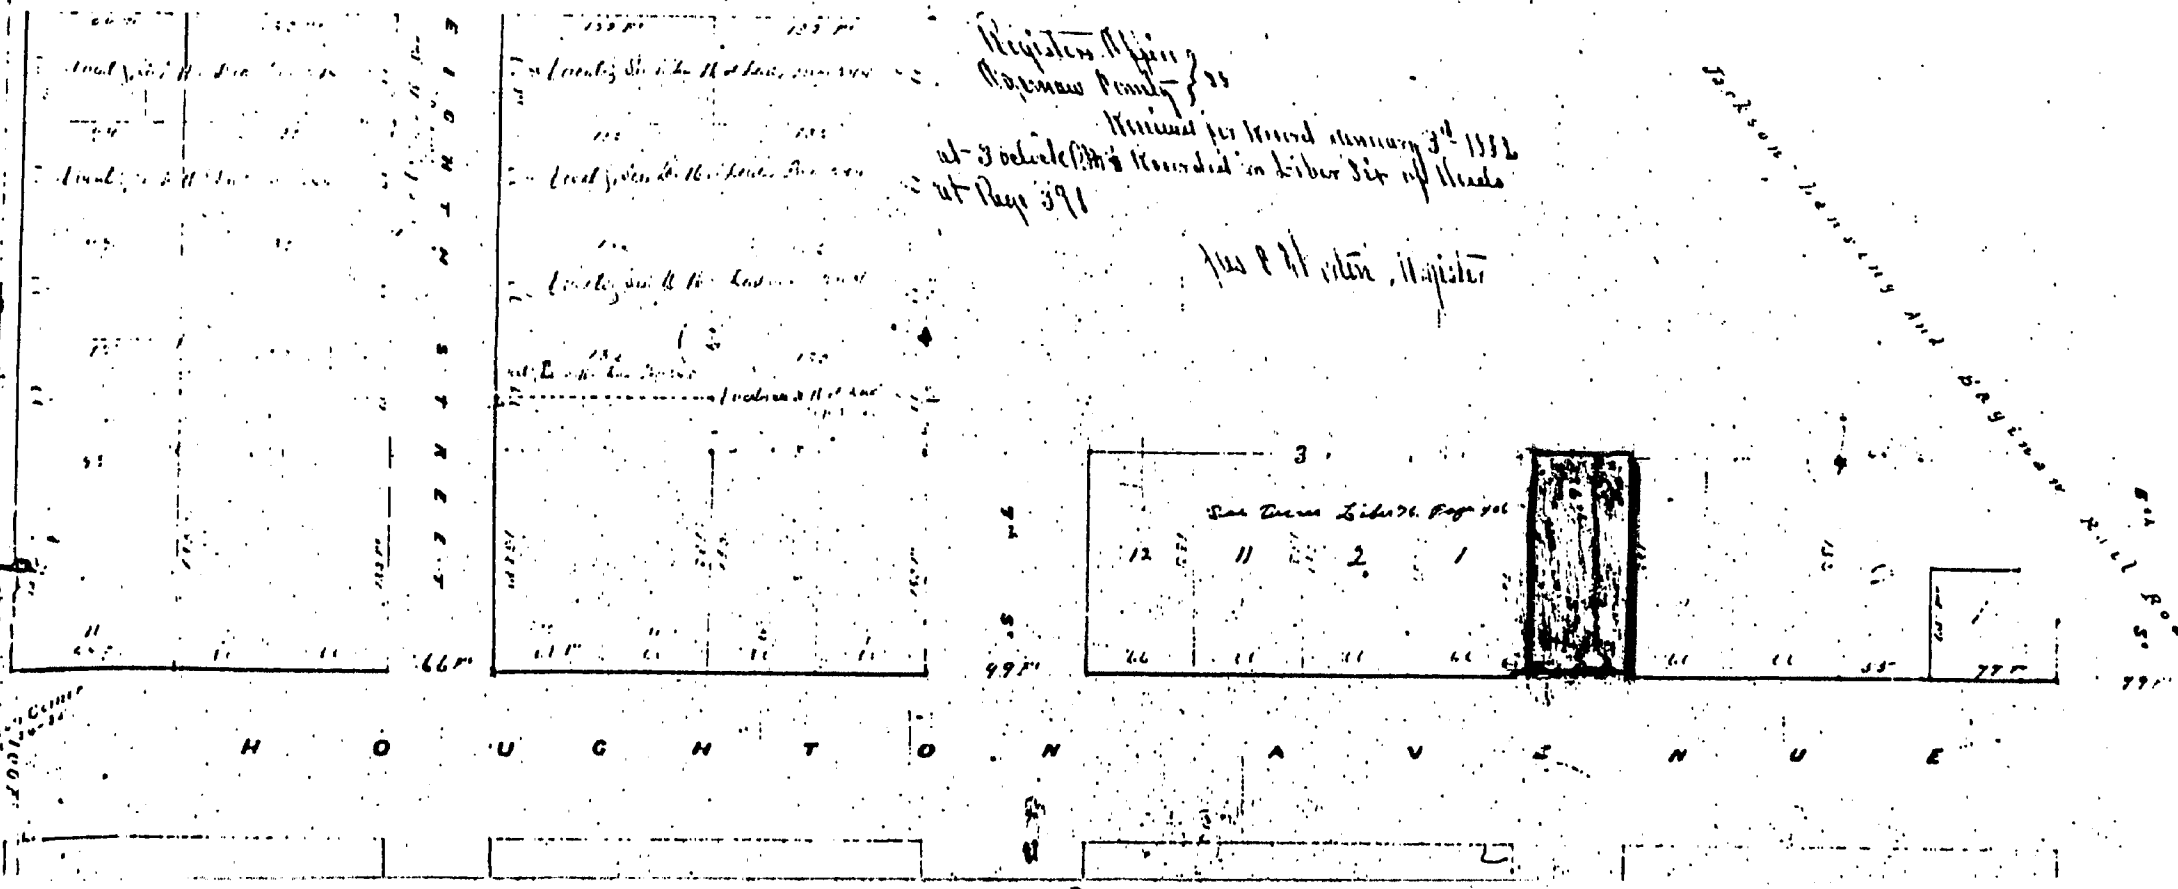

LIBER 304 PAGE 712
19389