

Map of LARKE'S Addition

To the Plat of the

VILLAGE of ROGERS

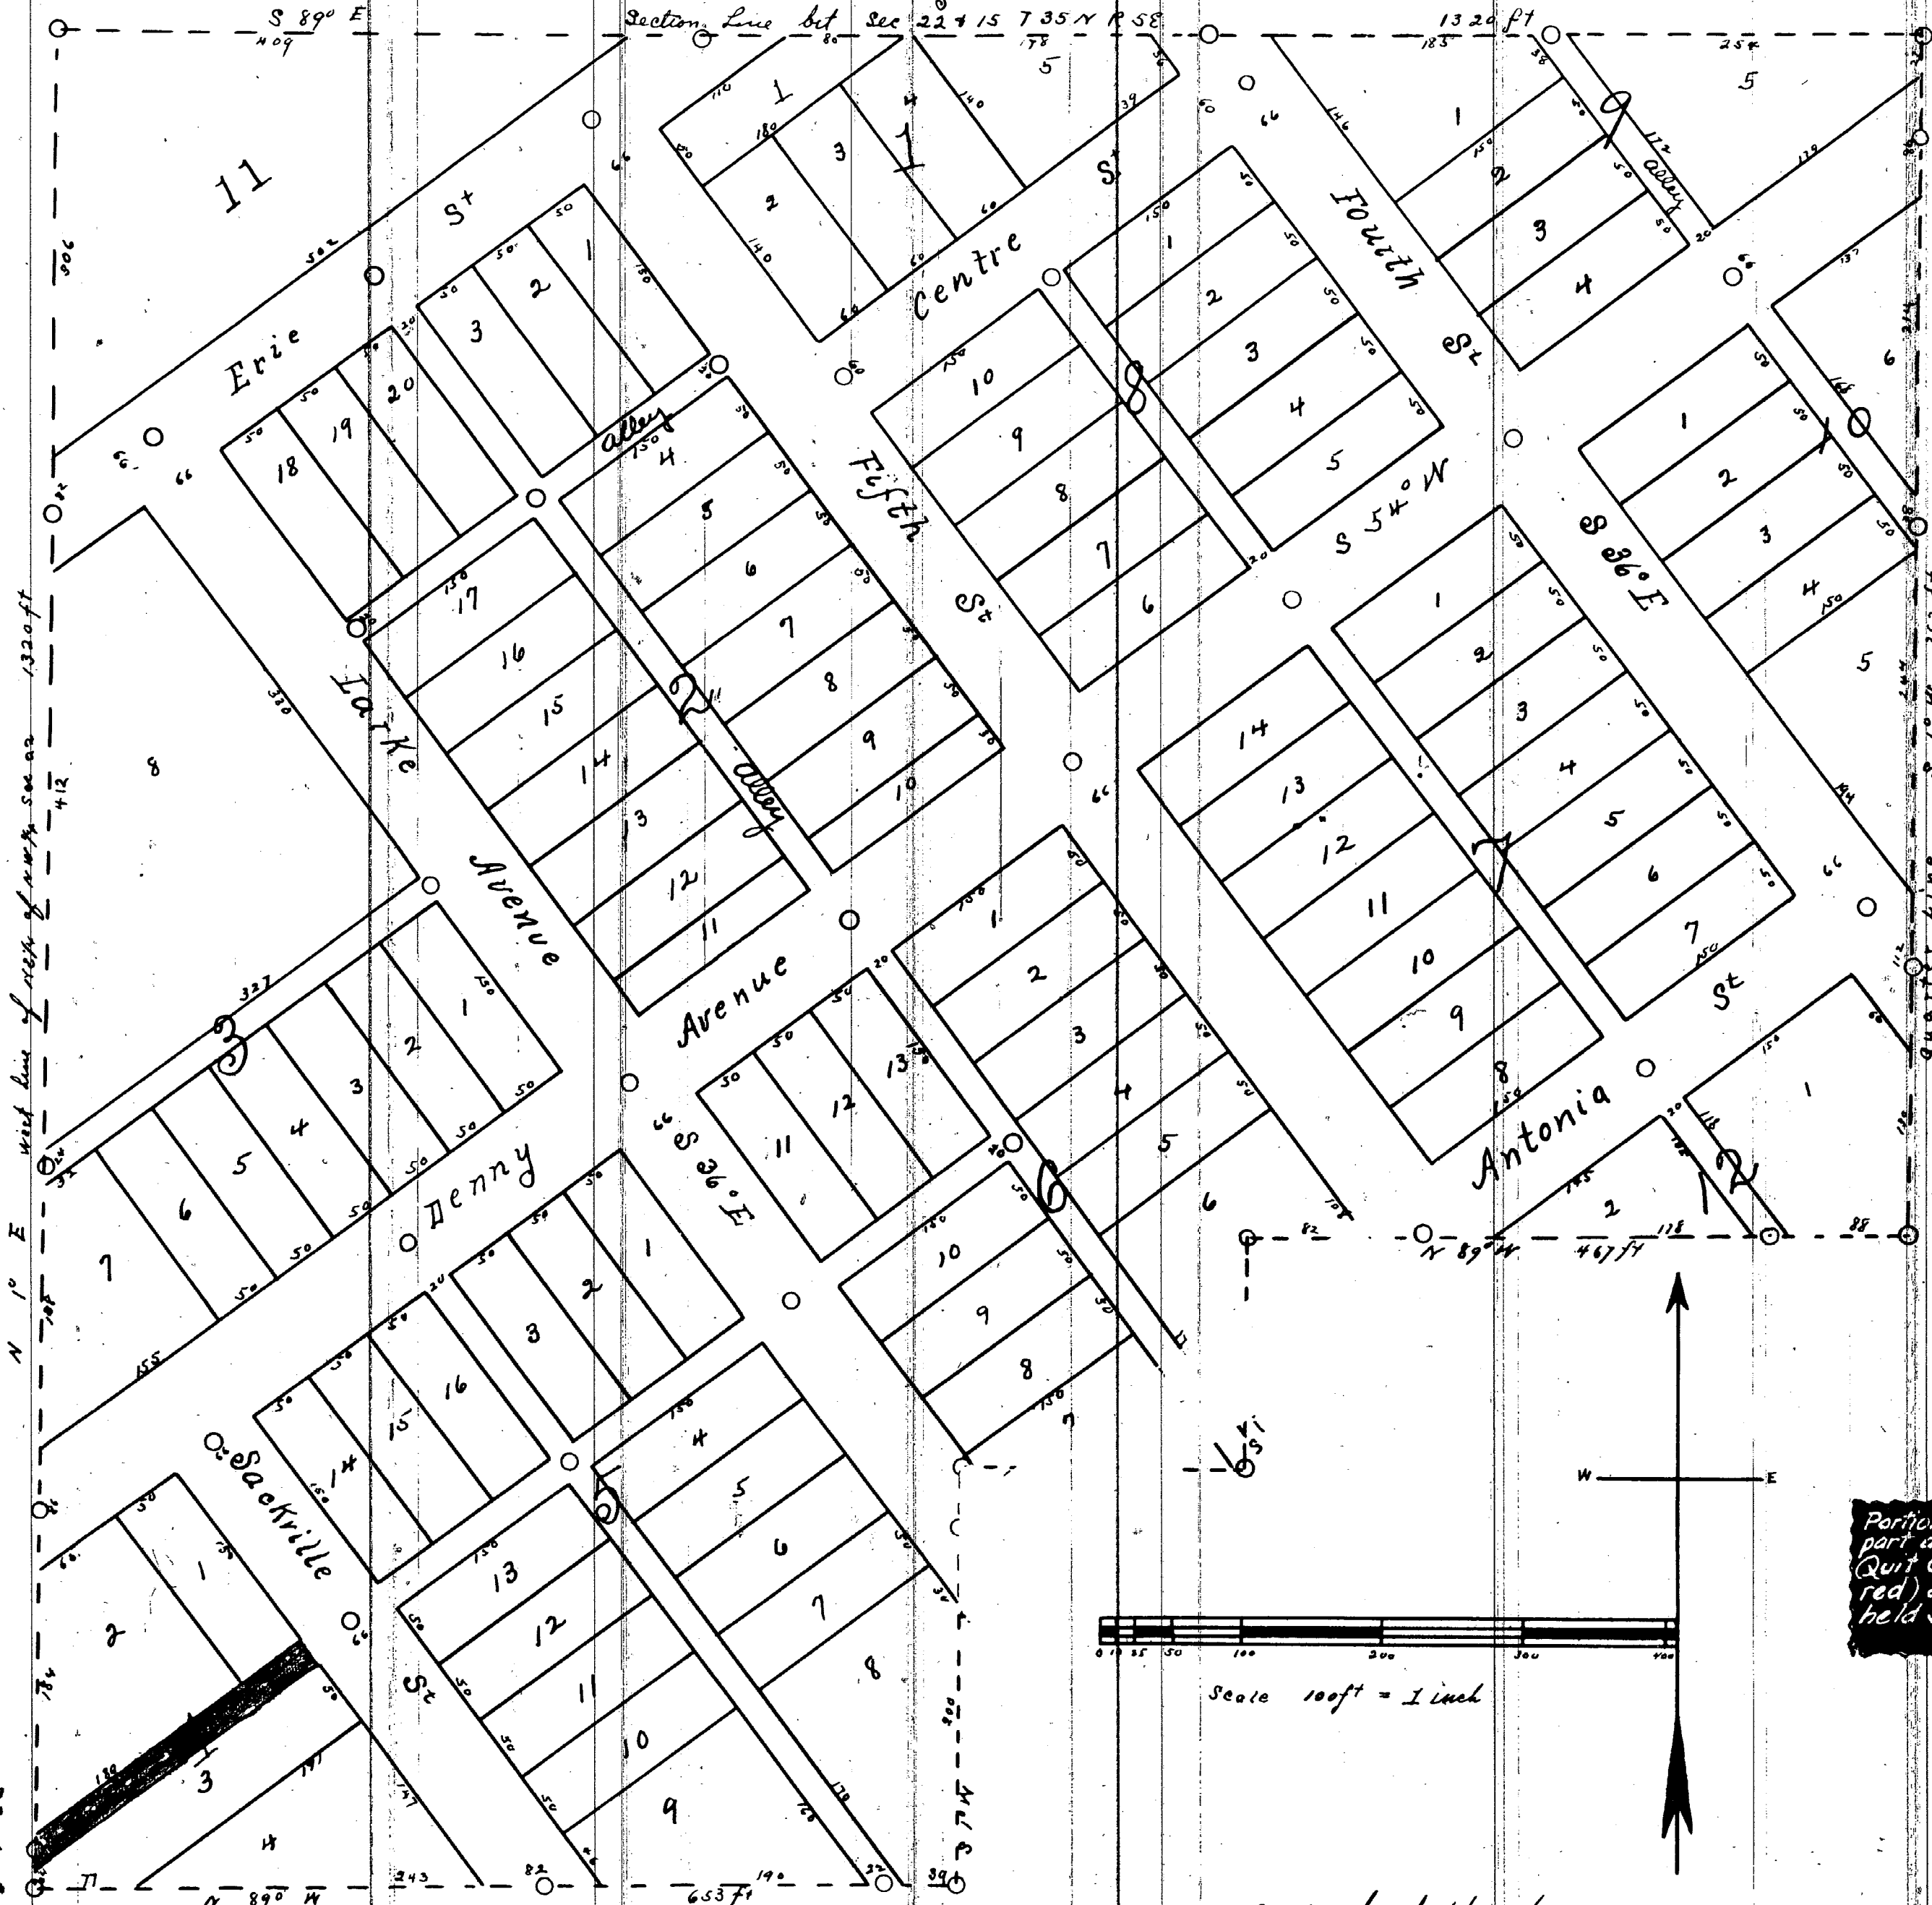
Presque Isle County Michigan

Surveyed June AD 1889

By Paul Comerin C.E.

22 1/2 15 7 35 N P 58

13 20 ft

Place of Beginning
1/4 Section 15

Portion of Plat and unplatted
part acquired by Village by
Quit Claim Deed (shown in
red) accepted at a meeting
held July 1, 1936.
V893-36

Examined and Approved
August 31, 1889R. R. Pratt
Deputy Auditor GeneralRegister Office
Presque Isle CountyReceived for Record the seventh day of September 1889
at 10 A.M.Charles Platy
Register

I hereby certify that this Plat is a correct copy of the Plat now on Record
in the Register of Deeds Office, being made under the supervision of the
Auditor General by tracing the Plat on Record and affixing thereto a
carefully compared copy of the Dedication and Certificate.

Dated the 14th day of September 1911

Attn. B. J. Hurd.

Clerk, And Gen. Hurd

Know all men by these presents that Augustus Larke as proprietor has caused
the land embraced in the unrecorded Plat to be surveyed, laid out and platted to be known as Larke's
Addition to the Village of Rogers, and that the streets and alleys as shown on said plat are
hereby dedicated to the use of the public.
Signed and sealed in presence of
Paul H. Hurd
Notary Public

State of Michigan
County of Presque Isle

On this 24th day of July 1889 before me a Notary Public in
and for said County personally came the above named Augustus Larke known to me to be the per-
son who executed the above dedication and acknowledged the same to be his free act and deed.
Henry Platy
Notary Public Presque Isle Co. Mich.

The land embraced in the unrecorded Plat of Larke's Addition to the Village of Rogers is described as follows.
Commencing at the 1/4 stake between Sections 15 and 16 T. 35 N. R. 5 E. Thence S. 1/2 W. 553 feet Thence N. 89° 11' W. 467 feet Thence S. 1/2 W.
157 feet Thence N. 89° 11' W. 314 feet Thence N. 89° 11' W. 553 feet Thence N. 10° E. 1320 feet Thence S. 89° 11' E. 1320 feet to
Place of Beginning. I hereby certify that the plat herein delineated is a correct one and that perma-
nent monuments consisting of cedar stakes 3" x 3" x 36" long have been planted at points marked thus O as
thereon shown at all angles in the boundaries of the land platted and at all intersections of streets and
alleys.

Paul Comerin Surveyor.

CITY Council
3-16-55
301-55