


A 32m

Big Rapids
Youthson's Addition

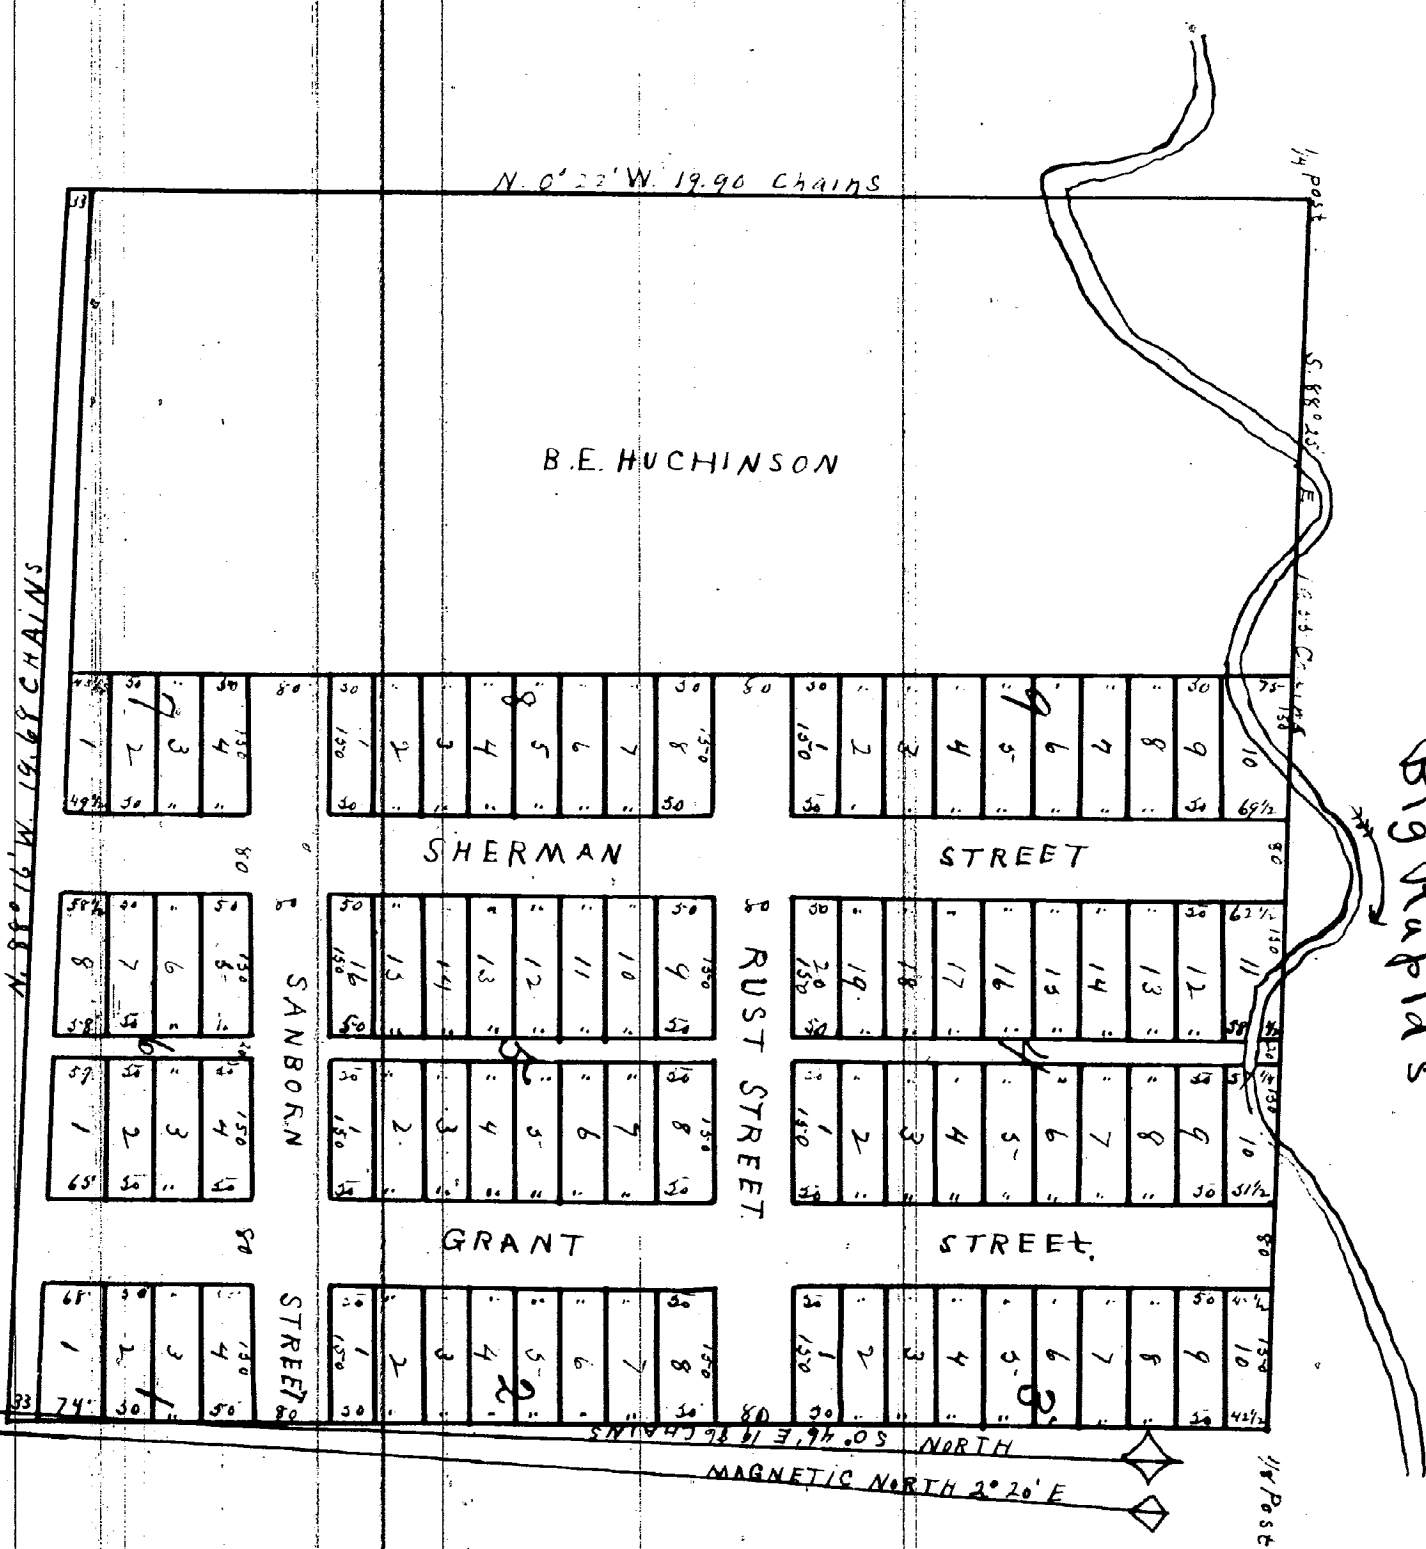

SANBORN + RUST'S Addition

Recd and filed Nov 5, 1867
James W. Leach, Reg

Kindly certify that this plot is a correct copy of
The plot now on record in the Registry of Duke
ofine. Some made under the supervision of the
Auditor General by having the plot on record
and signing that a carefully compared copy of
the ~~dedication~~ and certificate.

Dated This 7th day of Aug. 1911

John Robinson

Blank Aud. Gen. Dept.

State of Michigan } ss: I, Theodore W. Rostine, a Surveyor and Civil En-
gineer of Michigan }
do declare and acknowledge before E. W. Rice, a Notary Public for
said County, that at the request of D. E. Hutchinson of Big Rapids
Michigan. I surveyed apart of the N. W. 1/4 of the N. E. 1/4 of Section
14 Town 46 N. Range 2 East that is and lots of Mich-
igan off into Blocks and lots for the purpose of making of the
same an addition to the Village of "Big Rapids in said County
which addition is as known as Hutchinsons Addition to Big
Rapids" and that the within diagram is a true and correct map
of Plot of said Addition. Witness my hand this 31st day of
October - A. D. 1867,
Theodore W. Rostine
Surveyor & Civil Engineer

Microle County } 200.

On the 31st day of October A. D. 1867

before me E. W. Rose a Notary Public in and for said County personally came Theodore W. Robbins to me known to be the person who executed the above acknowledgment and acknowledged that he made and executed the same for the purposes therein stated

E. D. Wood

Notary Public

State of Michigan } ss On this 31st day of October A. D. 1867
County of Macomb }
before me E. W. Rice a Notary Public in and for said County
personally came B. Eliot Hutchinson of Big Rapids, in said
County, and voluntarily declared and stated that of his
own accord he desired a land Engineer and Surveyor sur-
veyed off a part of the T. W. 1/4 of the T. E. 1/4 of Section 15. T. 15. N. R. 10 W.
in the State of Michigan into Blocks and lots, for the purpose
of making the same an Addition to the Village of Big Rapids
in said County to be known as "Hutchinsons Addition to Big
Rapids" and that he the said Hutchinson, District Surveyor thereof de-
sires the same for such an addition to be known by the name
aforesaid
In presence of
E. W. Rice
B. E. Hutchinson Registrar

Subscribed and acknowledged
before me the day and year above
mentioned.

E D Pico, Notary Public.

Seed

A Plan of Hutchinson's Addition to Big Rapids

PART II

Big Rapids Mich Oct 31st 1867.
On this 31st day of October 1867 before me E. O. Rose Notary Public for the County of Mecosta State of Michigan personally appeared Thos. W. Robbins to me well known and being by me duly sworn doth depose and say that he is a duly appointed deputy surveyor for the County of Mecosta and State of Michigan and that at the request of E. E. Hutchinson the Proprietor thereof he did make the survey of the following described Addition which is to be known as "Hutchinson's Addition to Big Rapids" that this Addition is located upon the N. W. 1/4 of the N. E. 1/4 of Sec. 15, T. 15 N. R. 10 W. (Township of Michigan) and is bounded and described as follows viz:

Beginning at a Stake in the 1/2 line running E 4 3/4 W 1/4 through the N. E. 1/4 of said Sec. 15, at a point half way between the 1/2 Post on the E. side of the 1/2 line of the 15 and the intersection of the 7 1/2 N. and E. W. lines of the same. Thence N. 0° 46' W. true 19.81 chains to the 1/2 Post on the N. side of said N. E. 1/4 of Sec. 15. Thence along the N. side of said Sec. 15 N. 88° 25' W. 11.82 3/4 chains to a Stake. Thence N. 0° 46' E. 19.88 1/2 chs to a Stake in the E. W. 1/2 line of the N. E. 1/4 of said sec. 15. Thence N. 88° 16' E. 11.82 3/4 chs along the said E. W. 1/2 line to the place of beginning, and that "Addition" contains 23 1/2 Acres "to the same more or less."

The plan on which the Streets, Alleys, Blocks & Lots are laid out in said Addition is described as follows viz: (See attached Plan of Hutchinson's Addition to Big Rapids.) Grant and Sherman Streets are parallel to the E. side of said Addition; Sanborn and Rush Streets are at Right angles to the same each of the above named Streets are 80 feet in width. The center line of Grant Street is distant 190 feet W. by from the E. side of said Addition. The distance from center to center of Grant and Sherman Streets in a direction at right angles to the E. side of said Addition is 400 feet. The center line of Sanborn Street intersects the E. side of said Addition at a point 397 feet from the N. E. corner of the same. The center line of Rush Street intersects the E. side of said Addition 488 - 7/4 from the center of Sanborn Street. The south side of said Addition is the center line of a Public Highway of 66 feet width.

The center line of a 20 feet wide Alley, is midway of the center line of Grant and Sherman Streets.

Fractional Block No. 1 is in the N. E. cor of said Addition and is bounded N. by Sanborn Street. East by the E. side of said Addition - south by a 66 feet wide public (Highway) road and West by Grant St. Said Block is 23 1/4 feet on the E. side of said Addition and

118 feet on Grant St. by 130 feet in width E. & W. The lots numbered 2, 3, 4, in said Block are each of 150 feet length E. & W. by 50 feet wide N. & S. 1/4. Lot No. 1 in said Block is 150 feet E. & W. by 60 feet front on Grant St. and 74 feet wide on the E. side of said Addition.

Fractional Block No. 2 lies next north of Block No. 1 and is bounded on the N. by Rush Street; East by the E. line of said Addition. N. by Sanborn Street and West by Grant Street; and is four hundred feet in length N. & S. by 100 feet width E. & W. - all the 8 lots in said Block are full lots of 150 feet length. E. & W. by 50 feet width N. & S. Fractional Block No. 3 is bounded N. by the N. side of said Addition; E. by the East side of the same south by Rush Street and W. by Grant Street.

The lots numbered (on the Plan) from 1 to 9 inclusive amount 150 feet length E. & W. by 50 feet wide N. & S. Lot No. 10 is 150 feet long E. & W. by 48 1/2 feet wide at its West end (on Grant Street) and 42 1/2 feet wide at its E. end.

Fractional Block No. 4 is bounded north by the N. side of said Addition; E. by Grant Street N. by Rush Street and W. by Sherman Street. A twenty foot wide Alley runs N. & S. through the middle of said Block and all the lots except the lots numbered 10 & 11 are full lots of 150 feet length E. & W. by 50 width N. & S. fronting rear. Lot numbered 10 in said Block is 51 1/2 feet front on Grant St. by 57 1/2 feet in the rear (on the Alley). Lot number 11 is 67 feet front on Sherman St. by 58 1/2 feet rear on the alley.

Full Block No. 5 is bounded on the N. by Rush Street E. by Grant St. N. by Sanborn St. & W. by Sherman Street. Lots each 150 feet E. & W. by 50 front and rear. A twenty-foot-wide Alley divides the Block into two equal E. & W. divisions.

Fractional Block 6 is bounded N. by Sanborn Street E. by Grant Street N. by Public Road or Highway - W. by Sherman St. All the lots in said Block except those numbered 1 and 8 are full lots of 150 feet length E. & W. by 50 ft front and rear.

Lot numbered 8 has 52 1/2 feet front on Sherman St. by 58 1/2 feet rear and is 150 feet length E. & W. lot numbered 1 has 65 feet front on Grant Street by 59 feet rear and is 150 feet length E. & W. The 20 feet wide Alley, running through Block 4 & 5 continues through fractional Block 6.

Fractional Block No. 7 is in the S. W. corner of the Addition and is bounded N. by Sanborn St. E. by Sherman Street N. by the Highway and W. by the W. side of said Addition. Lots 2, 3 & 4 are full lots 150 feet length E. & W. by 50 feet front & rear. Lot No. 1 is 43 1/2 feet wide on the W. line of said Addition and 49 feet wide on Sherman St.

Fractional Block 8 is bounded on the N. by Rush St. E. by Sherman Street. N. by Sanborn Street and W. by the W. side of said Addition

1177
The 1/2 Post on the E. side of said Sec 15 was designated or marked by the Proprietor of the western bounded Addition viz E. E. Hutchinson, by a Stake in the E. side of said Sec 15, at a point half way between the 1/2 Post on the E. side of the 15 and the intersection of the 7 1/2 N. and E. W. lines of the same. Thence N. 0° 46' W. true 19.81 chains to the 1/2 Post on the N. side of said N. E. 1/4 of Sec. 15. Thence along the N. side of said Sec. 15 N. 88° 25' W. 11.82 3/4 chains to a Stake. Thence N. 0° 46' E. 19.88 1/2 chs to a Stake in the E. W. 1/2 line of the N. E. 1/4 of said sec. 15. Thence N. 88° 16' E. 11.82 3/4 chs along the said E. W. 1/2 line to the place of beginning, and that "Addition" contains 23 1/2 Acres "to the same more or less."

1178
The plan on which the Streets, Alleys, Blocks & Lots are laid out in said Addition is described as follows viz: (See attached Plan of Hutchinson's Addition to Big Rapids.) Grant and Sherman Streets are parallel to the E. side of said Addition; Sanborn and Rush Streets are at Right angles to the same each of the above named Streets are 80 feet in width. The center line of Grant Street is distant 190 feet W. by from the E. side of said Addition. The distance from center to center of Grant and Sherman Streets in a direction at right angles to the E. side of said Addition is 400 feet. The center line of Sanborn Street intersects the E. side of said Addition at a point 397 feet from the N. E. corner of the same. The center line of Rush Street intersects the E. side of said Addition 488 - 7/4 from the center of Sanborn Street. The south side of said Addition is the center line of a Public Highway of 66 feet width.

Meosfor

12375

RESOLUTION NO. 1765

RESOLVED BY THE CITY COMMISSION OF THE CITY OF BIG RAPIDS, that

WHEREAS, the City of Big Rapids deems it advisable to vacate the alley in Blk. 4 Hutchinson Addition, said alley extending from Rust Avenue North to the end thereof between Hutchinson and Escott Streets

WHEREAS, the interests of the City of Big Rapids require the vacation of said alley

NOW, THEREFORE, BE IT RESOLVED BY the City Commission in and for the City of Big Rapids, Michigan as follows:

I

That said alley be and hereby is vacated subject to the right of the City of Big Rapids to use said vacated alley for storm and sanitary sewers and water mains and also subject to the right of any public utility using said vacated alley for such pole line or pipe line easements as said public utility would need for electric, telephone or gas service in the City of Big Rapids, Michigan.

II

That on the 7th day of April 1964, the City Commission in and for the City of Big Rapids, Michigan will meet at the City Hall in said City at 8:00 o'clock P.M. and hear any objections thereto.

III

That the Clerk cause a notice of such meeting, together with a copy of this resolution, to be published in the Big Rapids Evening for not less than four (4) consecutive weeks before the 7th day of April 1964.

IV

That objections to such proposed action by the City Commission shall be filed with the City Clerk in writing on or before 12:00 noon on the 2nd day of April 1964; and

V

That the vacation of said alley shall become effective on the 7th day of April 1964 unless a resolution to the contrary be made on said date by said City Commission and duly filed with said City Clerk.

Commissioner Lydell moved, supported by Commissioner Nelson its adoption.

Yeas: Unanimous

Nays: None

Dated: March 2, 1964

Published: March 7, 1964


I hereby certify that the foregoing is a true and complete copy of a Resolution of the City of Big Rapids duly adopted at a regular meeting of the City Commission of said City held on March 2, 1964 and that no petition of objection appeared at the hearing thereon.

I further certify that said Resolution has been recorded in the Minutes Book of the City of Big Rapids and that such recording has been authenticated by the signature of the Mayor and the City Clerk

April 13, 1964

1963 303 MAR 183

Ronald B. Clark
City Clerk

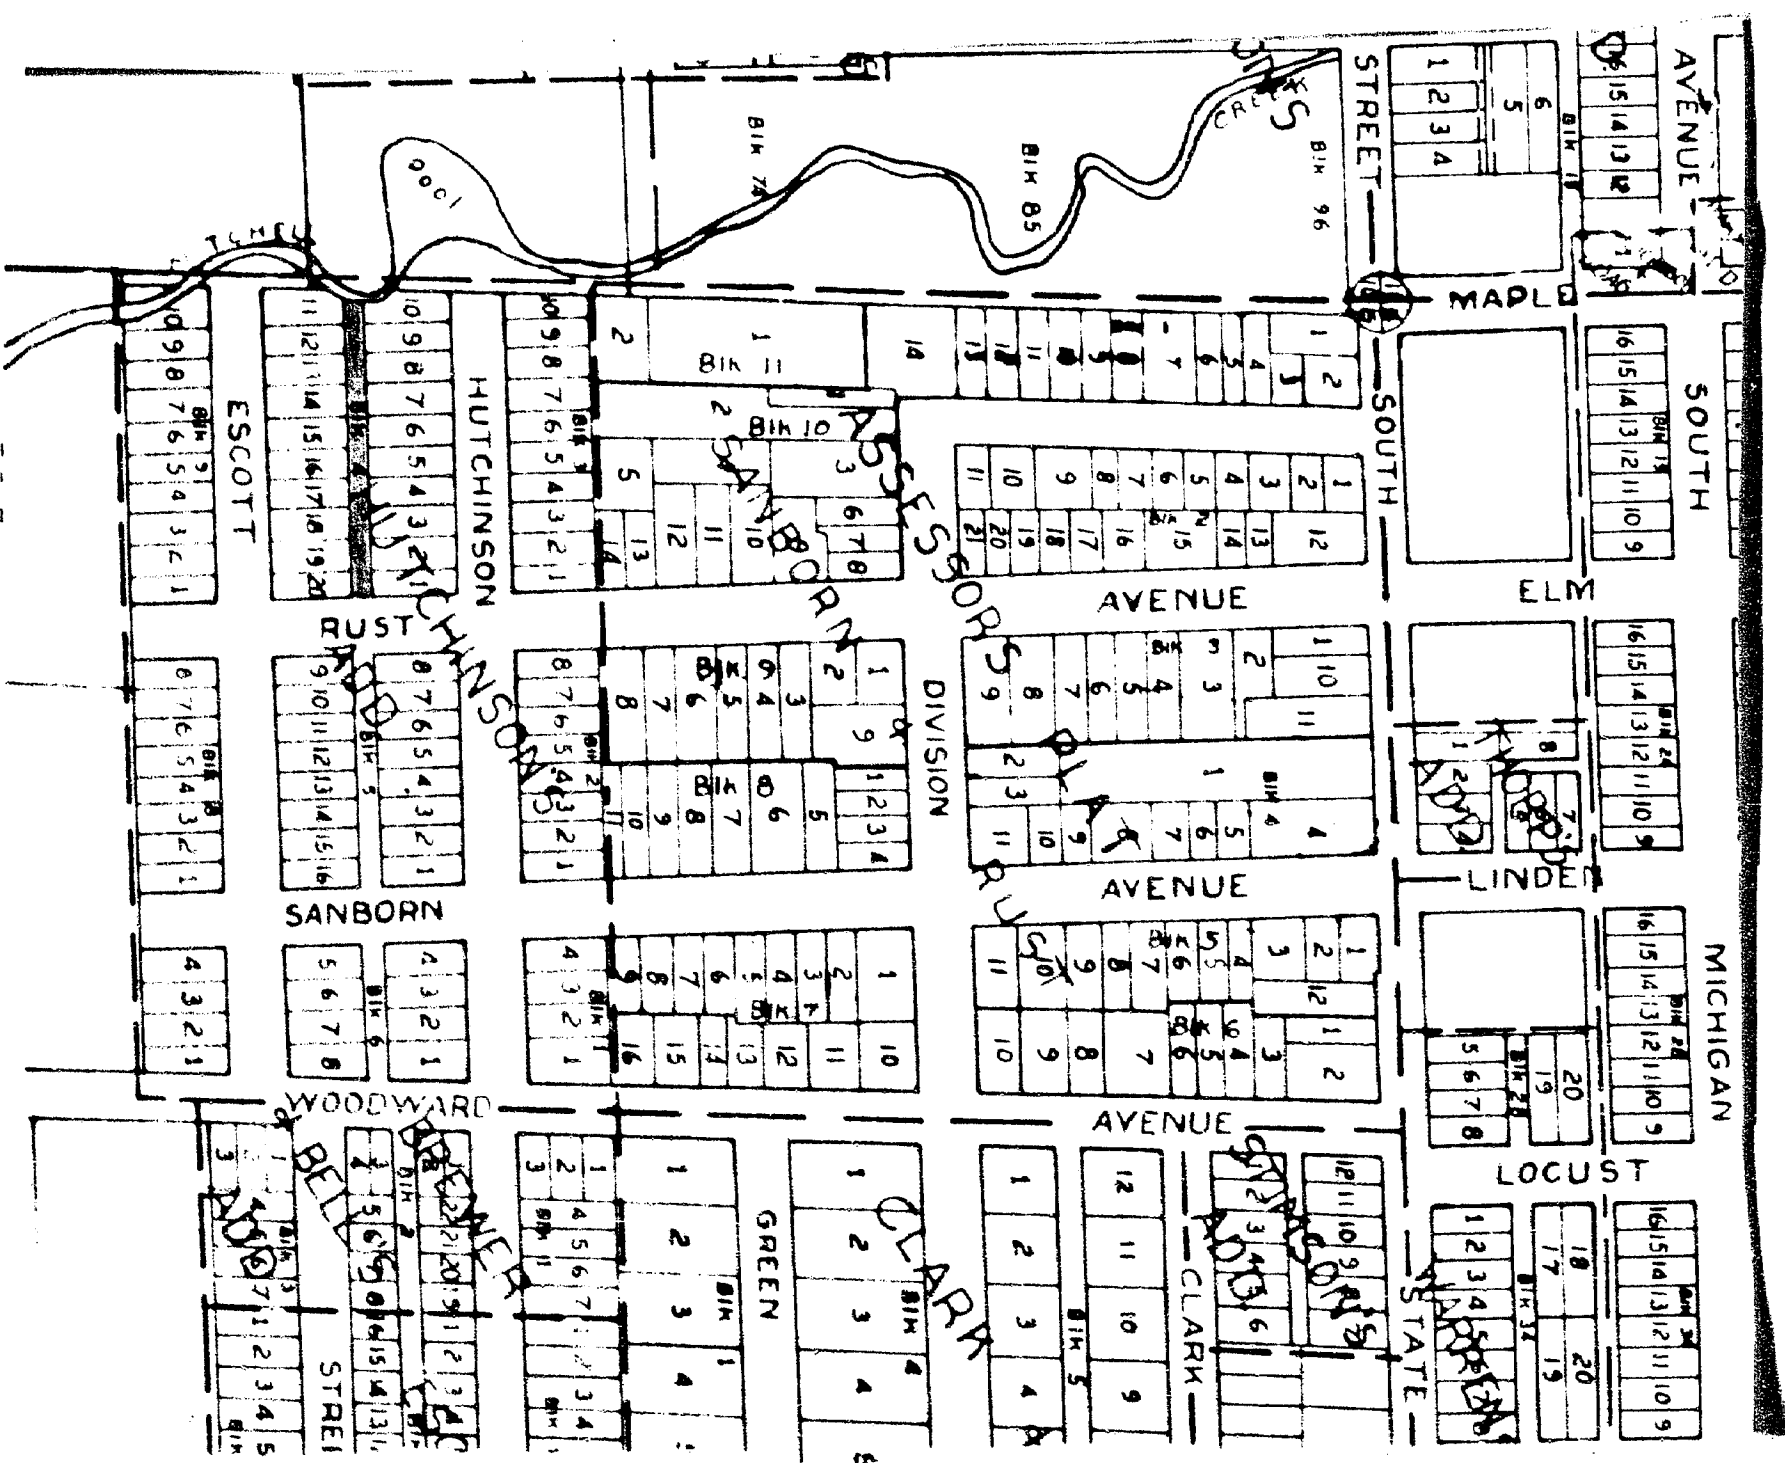

RESOLUTION NO. 3673

RESOLVED BY THE CITY COMMISSION OF THE CITY OF BIG RAPIDS, that

WHEREAS, the City of Big Rapids deems it advisable to vacate that portion of the Alley more particularly described as follows:

The Alley in Block 6 of Hutchinson Addition between the South line of Sanborn Avenue and the North line of Woodward Avenue.

WHEREAS, the interests of the City of Big Rapids require the vacation of said Alley.

NOW, THEREFORE, BE IT RESOLVED by the City Commission in and for the City of Big Rapids, Michigan, as follows:

I

That said Alley be and hereby is vacated, subject to the rights of the City of Big Rapids to use said vacated part of said Alley for storm and sanitary sewers and water mains and also subject to the right of any public utility using said vacated Alley for such pole line or pipe line easements as said public utility would need for electric, telephone or gas service in the City of Big Rapids, Michigan.

II

That on the 19th day of May 1969, the City Commission will meet at the City Hall at 8:00 o'clock p.m. and hear any objections thereto.

III

That the Clerk cause a notice of such meeting, together with a copy of this resolution, to be published in the PIONEER for not less than four (4) consecutive weeks before the 19th day of May 1969.

IV

That objections to such proposed action by the City Commission shall be filed with the City Clerk in writing, on or before 12:00 noon on the 15th day of May 1969; and

V

That the vacation of said Alley shall become effective on the 21st day of April 1969 unless a resolution to the contrary be made on said date by said City Commission and duly filed with said City Clerk.

Commissioner Fairman moved, supported by Commissioner White its adoption.

Yeas: Unanimous

Nays: None

RESOLUTION DECLARED ADOPTED

Date: April 21, 1969

I hereby certify that the foregoing is a true and complete copy of a resolution of the City of Big Rapids duly adopted at a regular meeting of the City Commission of said City held on April 21, 1969.

I further certify that said resolution has been recorded in the Minute Book of the City of Big Rapids and that such recording has been authenticated by the signatures of the Mayor and the City Clerk.

September 18, 1969


Walter E. Richardson
Walter E. Richardson, City Clerk

Hutchinson

ESCOTT STREET

SANBORN STREET

HUTCHINSON STREET

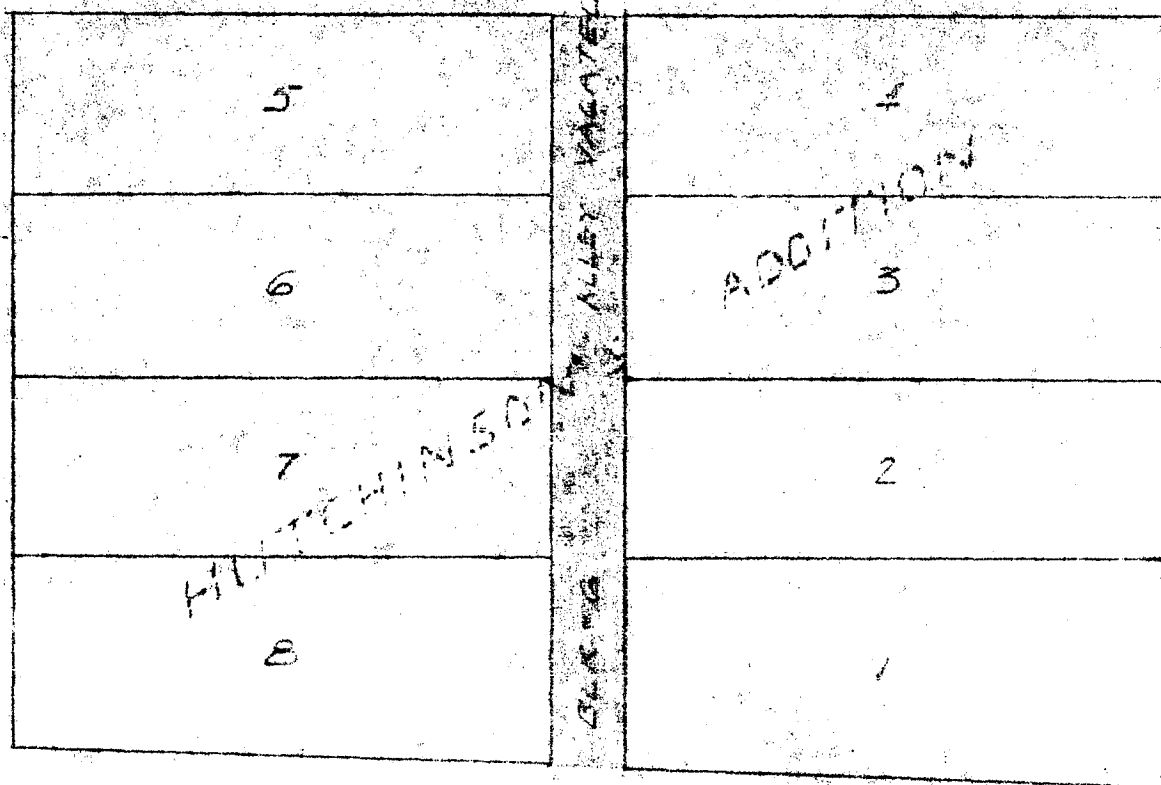

WOODWARD AVE.

SCALE 1" = 60'



CITY OF BIG RAPIDS
ENGINEERING DEPT.
ALLEY IN BLOCK 6
VACATED APRIL 21, 1969
BY RESOLUTION NO. 3673

DRAWN BY: RLK JUNE 16, 1969