

There are men by these streets that are, Allen M. Bosworth and James D. Bosworth, Charles A. Baber and Martha C. Baber his wife and Fred O. Baber as proprietors have caused the land embraced in the annexed plat to be surveyed, laid out and platted to be known as Allen M. Bosworth's Subdivision on the S.E. corner of section nine north of R. 18 Wayne County Michigan and that the whole be and is shown on said plat to be hereby dedicated to the use of the public.

Witness my hand and seal in presence of
 Deputy M. Wilmouth
 Sheriff of Jackson
 Allen M. Bosworth
 James D. Bosworth
 Charles A. Baber
 Martha C. Baber
 Fred O. Baber

Allen M. Bosworth
 James D. Bosworth
 Charles A. Baber
 Martha C. Baber
 Fred O. Baber

State of Michigan } ss. On this 1st day of June A.D. 1901 before me a County Judge of Wayne County, Michigan, duly sworn and qualified in and for said County, personally appeared the said James D. Bosworth, Charles A. Baber and Martha C. Baber his wife, all of whom are known to me to be the persons who executed the above dedication and acknowledged the same to be their free act and deed.

Myself M. Wilmouth
 Notary Public in and for
 Wayne County, Michigan.

State of Michigan } ss. We, M. A. Macdonald, Secy. Register of Deeds of Wayne County, Michigan, do hereby certify that we have carefully compared the annexed copy with the plat of Allen M. Bosworth's Subdivision on the S.E. corner of section nine north of R. 18 Wayne County Michigan, and that the same is a true and correct copy of the same as the same appears on the books of said Register of Deeds.


M. A. Macdonald, Secy. Register of Deeds.
 A. H. Wilmouth, Deputy

State of Michigan } ss. We, M. A. Macdonald, Secy. Register of Deeds of Wayne County, Michigan, do hereby certify that we have carefully compared the annexed copy with the plat of Allen M. Bosworth's Subdivision on the S.E. corner of section nine north of R. 18 Wayne County Michigan, and that the same is a true and correct copy of the same as the same appears on the books of said Register of Deeds.

M. A. Macdonald, Secy. Register of Deeds.
 A. H. Wilmouth, Deputy

RECEIVED AND FILED,
 IN AUDITOR GENERAL'S OFFICE,
 June 13th 1901.
 Charles H. McCann, Auditor General.

REGISTER OF DEEDS OFFICE
 WAYNE COUNTY
 This instrument was received for record this 1st day of June, 1901, at 10 o'clock A.M. and recorded in Liber 2, 200 of deeds, on page 32, as proper certificate was furnished in compliance with Sec. 185, of Senate Bill No. 190 File 212, Act of 1893.

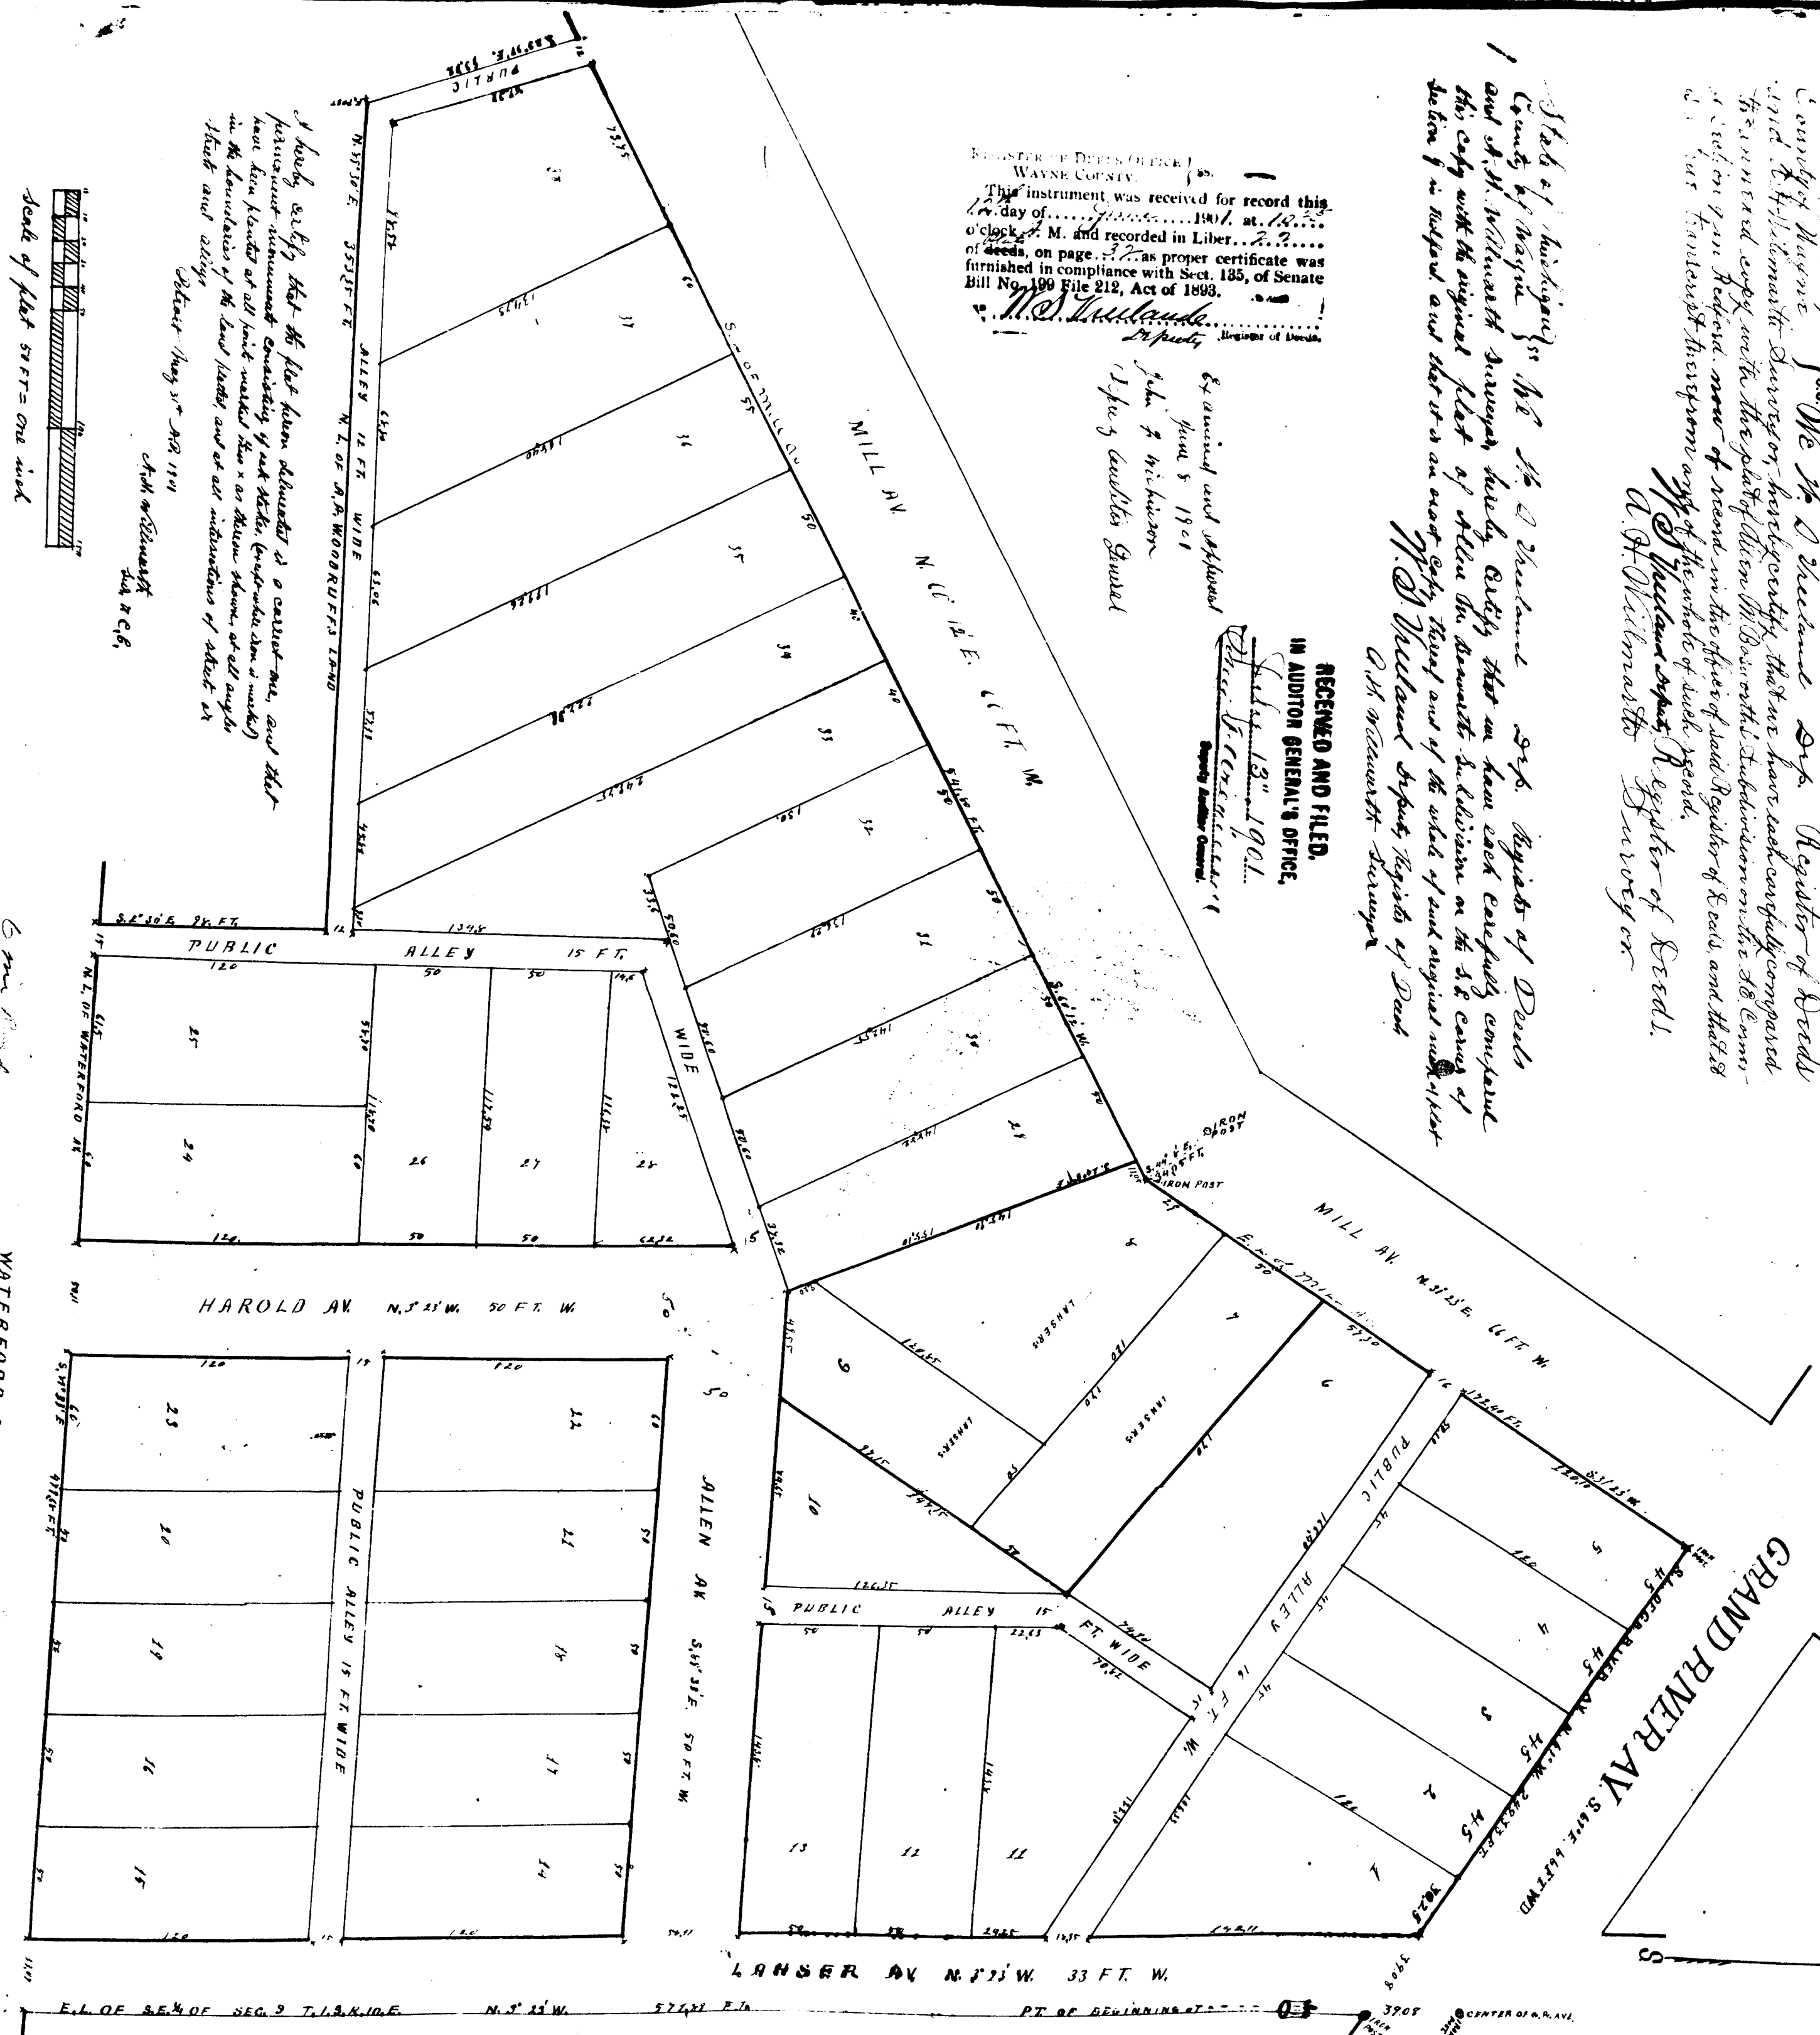

By Councilman Ravitz:
Resolved, That all that part of Bosworth Court, south of Grand River Avenue as platted in Bosworth Court Subdivision of Part of Lot 1 of Ford Plains Subdivision of the S.E. 1/4 of Sec. 9, T. 1 S., R. 10 E., City of Detroit, Wayne County, Michigan, as recorded in Liber 42, Page 87 of Plats Wayne County Records adjoining Lots 6, 7, 8, 9, 10, 11 and 12, of the above mentioned subdivision.

Be and the same is hereby vacated as a public street to become a part and parcel of the adjoining property; and further

Resolved, That at any time in the future it becomes necessary to install a six-inch gate valve at the entrance to the vacated street, the entire cost of said installation shall be borne by the Redford Lutheran Church, its heirs, successors, administrators or assigns; and further

Resolved, That the installation of the gate valve shall be done under Department of Water Supply permit and inspection and in accordance with Department of Water Supply standards and specifications; and further

Resolved, That the Quit Claim Deeds of the Redford Evangelical Lutheran Church and the Aid Association for Lutherans deeding land to the City of Detroit for street turnaround purpose being described as: All that part of Lot 3 of Bosworth Court Subdivision of the S.E. 1/4 of Ford Plains Subdivision of the S.E. 1/4 of Section 9, T. 1 S., R. 10 E., City of Detroit, Wayne County, Michigan, more particularly described as follows: Beginning at the southwest corner of Lot 3; thence along the south line of Lot 3, S. 61d E., 20.00 feet; thence N. 29d E., 20.00 feet; thence N. 61d W., 26.88 feet to a point in the west line of Lot 3; thence along the west line of Lot 3, S. 10d 00m 31s W., 21.15 feet to the point of beginning.

Be and the same are hereby accepted and the City Controller is hereby directed to record said deeds in the Office of the Register of Deeds for Wayne County.

Adopted as follows:

Yeas—Councilmen Beck, Brickley, Hood, Miriani, Ravitz, Rogell, Van Antwerp and President Carey—8.
Nays—None.

STATE OF MICHIGAN)
CITY OF DETROIT) ss.

SHORT FORM -- TRUE COPY CERTIFICATE

I, THOMAS D. LEADBETTER, CITY CLERK of the City of Detroit, do hereby certify that the annexed paper is a True Copy of a Resolution

adopted by the Common Council on JAN 10 1967

and approved by the Mayor on JAN 16 1967

as appears from the Journal of said Common Council, on file in my office.


IN WITNESS WHEREOF, I have hereunto set my hand and affixed the Corporate Seal of said City, at Detroit, on

JAN 19 1967

Thomas D. Leadbetter
City Clerk

Forward to Auditor General Lansing
PETITION NO. 11205
REDFORD EV. LUTHERAN CHURCH
E. A. WESTCOTT JR., PASTOR
17129 BOSWORTH COURT

APPROVED JANUARY 10, 1967

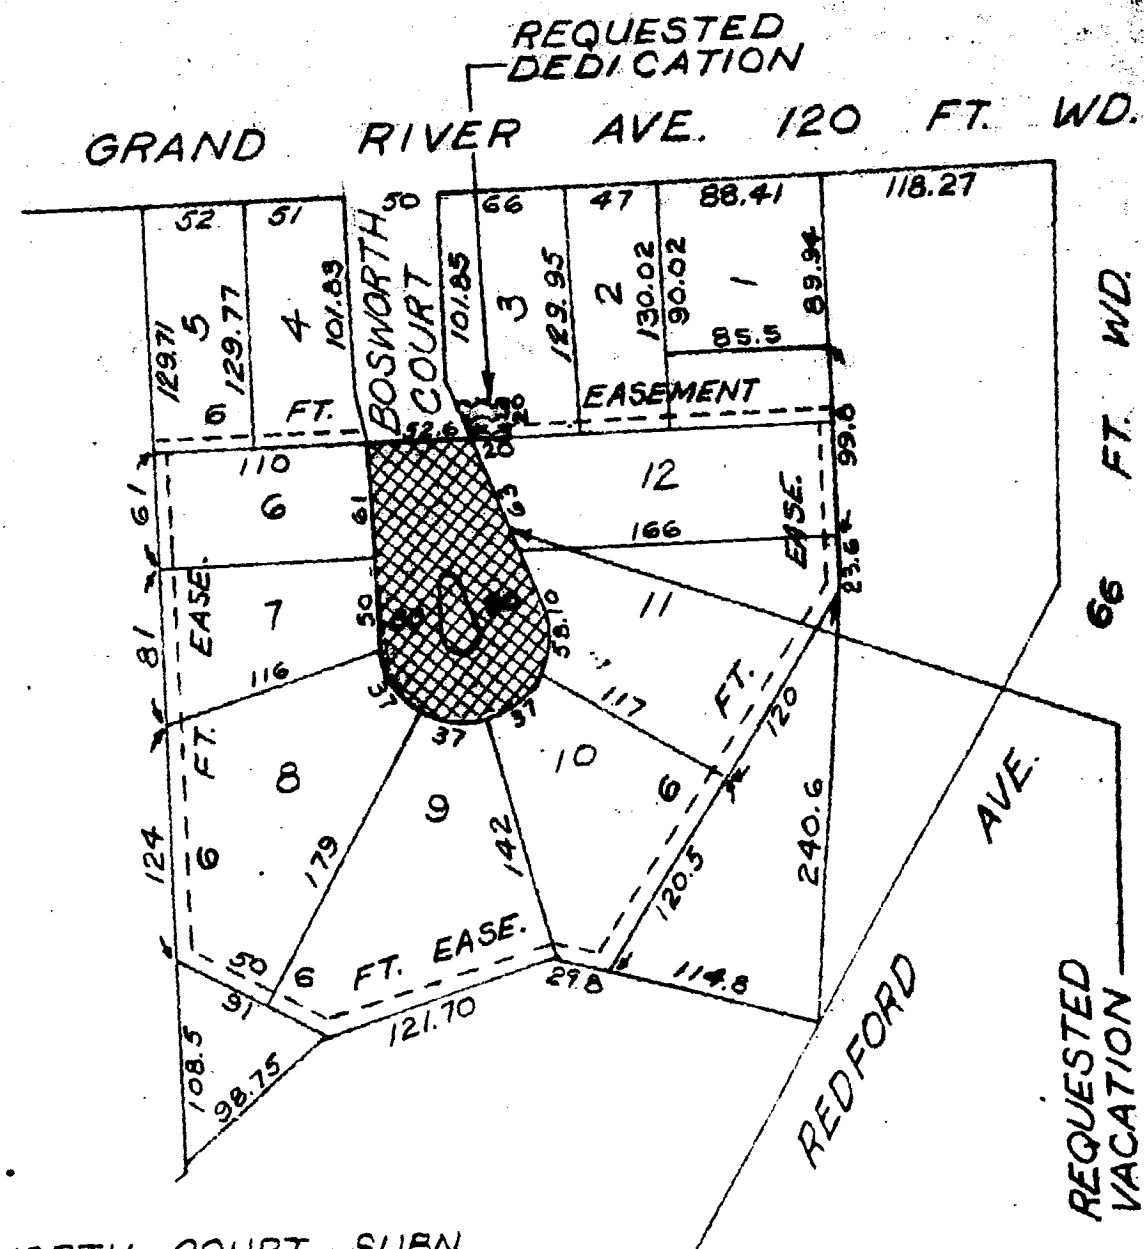

BOSWORTH COURT SUBN.
TOPO NO. 122
SCALE 1"=100'

FOR OFFICE USE ONLY			
B			
A			
DESCRIPTION			
REVISIONS			
DRAWN BY	APPROVED		
PLUNGIS			
TRACED BY	APPROVED		
CHECKED	APPROVED		
CITY ENGINEER			
REQUESTED VACATION & DEDICATION OF PORTIONS OF BOSWORTH COURT S. OF GRAND RIVER.			
CITY OF DETROIT Dept. of Public Works City Engineers Office			
Job No. MO 1-1			
Dwg. No. X-2488			
Date 6-22-66			

November 20, 1989
Honorable City Council
Re: Petition No. 2027 Redford Presbyterian Church. Conversion to easement of 2 east-west public alleys in the (irregular) block bounded by Redford Avenue, Rockdale Avenue, and W. McNichols Road into an easement for public utilities.
Petition No. 2027 of "Redford Presbyterian Church" requests the conversion of the east-west public alley, 3 feet wide, and a portion of the east-west public alley, 12 feet wide, in the (irregular) block bounded by Redford Avenue, Rockdale Avenue, and W. McNichols Road into an easement for public utilities.
The requested conversion into public utility easements was approved by the Community and Economic Development Department. The petition was referred to the City Engineering Department for investigation and report. This is our report.
City departments and privately-owned utility companies have reported no objection to the conversion of public utility-way into a utility easement. Provisions protecting utility easements are part of the resolution.
The adoption of the attached resolution is recommended.
Respectfully submitted,
CLYDE R. HOPKINS
Director

By Council Member Ravitz:
Resolved, All of the east-west public alley, 3 feet wide, in the (irregular) block bounded by Redford Avenue, Rockdale Avenue, and W. McNichols Road lying northerly of and abutting the north line of Lot 1 to 7 as platted in "Woodruff's Subdivision" of the "Spartan" plat of Section 8, Town 1 South, Range 10 East, Redford Township, City of Detroit, Wayne County, Michigan as recorded in Liber 22, Page 18, Plans, Wayne County Records, also lying southerly of and abutting the south line of a strip of surplus property (variable width) in the Southeast Quarter of Section 8, Town 1 South, Range 10 East, Redford Township, City of Detroit, Wayne County, Michigan, also all that part of the east-west public alley, 12 feet wide, in the (irregular) block bounded by Redford Avenue, Rockdale Avenue, and W. McNichols Road lying southerly of and abutting the south line of the west 5.20 feet of Lot 33, and Lots 34 to 38 as platted in

the Southeast corner of Section 8, in Redford Township, Town 1 South, Range 10 East, City of Detroit, Wayne County, Michigan as recorded in Liber 22, Page 18, Plans, Wayne County Records, also lying northerly of and abutting the north line of a strip of surplus property (variable width) in the Southeast Quarter of Section 8, Town 1 South, Range 10 East, Redford Township, City of Detroit, Wayne County, Michigan.
Be and the same are hereby vacated as public alleys and are hereby converted into a public easement of the full width of the alleys, which easement shall be subject to the following covenants and agreements, uses, reservations and regulations, which shall be observed by the owners of said alleys and by their heirs, executors, administrators and assigns, forever to wit:

First, said owners hereby grant to and for the use of the public an easement or right-of-way over said vacated public alleys herein above described for the purposes of maintaining, installing, repairing, removing, or replacing public utilities, such as water mains, sewerage lines or mains, telephone, electric light conduits or poles or things usually placed or installed in a public alley in the City of Detroit, with the right to ingress and egress at any time to and over said easement for the purpose above set forth.

Second, said utility easement or right-of-way in and over said vacated alleys herein above described shall be forever accessible to the maintenance and inspection forces of the utility companies, or those specifically authorized by them, for the purpose of inspecting, installing, maintaining, repairing, removing, or replacing any sewer, conduit, water main, gas line or main, telephone or light pole or any utility facility placed or installed in the utility easement or right-of-way. The utility companies shall have the right to cross or use the driveways and yards of the adjoining properties for ingress and egress at any time to and over said utility easement with any necessary equipment to perform the above mentioned tasks, with the understanding that the utility companies shall use due care in such crossing or use, and that any property damaged by the utility companies, other than that specifically prohibited by this resolution, shall be restored to a satisfactory condition.

agree that no buildings or structures of any nature whatsoever including, but not limited to, concrete slabs or driveways, retaining or partition walls (except necessary line fences) shall be built or placed upon said easement, nor any change of surface, grade, middle, without prior approval of the City Engineering Department.
Fourth, that if the owners of said vacated alleys shall request the removal and/or relocation of any existing poles or other utilities in said easement, such owners, shall pay all costs incidental to such removal and/or relocation, unless such charges are waived by the utility owners.
Fifth, that if any utility located in said property shall break or be damaged as a result of any action on the part of said owners or assigns (by way of illustration but not limitation) such as storage of excessive weights of materials or construction not in accordance with Section 3 mentioned above, then in such event said owners or assigns shall be liable for all costs incidental to the repair of such broken or damaged utility, and
Provided Further, That a certified copy of this resolution shall be recorded with the Wayne County Register of Deeds. The petitioner shall pay all incidental recording costs.

Adopted as follows:
Attest - Council Members Cleveland, Collins, Elmerhard, Hood, Kelley, Mahaffey, Peeples, Ravitz, and President Hanson - 9
Nays - None.

Mag A. Haché
L 24066
PA 442
Red Feb 6 1989

STATE OF MICHIGAN ss. SHORT FORM - TRUE COPY CERTIFICATE
CITY OF DETROIT)

I, JAMES H. BRADLEY, CITY CLERK of the City of Detroit, do hereby
certify that the annexed paper is a True Copy of a Resolution
adopted by the City Council on January 4th, 1989
and approved by the Mayor on January 12th, 1989
as appears from the Journal of said City Council, on file in my office.

IN WITNESS WHEREOF, I Have hereunto
set my hand and affixed the Corporate
Seal of said City, at Detroit, on

February 6th, 1989

James H. Bradley
City Clerk

1240
2049

Forward to State Treasurer "100-14199" 100-14199-103 pp 20-21

PETITION NO. 2027
REDFORD PRESBYTERIAN CHURCH
22122 W. MC NICHOLS
A. CHARLOTTE WIRTH
PHONE: 534-4100

1240
2049

REQUESTED CONVERSION TO EASEMENT.

REDFORD

ROCKDALE

W. MC NICHOLS

A. M. BOSWORTH SUBN
A. P. WOODRUFF'S SUBN

CARTO. NO. 122-F

DESIGNED BY	APPROVED:	CITY OF DETROIT	REQUESTED CONN. TO EASEMENT OF THE E/W ALLEY 12 FT. WD., ALSO THE E/W ALLEY 3 FT. WD. BOTH IN THE BLK. BND BY W. MC NICHOLS, ROCKDALE & REDFORD.
DRAWN BY J. FOSTER			
TRACED BY			
CHECKED BY			
12 E/W P.A.	V.M. J.M. 11/78		
DESCRIPTION	DATE		
REVISIONS			

BOOK NO.	SCALE 1"=100'	DRG. NO.
PAGE NO.	DATE 7/25/88	X-2027