


PART I

PLAT of the Village
of CROTON situated
on Sections 7, 8, 17, 18, T12N, R11W,
in the County of Newaygo & State
of Michigan including Jauwerler
and Mitchells Western Addition

Smith & Co

drawn on a scale of 100 feet to an inch
N.B. all the corners marked on this
plat are according to the magnetic bearing
all distances in feet and decimals

J.P. Mitchell

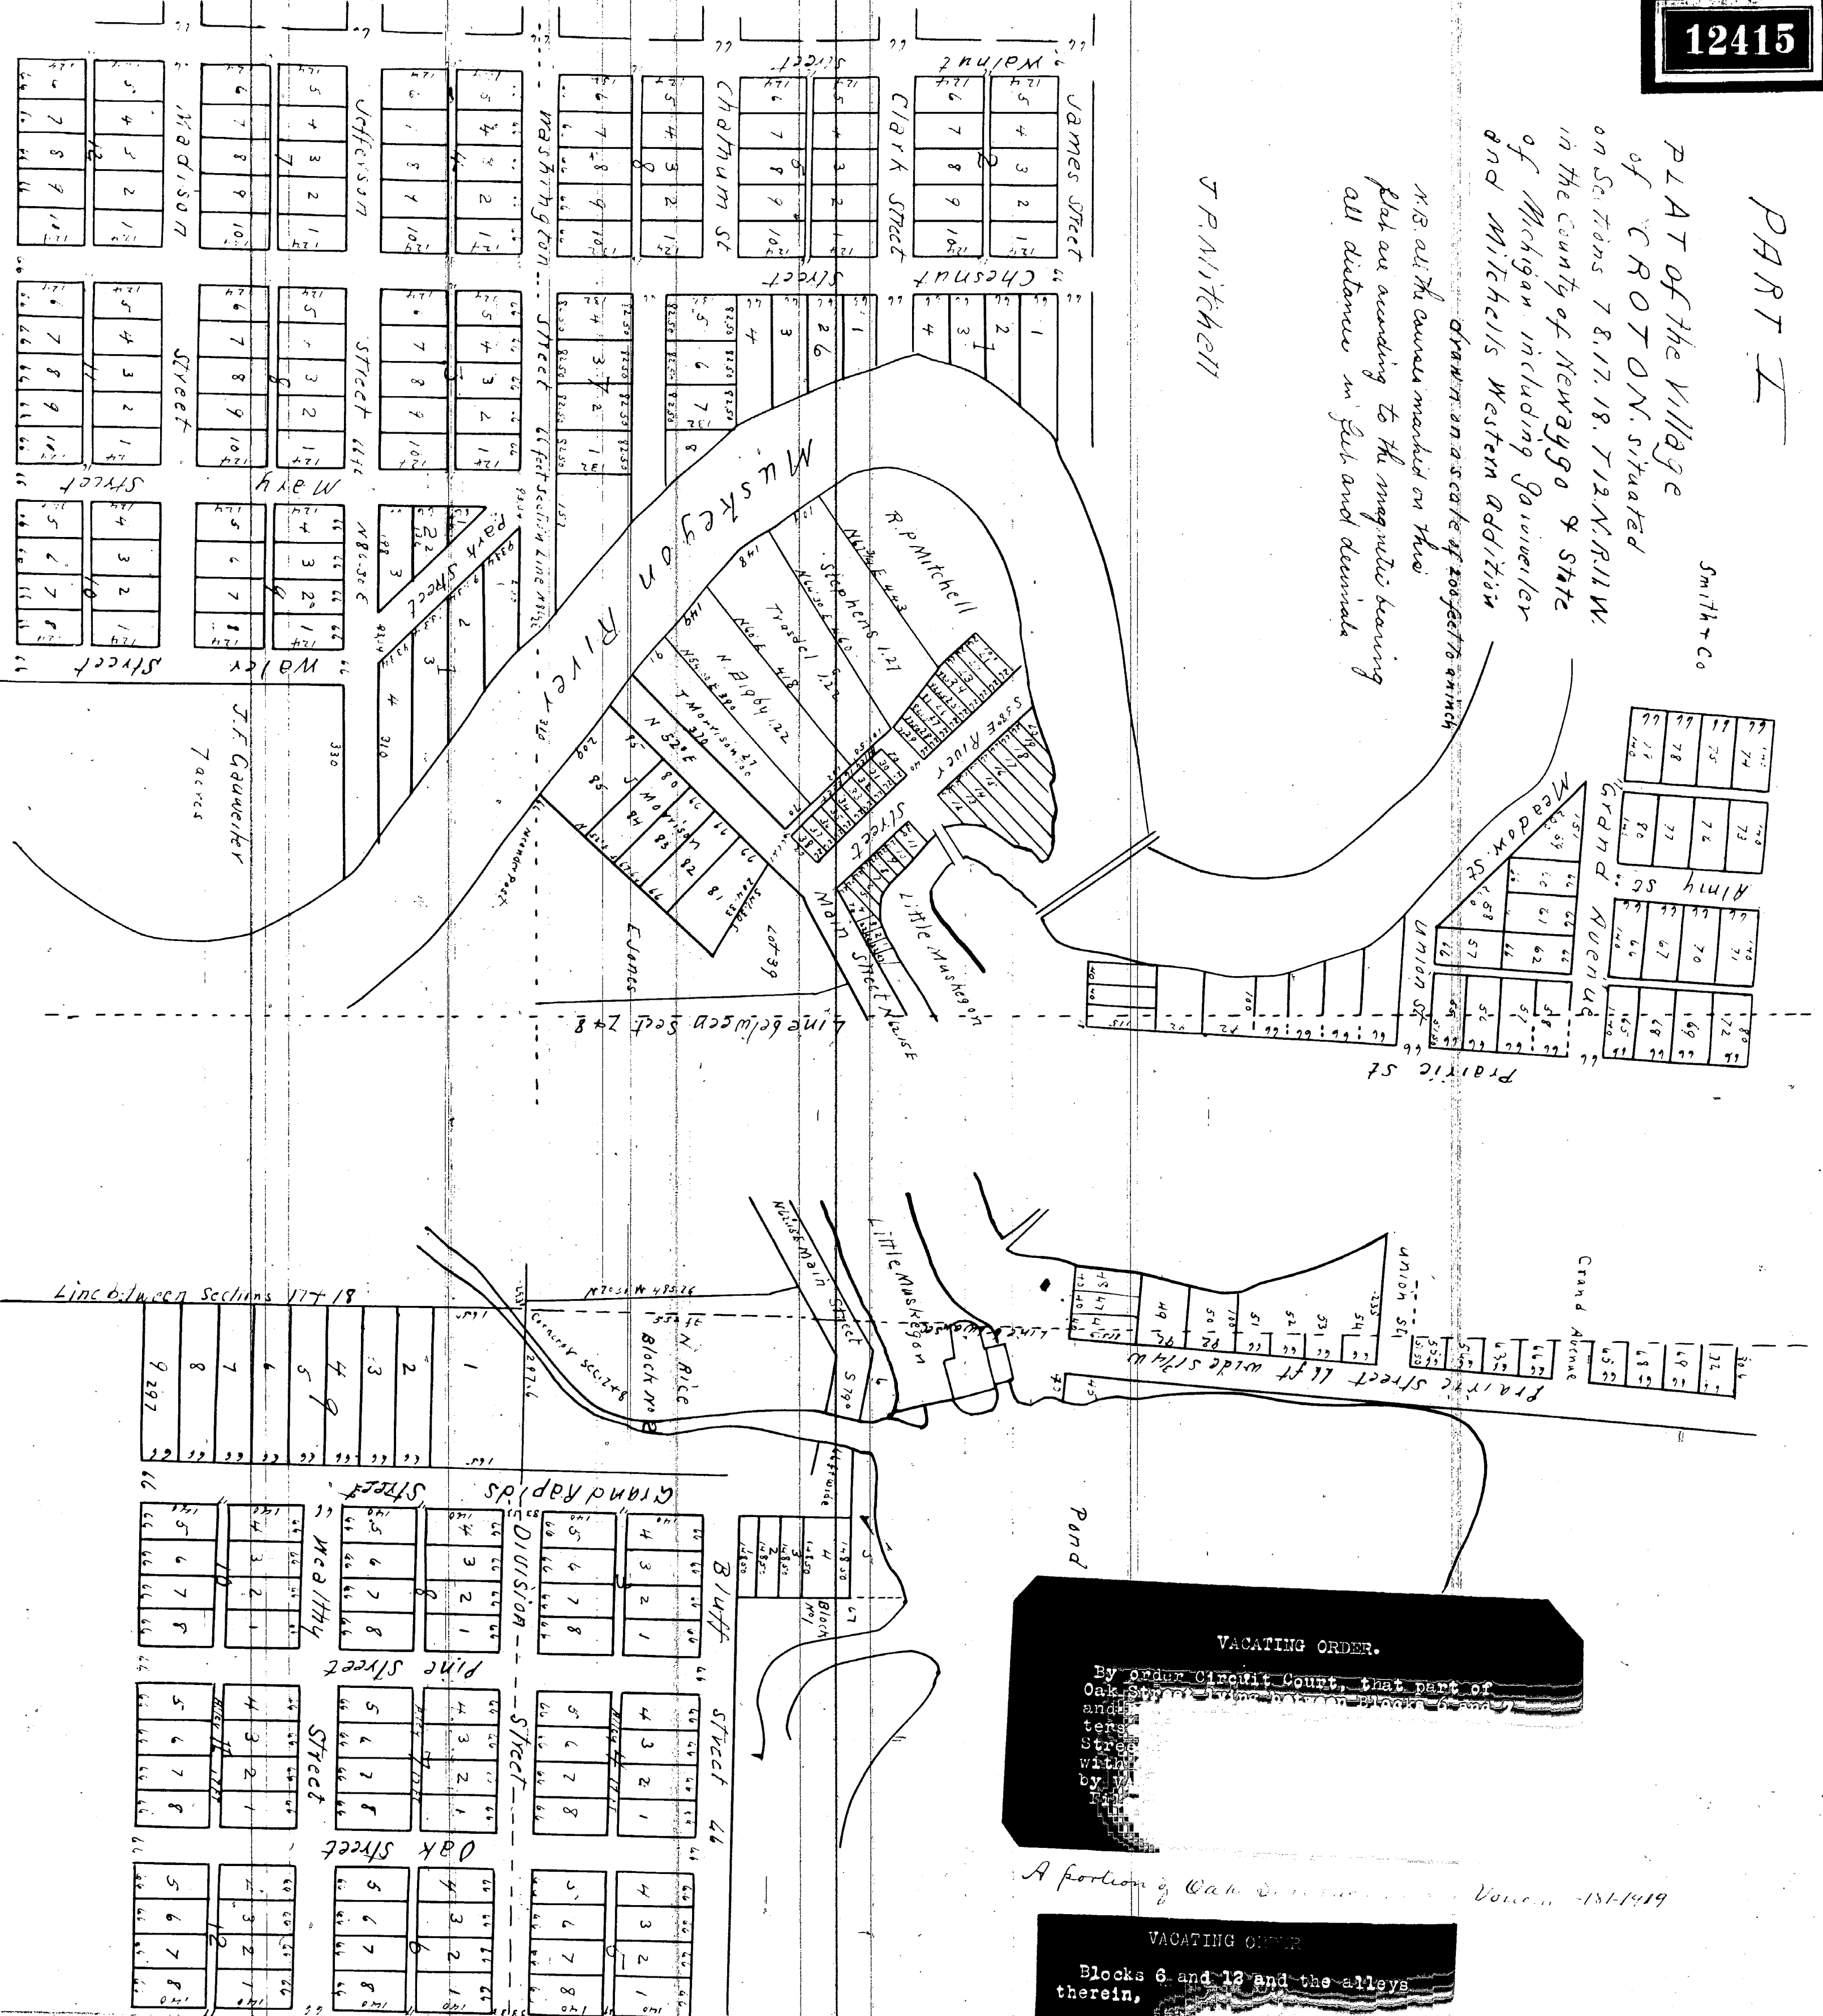

VACATING ORDER.
By order Circuit Court, that part of
Oak Street lying between blocks 6 and 12
and the alleys therein
be vacated
with
by
J.P. Mitchell

A portion of Oak Street lying between blocks 6 and 12 and the alleys therein

VACATING ORDER
Blocks 6 and 12 and the alleys
therein,
All that
east of the
All of
ning from P
All of
ning from
Pine Street

STREET VACATED
BY CIRCUIT COURT ORDER
JULY 13, 1914
VOUCHER 121-4
J. Morrison

OF CROTON.

We the undersigned proprietors and owners of land in sections seven and section eighteen township twelve north of Range eleven west of the principal meridian in Michigan do hereby specify and declare that they have surveyed and caused to be platted into lots and blocks streets and alleys a certain portion of their respective interest in the aforesaid sections designating the same as the western addition to the Village Plat of Croton that the several streets therein represented are sixty six feet wide respectively and that all the alleys are sixteen feet wide that all the streets running north and south on said Plat are parallel to each other and all at right angles to the line between sections seven and eighteen and that all the streets east and west are parallel to said section line that all blocks and lots represented on said Plat are of the size and dimensions marked thereon in feet and decimal parts of a foot that S. J. Gammon is the owner or proprietor all that part of said western Addition south of the center of Washington Street and Robert P Mitchell all that part north of said street

In witness whereof we have hereunto set our hands and seals this twenty seventh day of November 1854

In presence of
 D. F. Woolley LS
 G. E. G. Worch LS

State of Michigan
 County of Newaygo

Be it remembered that on this day of November in the year of our Lord one thousand eight hundred and fifty four personally appeared before me a Justice of the Peace in and for the Town of Newaygo & County aforesaid S. J. Gammon and Robert P Mitchell proprietors of the western addition to the Village Plat of Croton as laid out on the map or that hereunto attached known to me to be the persons named therein as proprietors and who have signed the above specification and who severally acknowledged that said Plat was made according to their direction and that the written specifications by them signed describe the lands platted streets and alleys lots and blocks as they are intended to be

G. E. G. Worch
 Justice of the Peace
 Newaygo Co

I hereby certify that this plat is a correct copy of the plat now on record in the Register of Deeds office being made under the supervision of the Auditor General by tracing the Plat on record and affixing thereto a carefully compared copy of the dedication and certificate

Dated this 12th day of Aug. 1911
 John B. Le Fountain
 Clerk and Gen. Depl.

We the undersigned owners and proprietors of the several portions of land in sections seven eight nineteen and eighteen township twelve north of Range eleven west of the principal meridian in the State of Michigan do hereby specify and declare that the same has been surveyed and subdivided by us and according to our directions into lots and blocks as are represented on the surveyed map and is designated by us the Village Plat of Croton and that the several lots blocks & subdivisions are situated on streets and alleys as therein represented that the courses and bearings of the several streets are laid down and marked thereon together with their several widths that all the lots and subdivisions are numbered from one to eighty five inclusive are of the dimensions size and form as therein represented that all the lots included in Block three to twelve inclusive except Block nine are sixty six feet wide and one hundred and forty deep that the several alleys dividing the lots aforesaid blocks are sixteen feet wide that the lots from one to nine inclusive in Block nine are sixty six feet front in Grand Rapids Street and are bounded by parallel lines East and West and parallel to the section line between section eight and nineteen and of land West to the section line three hundred and thirty feet more or less that all the streets intended as public avenues are sixty six feet wide

In witness whereof we have hereunto set our hands and seals this twenty seventh day of November A. D. 1854

In presence of
 S. J. Gammon LS
 G. E. G. Worch LS

State of Michigan
 County of Newaygo

Be it remembered that on this 27th day of November in the year of our Lord one thousand eight hundred and fifty four personally appeared before me a Justice of the Peace in and for said County the above named William Smith John A. Mills George Zachart Jefferson Morrison & Robert P Mitchell proprietors of the Village of Croton as platted and laid out on the annexed map known to me to be the persons named as proprietors on said Plat and who signed the above specification and memorandum and who severally acknowledged that the foregoing or annexed Plat to be by them made and that the written specification by them signed describes the lands platted the streets with their boundaries courses and extent and all the lots and blocks on said plat intended for sale or set forth in and by said memorandum

G. E. G. Worch

Justice of the Peace in and for the
 County of Newaygo, Mich