

Part one.

M A P
OF
PARSONS & GAYLORD'S ADDITION
TO THE
CITY OF SAGINAW
MICHIGAN.

Scale 100 ft to an Inch.

Know all men by these Presents that the Land comprised in the above named Addition and represented by the following Map is described as follows to wit: All of that part of the E 1/2 of the S. 1/4 of Section 23 in T. 12. N. R. 4. E. bounded as follows Beginning at a point on the quarter line of said Section 7 Chains and 425 links north of the South East corner of said E 1/2 of S. 1/4. Thence North on the quarter line 24 Chains and 77 links Thence West parallel with the East and West quarter line 19 Chains and 72 1/2 links to the West line of said E 1/2 of S. 1/4. Thence South on the last mentioned line 24 Chains and 74 1/2 links Thence East 19 Chains and 78 1/2 links to the place of beginning. That said land is owned by Isaac Parsons Jr. and Augustine S. Gaylord of the City of Saginaw County of Saginaw and State of Michigan That said Map is now executed by the said Isaac Parsons Jr. and Augustine S. Gaylord as Proprietors and by Harrison Cary as Surveyor in accordance with the provisions of an Act to provide for Recording Town Plats and for the purpose of having the same recorded as Parsons & Gaylord's Addition to the City of Saginaw Michigan. The size of lots and width of Streets are given on said map in feet and decimals of a foot. In witness whereof the parties hereunto set their hands and seals this 25th day of June 9 1867

In Presence of
H. R. Gaylord
E. N. Cross

State of Michigan }
Saginaw County } ss

On this 25th day of June A.D. 1867 before me a Notary Public in and for said County personally came the above Isaac Parsons Jr. and Augustine S. Gaylord and Harrison Cary known to me to be the persons who executed the above and who severally acknowledged the execution of the same for the purposes therein expressed

Harvey R. Gaylord

Notary Public for
Saginaw Co., Mich.

Register's Office
Saginaw County } ss


Received for Record and file June 25th 1867 at 3 O'clock P.M. and Recorded in Lib. 38 of Deeds (maps & Plats) at page 148

A. L. Bingham
Register

I hereby certify that this Plat is a correct copy of the Plat now on Record in the Register of Deeds Office, being made under the supervision of the Auditor General by tracing the Platon Record and affixing thereto a carefully compared copy of the Certificate.

Dated the 28th day of June 1911

Alton B. Hurd,
Clerk, Aud Gen Dept.

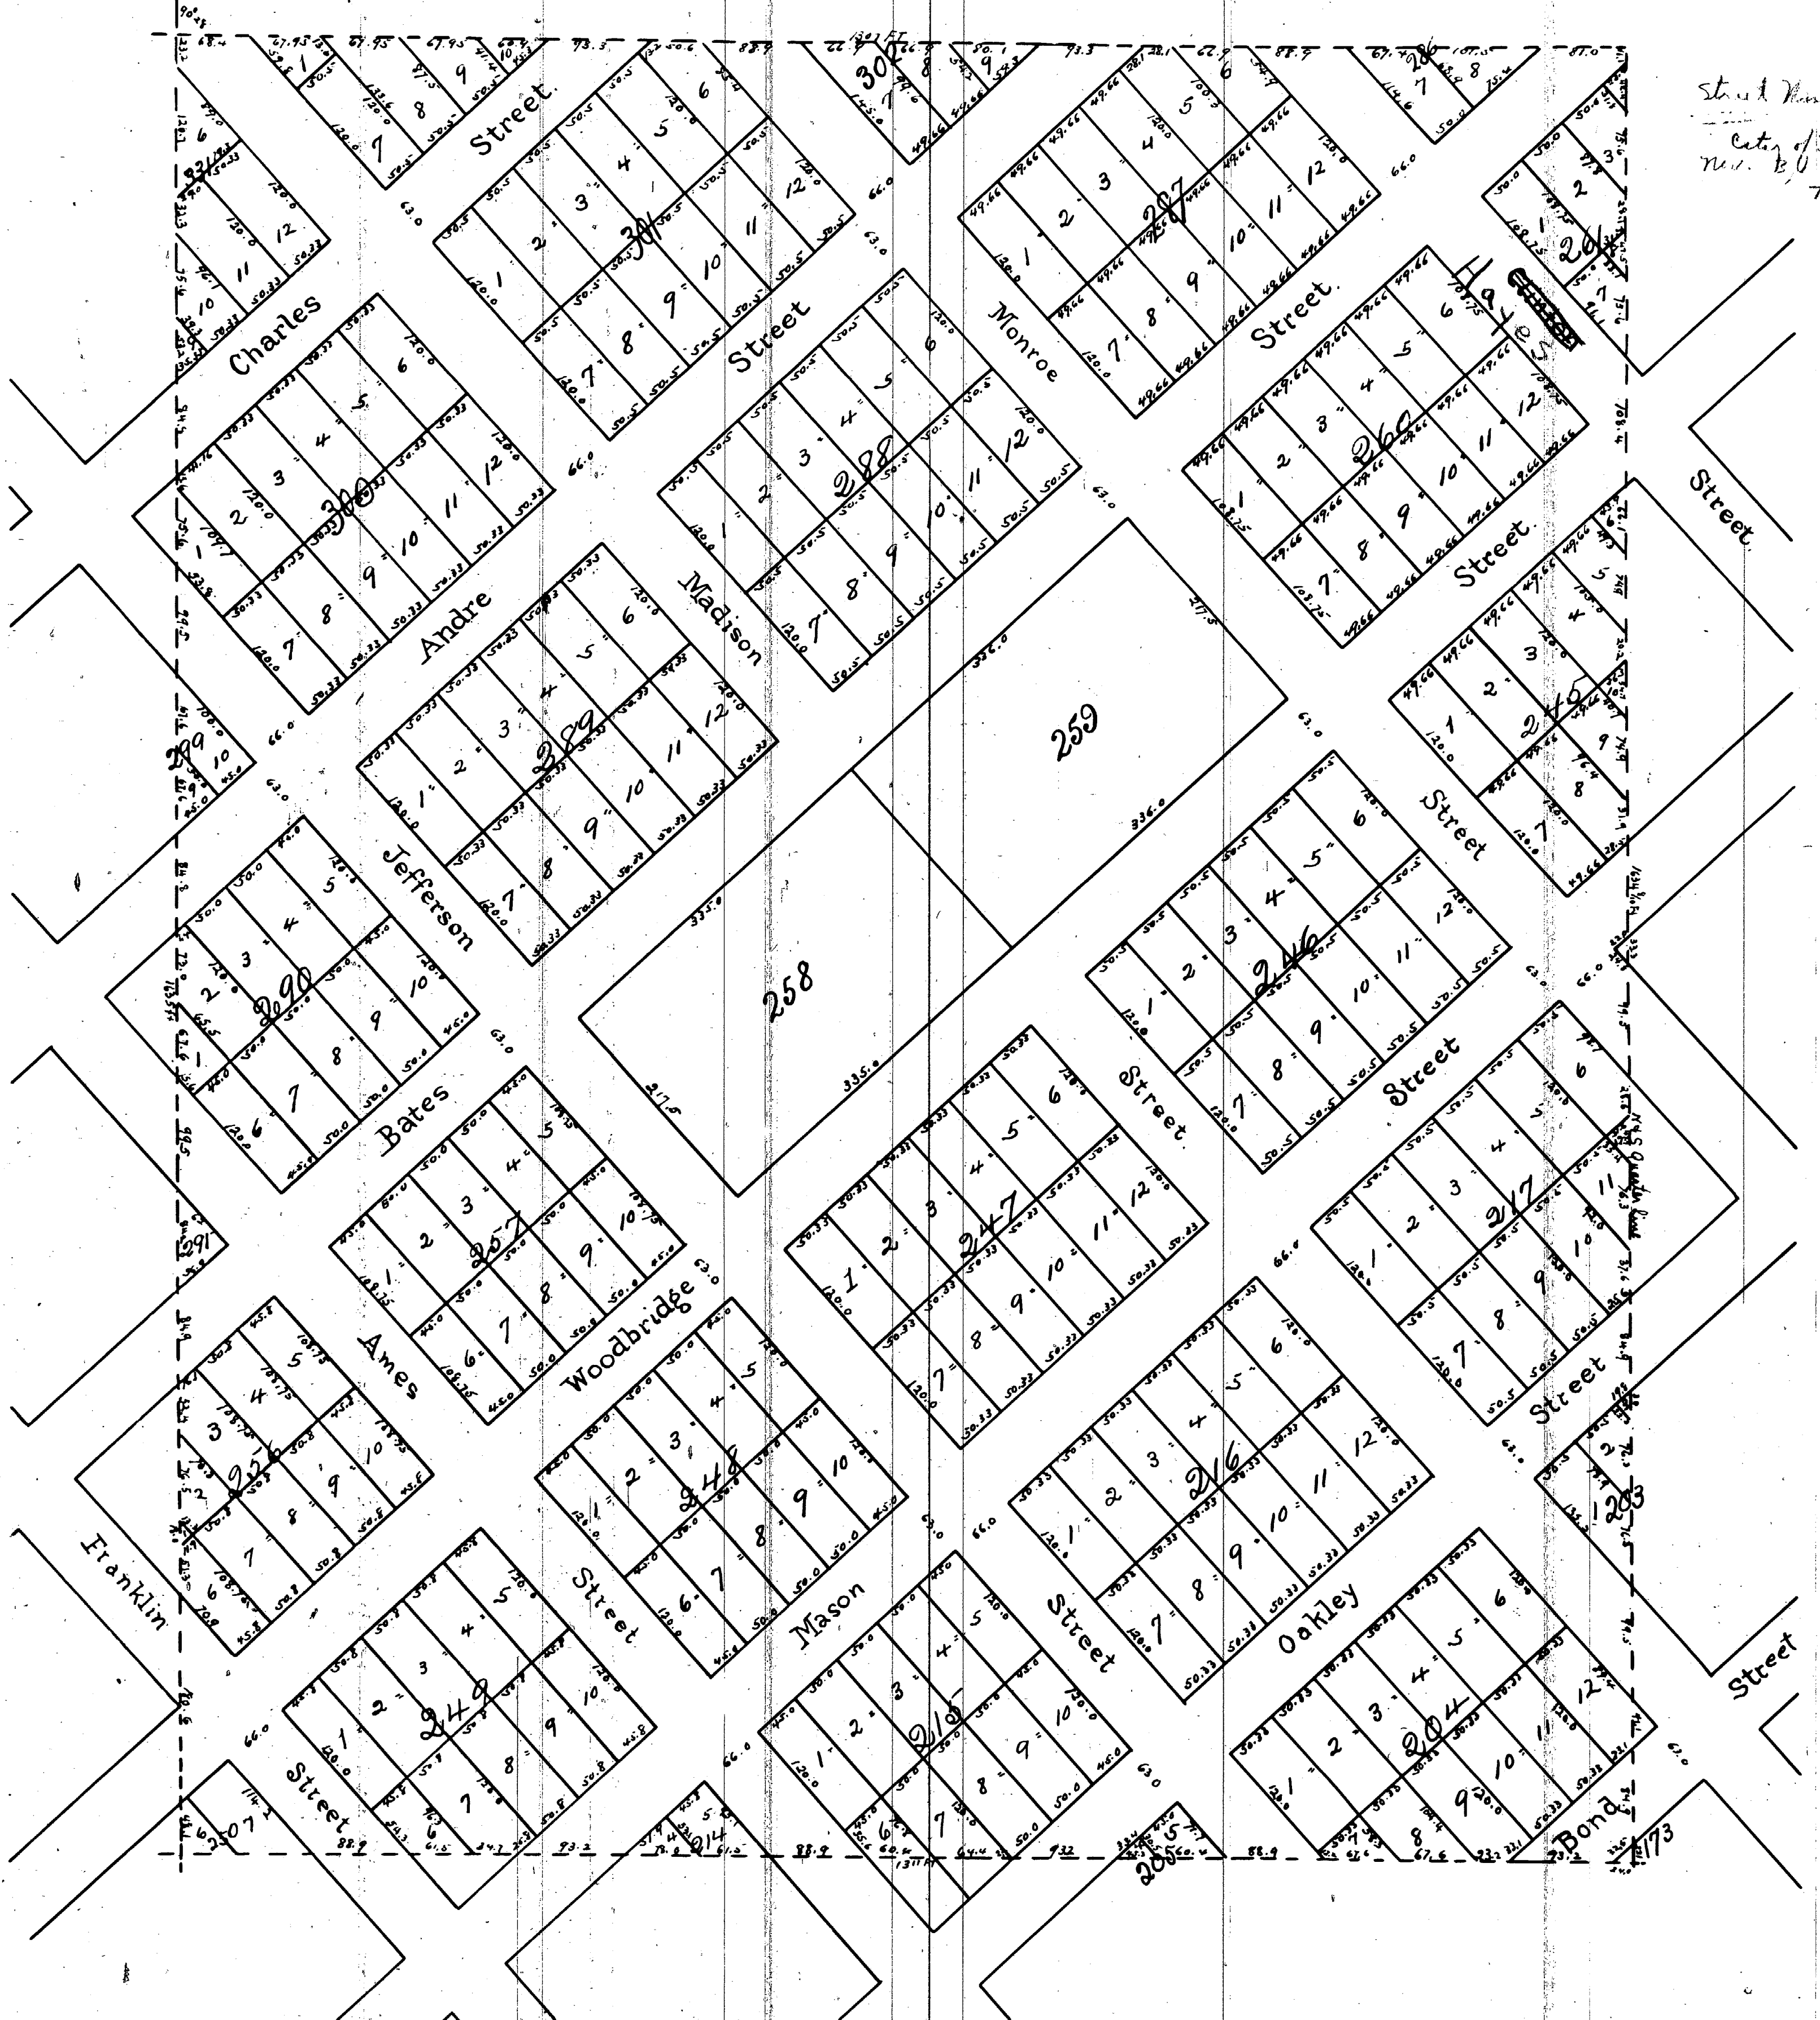

Street Name Change
City of Sacramento
No. 1, B.O. 1958
707-58