



MAP OF
F. SCHEFFLER & CO'S.
ADDITION TO
EAST TAWAS

10300 COUNTY MICH.
Containing about 31 1/2 acres of land. The
29° 22' N R 22 E. E. 1/4 Sec. 10, T. 2 N., R. 22 E.,
containing a piece of land, bounded
and described as follows. Commencing
at a point on the East line of the
3rd 1/4 Sec. 10, T. 2 N., R. 22 E., corner
of said 3075 acres and running
thence west parallel with the
line 792 ft. thence north parallel
with the East line to the Bay Shore
thence north easterly along the
Bay Shore to the East line of
said 3075 acres. Thence north
to the place of beginning.
Beats and lots as shown
Survey of June, 1872 by O. H.
Kraenewald.

Register office
Clare Co.

Received for record Aug 5, 1873. at 1 O'clock P.M.
W. C. Ketter Register

I hereby certify that this plat is a correct copy
of the plat filed on record in the Register of Deeds
office, being made under the supervision of the
Auditor General by tracing the plat on record
and affixing thereto a carefully prepared copy
of the dedication and certification.

Witness this 2nd day of Sept. 1911

Ray C. Warner

Clare, Mich. Sept.

Have all men by their parents that the
land laid out as plotted on the above map
is owned by John A. Limburger, Frank B.
Emmendorfer and John Klemm of Kalamazoo
County and Augustin Gemuth and Fred Schiffer
of Cass County, State of Michigan and
that the said map or plat is now created
by the said John A. Limburger, Frank B.
Emmendorfer, John Klemm, Augustin
Gemuth and Fred Schiffer as proprietors
and O. H. Kraenewald of Kalamazoo Co.
Surveyor in accordance with the provisions
of an act to provide for subdividing townships
and for vacating the same in certain cases
and the act amendatory thereto and for the purpose
of being recorded as J. Schiffer (his addition
to East Tawas). The size of the lot and
width of the street are given on said map
in feet and tenths of feet.
On return whereof we have been
set on hand and seal this 2nd
day of July 9. 1872

John A. Limburger (15)
Frank B. Emmendorfer (15)
John Klemm (15)
Augustin Gemuth (15)
Fred Schiffer (15)
O. H. Kraenewald (15)
In presence of Wm. Y. Tracy
J. C. Flickner

State of Michigan } On this record.
County of Cass } Day of July 1872.
before me a justice of the peace
in and for Cass County, State of
Michigan personally came the above
named John A. Limburger, Frank B.
Emmendorfer, John Klemm,
Augustin Gemuth, Fred Schiffer
and O. H. Kraenewald, known well
to be the persons who created the
above and who have acknowledged
the creation of the above for the
purpose therein expressed.

William Y. Tracy
Justice of the Peace
Cass Co. Mich.
Aug 5, 1873. at 1 O'clock P.M.
W. C. Ketter Register

RESOLUTION


Done 12-535
for the record
WHEREAS, at a meeting duly held by the City Council of the City of East Tawas, the 13th day of January, 1965, written application was made to change the name of Spruce Street located and situated in the City of East Tawas and that such street shall thereafter become known as Westover Street.

NOW THEREFORE, be it resolved that the aforesaid Spruce Street shall no longer be named Spruce Street, but that such street is hereby named and shall henceforth be known as Westover Street.

Clarence McKensie
Clarence McKensie, Mayor

Fred B. Lomas
Fred B. Lomas, City Clerk

F. Scheffler & Co. Ltd.

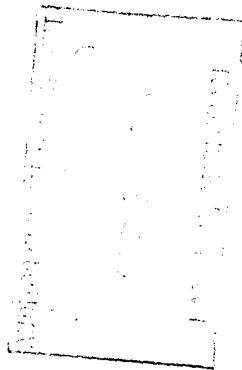

EMPHATIC OF RECORD

STATE OF MICHIGAN)
COUNTY OF IOSCO) SS.

I, Fred Lomas, Clerk of the City of East Tawas, Michigan, having the legal custody of the files and records thereof, do hereby certify that I have compared the attached resolution with the original record thereof on file in the said City records, and have found the same to be a true and correct copy thereof. And I further certify that the change of name of the Street concerned in such resolution may effect the Subdivision located in the City of East Tawas, Michigan, known as F. Scheffler & Co's Addition to East Tawas, according to plat thereof as recorded in Liber 1 of plats, at page 21, Iosco County Records.

Fred Lomas
Fred Lomas
East Tawas City Clerk

Subscribed and sworn to before me
this 24th day of Feb., 1965.

Wayne A. Pollard
Notary Public, Iosco County, Michigan.

My Commission expires 19____.
WAYNE A. POLLARD
Notary Public, Iosco County Mich.
My Commission Expires May, 15, 1966

have do.

CITY OF EAST TAWAS

EAST TAWAS, MICHIGAN

March 2, 1965

Mr. ALLISON GREEN
Acting Auditor General
Lansing, Michigan


Daer sir;


RESOLUTION TO CHANGE NAME OF SERPUC STREET, F. SCHEFFERS AND COMPANY'S
ADDITION, CITY OF EAST TAWAS, IOSCO COUNTY, ADOPTED FEBRUARY 1, 1965
Herewith sketch showing change at the western extremity of
Westover Street to city limits.

Yours truly.


F. B. Leonard

City Clerk

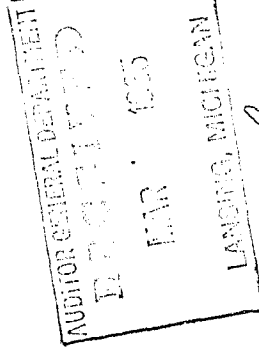

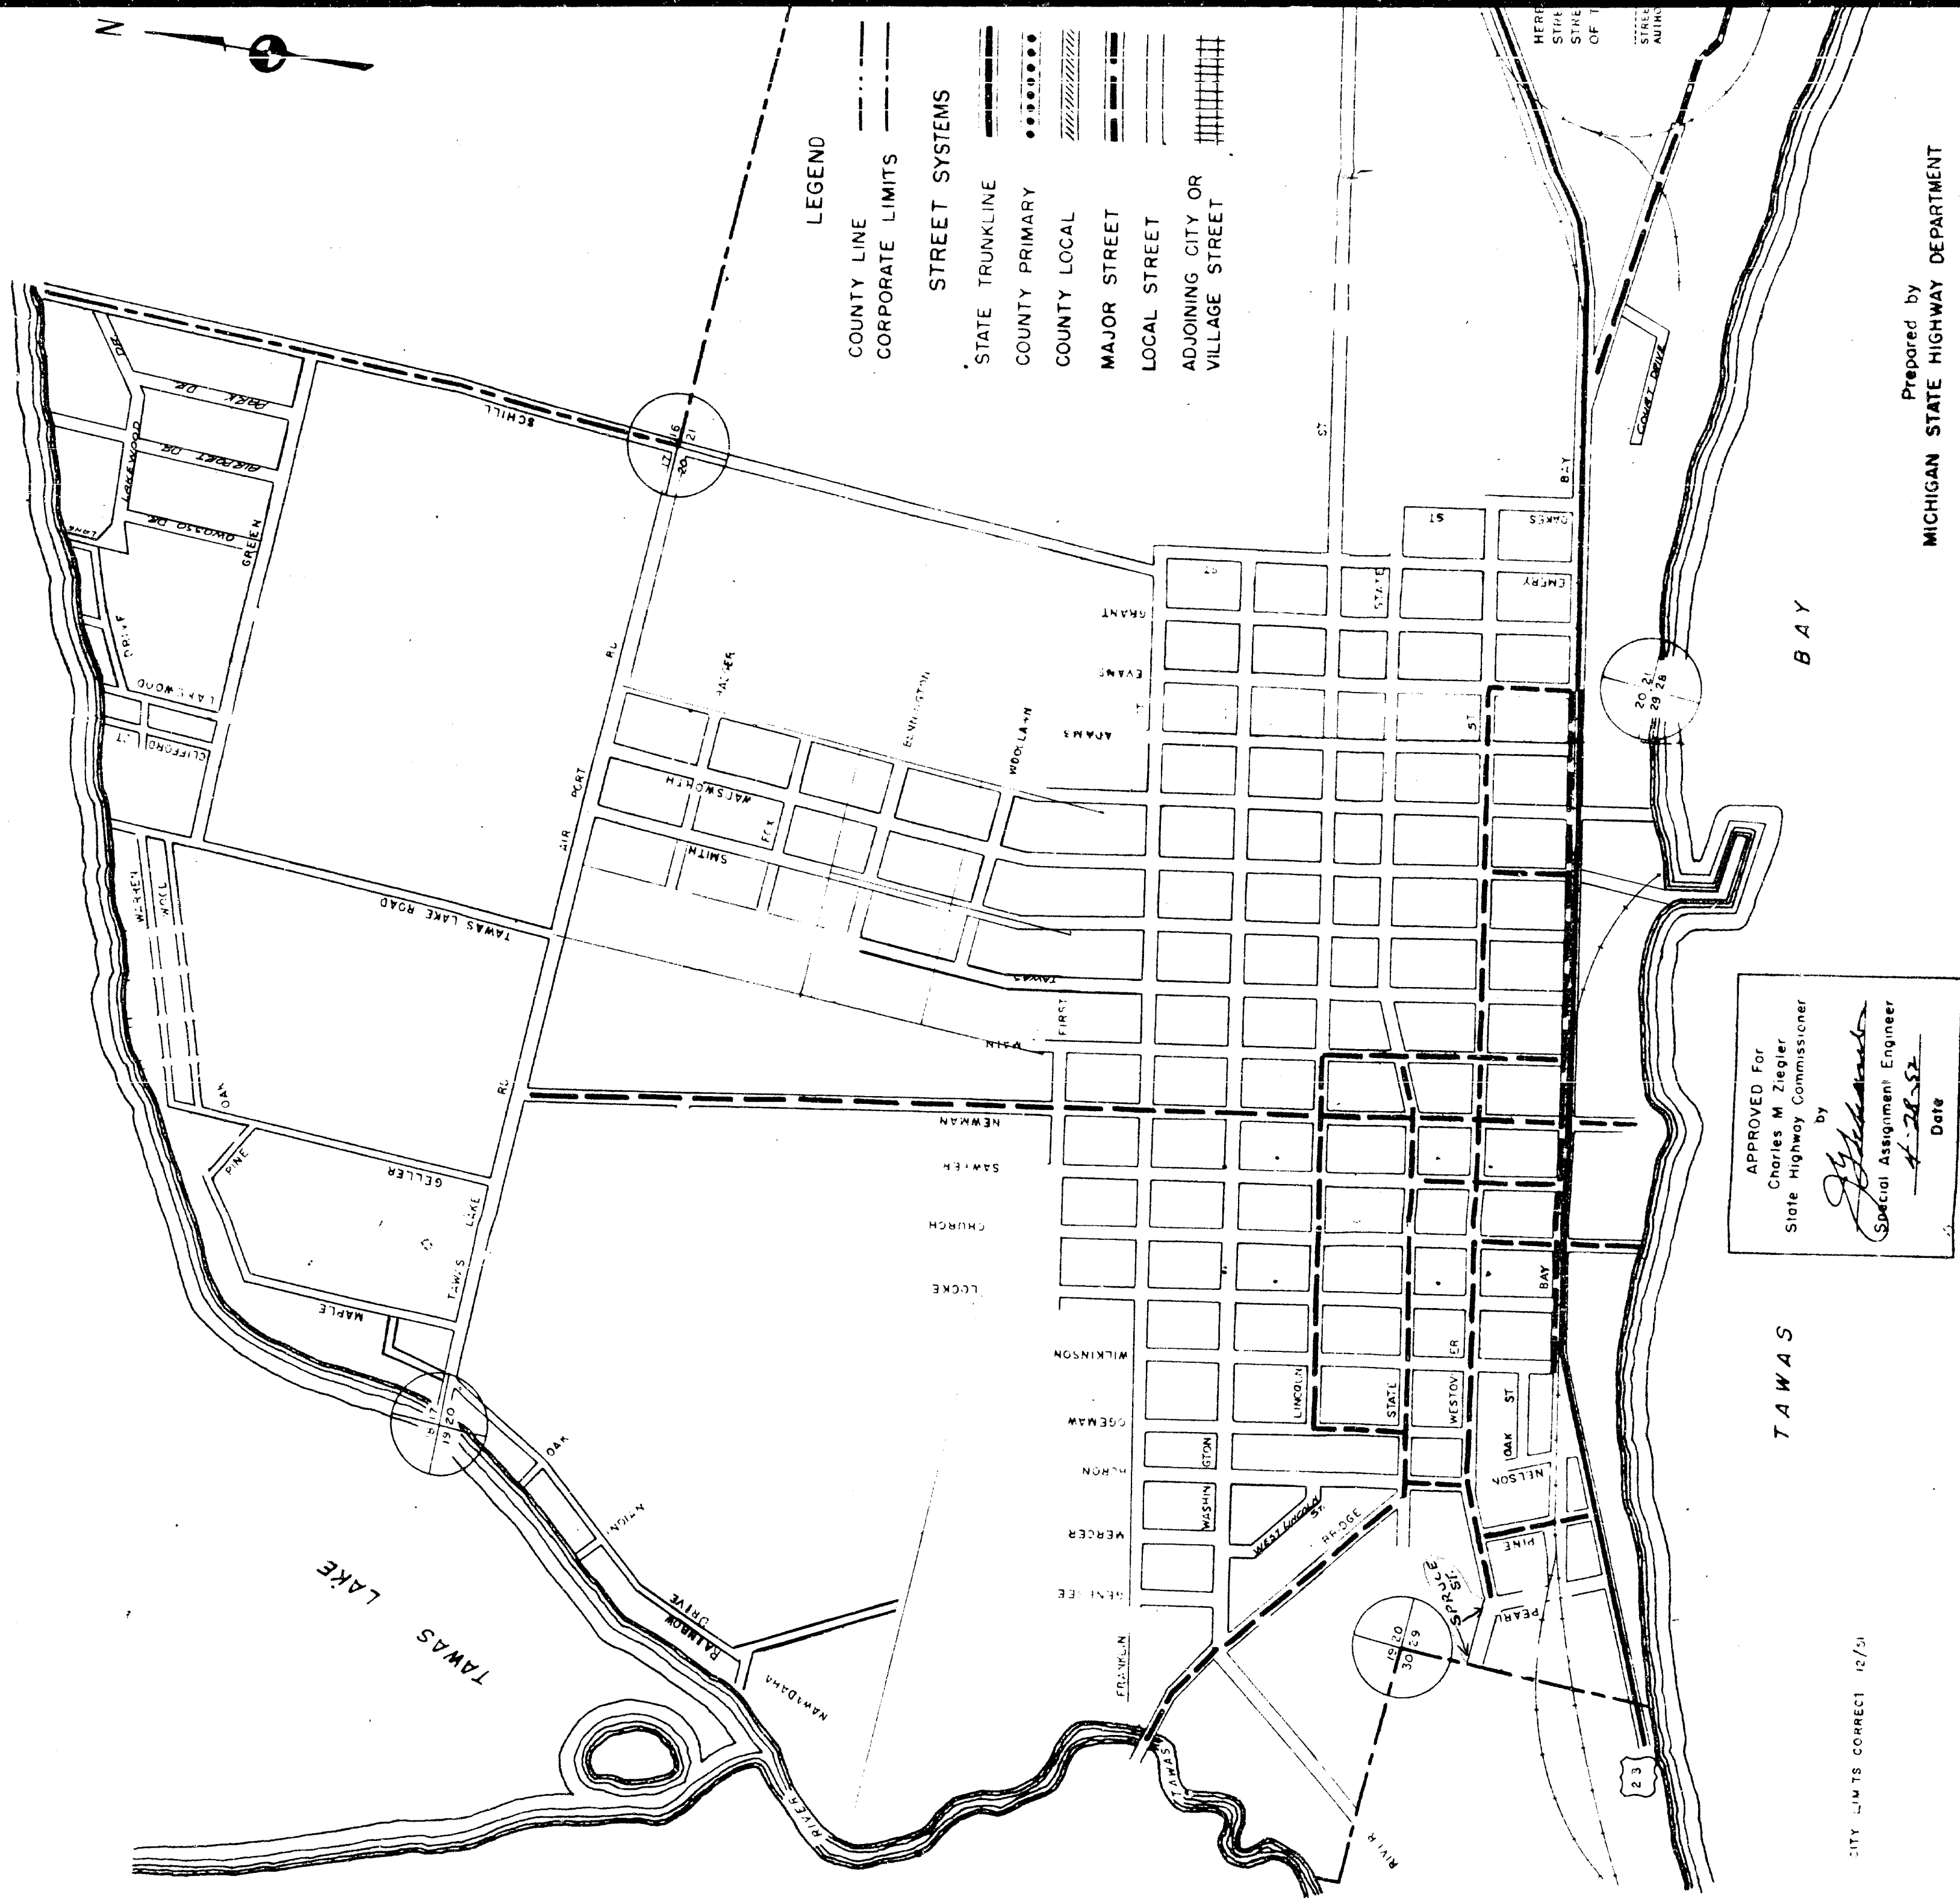

Prepared by
MICHIGAN STATE HIGHWAY DEPARTMENT

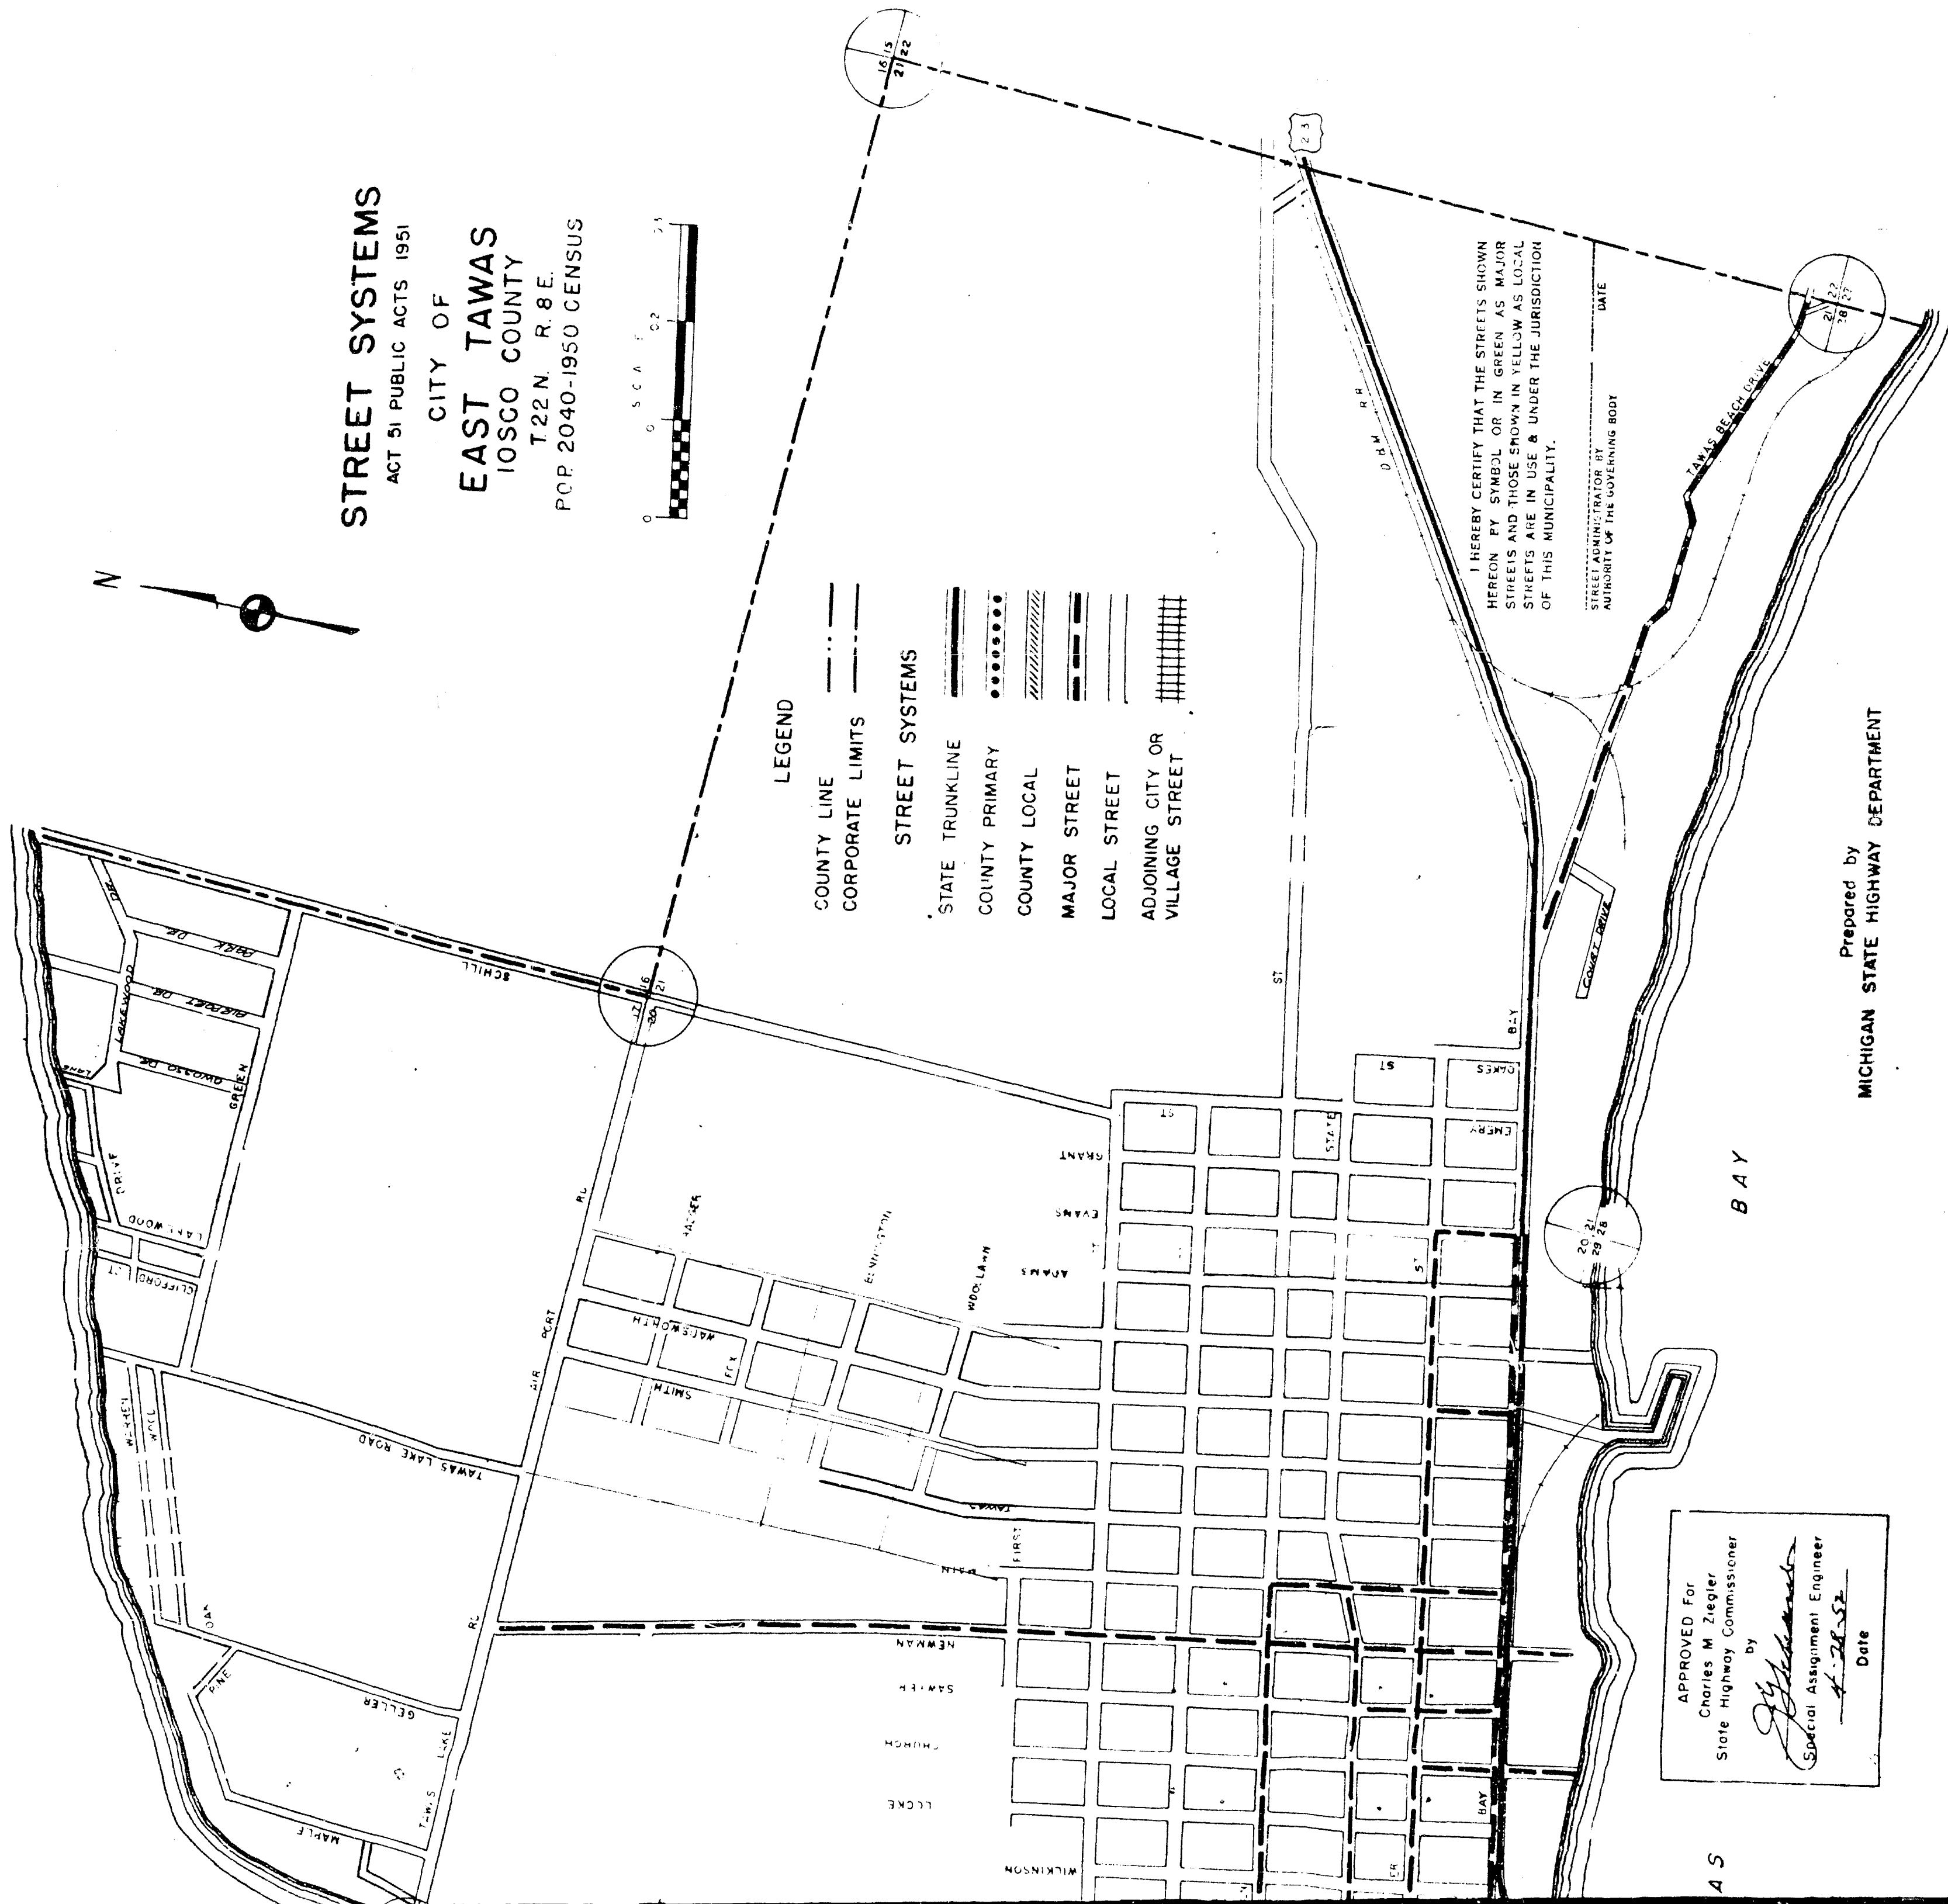

APPROVED For
Charles M. Ziegler
State Highway Commissioner
by
[Signature]
Special Assignment Engineer
4-28-52
Date

Prepared by
MICHIGAN STATE HIGHWAY DEPARTMENT