

I hereby certify that this Plat is a correct copy of the Plat now on record in the Register of Deeds Office, being taken under the supervision of the Auditor General by tracing the Plat on Record and affixing thereto a carefully compared copy of the Dedication and Certificate.

Dated the 7th day of September 1888

Attest: S. J. Ward

Clerk, Auditor Gen. Rept.

Know all men by these presents that Mr. John C. Hadley as Proprietor and Emmanella Hadley his wife have caused the land embraced in the annexed Plat to be surveyed laid out and Platted to be known as Hadley's Third Addition to the Village of Grayling and that the Street as shown on said Plat are hereby dedicated to the use of the Public.

Signed and sealed in presence of }
 O. J. Bell }
 E. A. Hadley }
 State of Michigan }
 County of Leaning }
 Before me a Notary Public in and for said County personally }
 came the above named John C. Hadley and Emmanella Hadley his }
 wife known to me to be the persons who executed the above ded- }
 -ication and acknowledged the same to be their free act and deed.

O. J. Bell
 Notary Public Crawford, Mich.

O. J. Bell

Notary Public Crawford, Mich.

Description of Land Platted.

The land embraced in the annexed Plat of Hadley's Third Addition to the Village of Grayling is described as follows, it contains a part of the S^W 1/4 of the N^W 1/4 of Sec (7) Town 726 N R 3 West Principle Meridian of Michigan commencing at a point 26.88 ft of 88.6° West from the center of said Sec (7) Town. Then running N 43° 5' on westerly boundary of Lake St. 336 ft to the southeast corner of Block one thence N 10° E Parallel to and 33 feet West from quarter line of said Section 1080 feet to the north one eighth line thence S 85° 28' West on North right line 1291 ft to N W Eight Point thence S 1° 14' on West Eight Line 336 feet thence S 47° 24' E to center from and Parallel to M. E. Railroad 1445 feet to East and West quarter line of said Section (7) corner thence N 86° E on quarter line 3 feet and 9 inches to Place of beginning


Surveyors Certificate

I hereby certify that the Plat herein delineated is a correct one and a permanent monument consisting of a piece of Fall Road Iron has been planted at the initial Point marked thus O and Iron is 2 feet long and has 30° marked on its face and the outer of the 7 in. diameter by an hollow iron cross 16 inches long by 3 inches wide and 1/2 inch thick. Run is 4 1/2 inches long by 3 inches wide and 1/2 inch thick, and heavy Cedar Post has been located in the ground at all angles and corners of the land Platted and at all the intersections of Streets as shown in the Map.

A. E. Newman

Surveyor

MAP OF HADLEY'S THIRD ADDITION TO GRAYLING

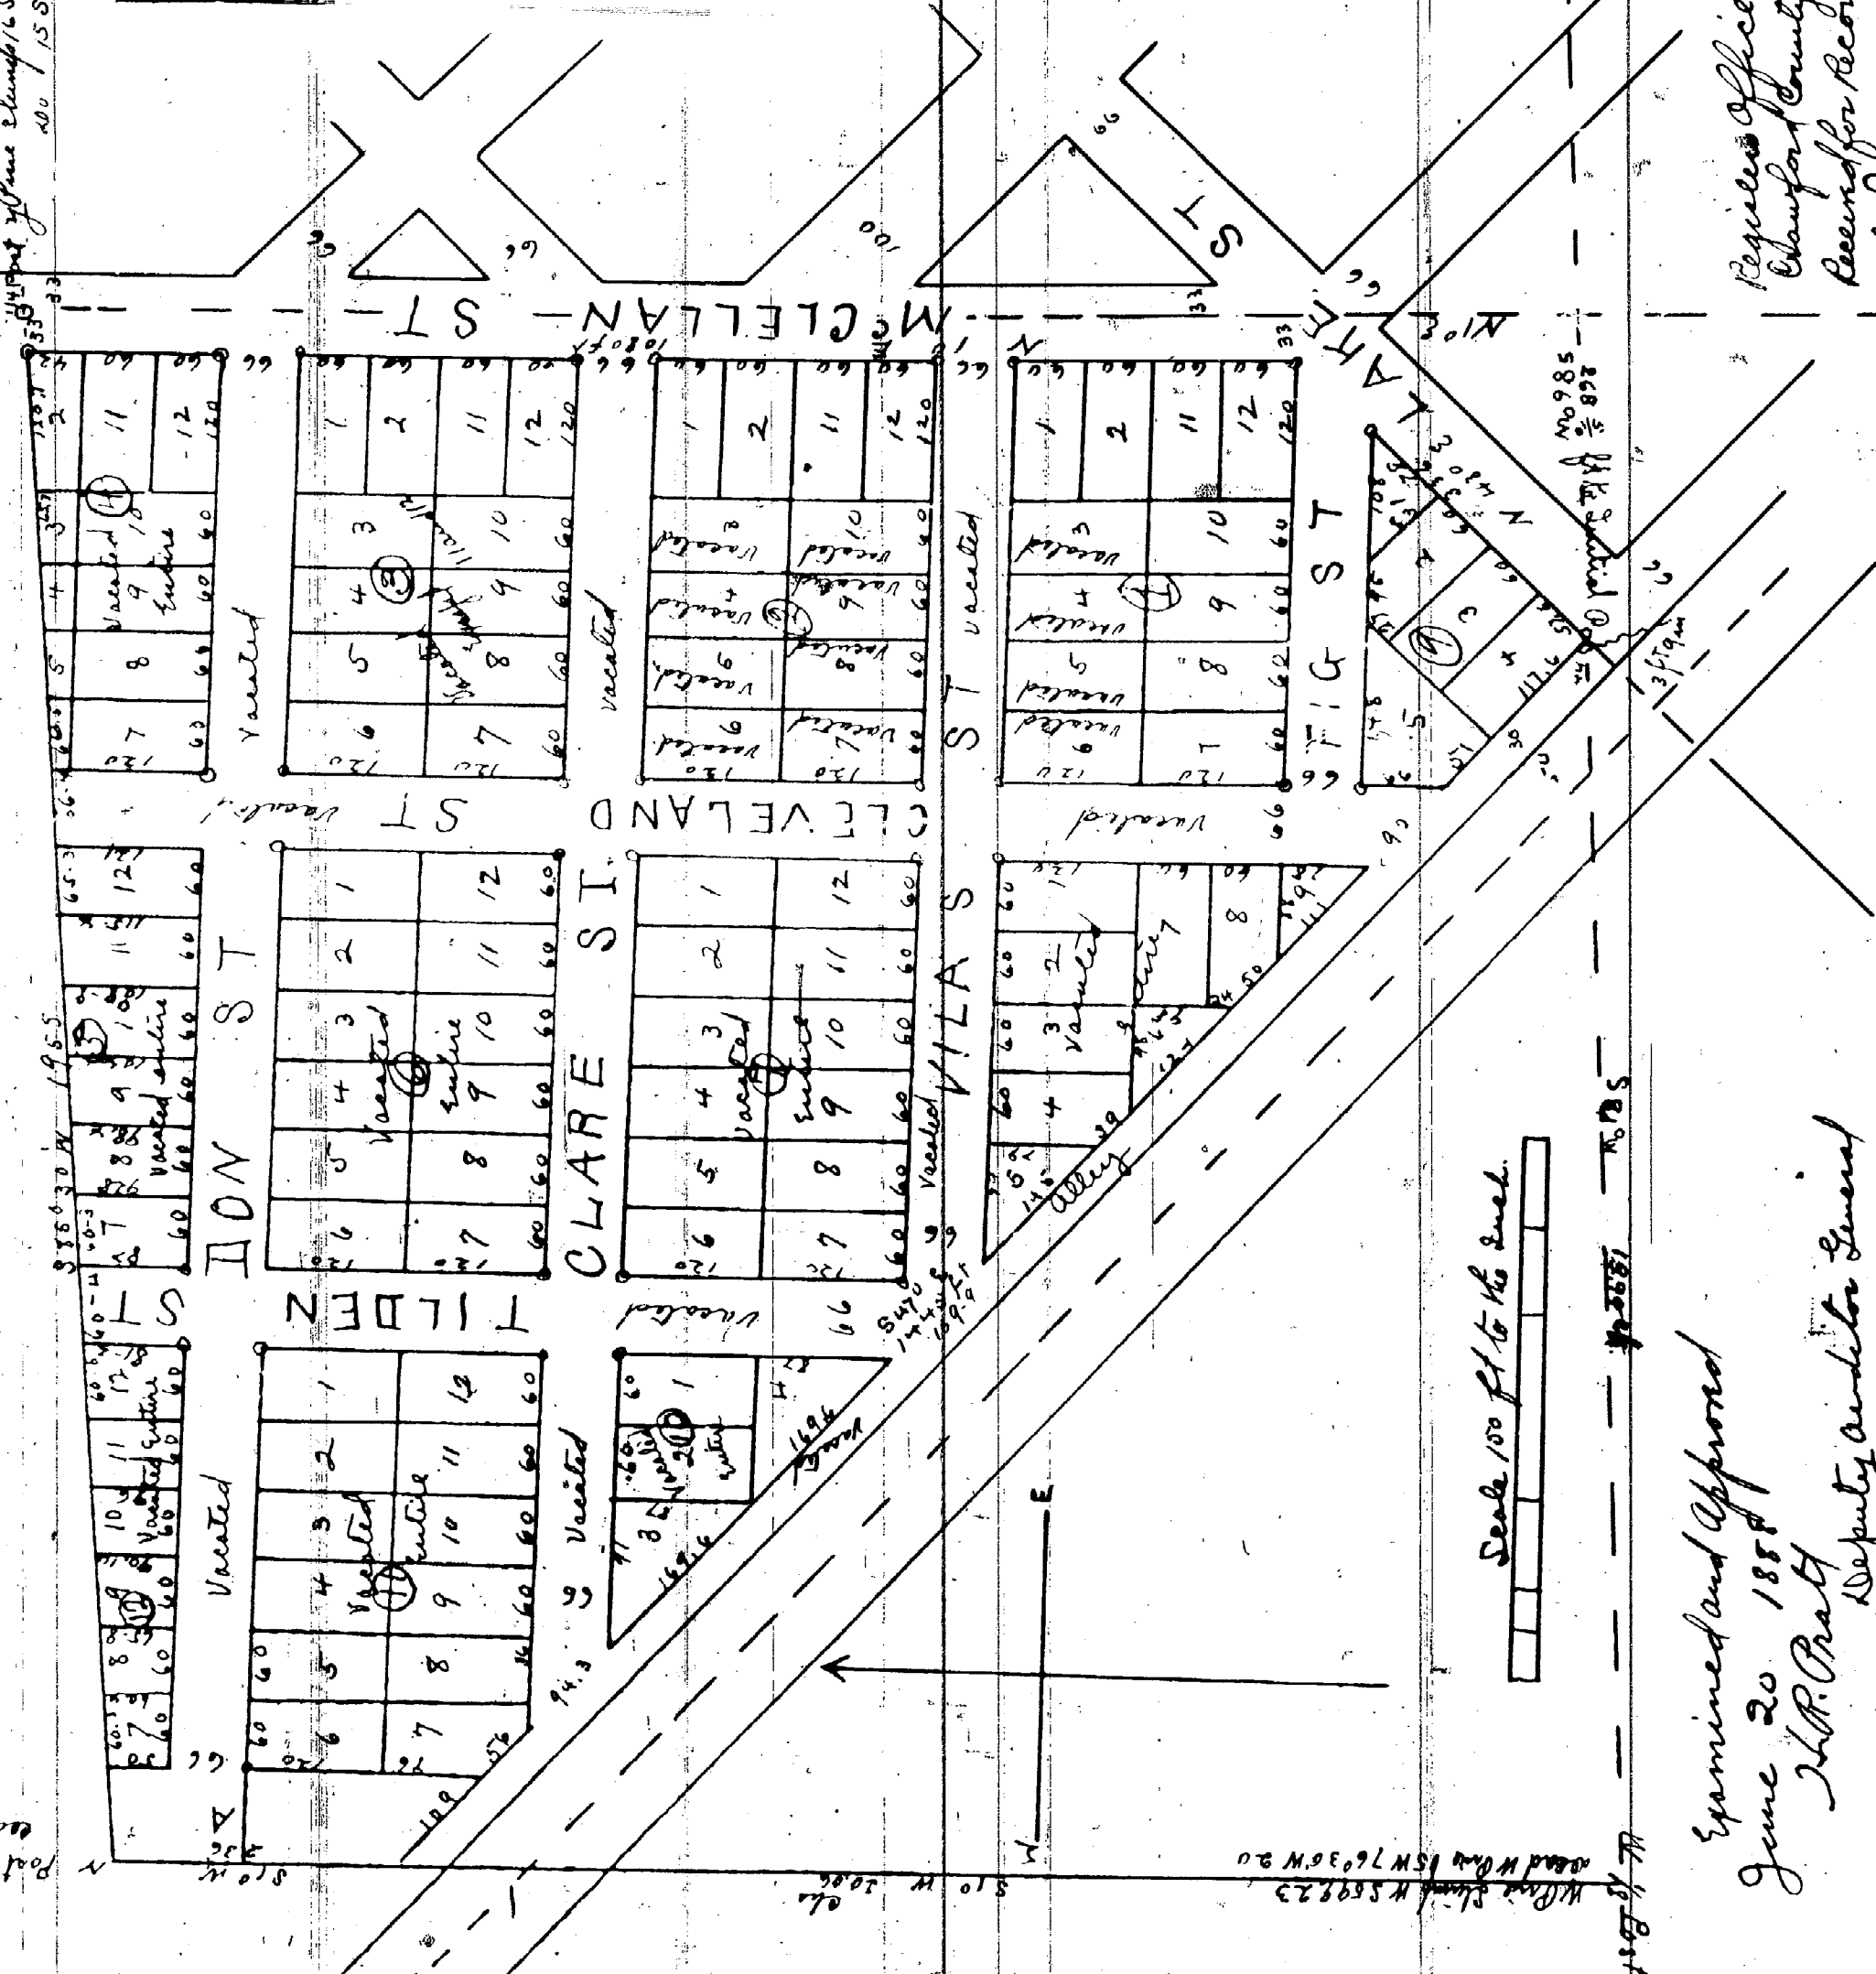

Examined and Approved

June 20, 1888

W. P. Pratt

Deputy Auditor General

State of Michigan

County of Crawford

and A. E. Newman Surveyor hereby certify that

We have each carefully compared this copy with

the original with Hadley's Third Addition, and that

it is an exact copy thereof + of the whole of

such original Plat

O. J. Bell Register of Deeds

Page 13

of July 20, 1888

at 50 Clock PM and Recorded

in Abs. 1 of Village on

Page 13

O. J. Bell Register

Register of Deeds

PLAT - HADLEY'S 3rd ADDITION VILLAGE OF GRAYLING.

C C MARCH 14-1900
C C J. Liber 1 page 401
In re petition
of Emma Hadley for the
vacation of a part
of Village Plat)


Therefore it is considered that said petition be granted and that so much of said Plat of Hadley's 3rd Addition to the Village of Grayling be and the same is hereby vacated That is to say: All of Block Three(3) except Lots eleven and twelve, All of Blocks Four(4) Five(5) Six(6) Seven(7) Eight(8) Ten(10) Eleven(11) and Twelve(12) and lots three(3) Four(4) Five(5) Six(6) Seven(7) and Eight(8) Nine(9) and Ten(10) of Block Two(2) and lots three(3) Four(4) Five(5) Six(6) Seven(7) and Eight(8) of Block One(1) together with the following named streets and alleys to wit;

All of Cleveland Street, all of Tilden Street, all of Don Street, all of Clare Street, all of Vilas Street, West of Lot one Block one, all of Fig Street West of Lot Nine of Block one and the entire alley along the Westerly side of said Plat and that the title to the land contained, in said Plat as above described and dedicated to the use of the Public for streets and alleys shall revert to and vest in the said petitioner the owner of the land adjoining the same free and clear from all right and title which the said Village of Grayling has or may have therein, by reason of the Survey and of platting thereof, and the same is hereby vested in and determined to be the property of said Emma Hadley.

Nelson Sharpe
Circuit Judge

Curts & Taylor
Plat Examiners

Vol. 150. Page-12550.

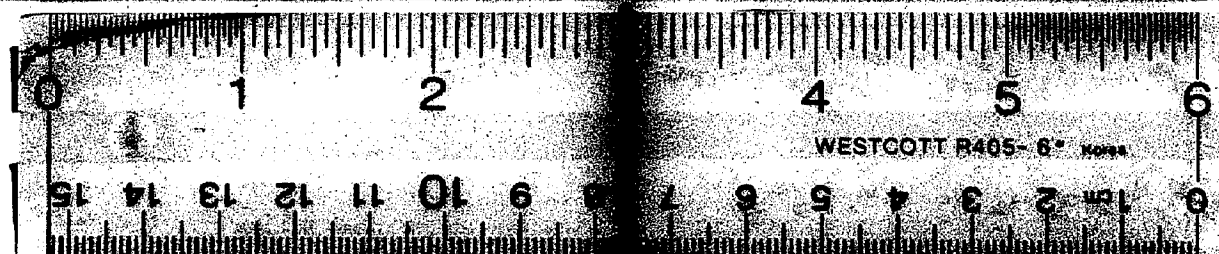

16 X