

State of Michigan
County of Bay

On this 13th day of June A.D. 1885
before me a Notary Public in and for said County
personally appeared Mary Raymond to me known
to be the same person described in and who
executed the foregoing Plat and acknowledged
the same to be her free act and deed


C. Sittmann

T.A. Delzell

Notary Public Bay Co Mich in presence of
T.A. Delzell
C. Sittmann
Witness

Acknowledgement of Surveyor
Shew all men by these presents that I George Turner Civil
Engineer and Surveyor residing in Bay City Bay County Michigan on
the application and request of Mary Raymond proprietor of the
land described in this plat did in the month of June A.D. 1885
Survey and Plat said land as it appears in said plat and that the
same was my free act and deed and that this plat is correct to
the best of my knowledge and belief in testimony whereof I
have hereunto set my hand and seal this 13th day of June A.D. 1885
George Turner Surveyor

Description
The within Plat of M. Raymond's Subdivision
of Lots 2 & 3 of Walker's Sub of Outlot Ten is situated
in the John Riley reserve in Town 14 N R 5 E Bay County
Mich. The lands of Hampton and 7th Street are continuation
in direct line of Subdivision of Streets bearing the
same name in James Tracer's 1st Addition to Lower
Laguna now Bay City. The lot 100 feet square in South
West Corner of Lot 3 of said Outlot 10 is hereby reserved
from this Plat

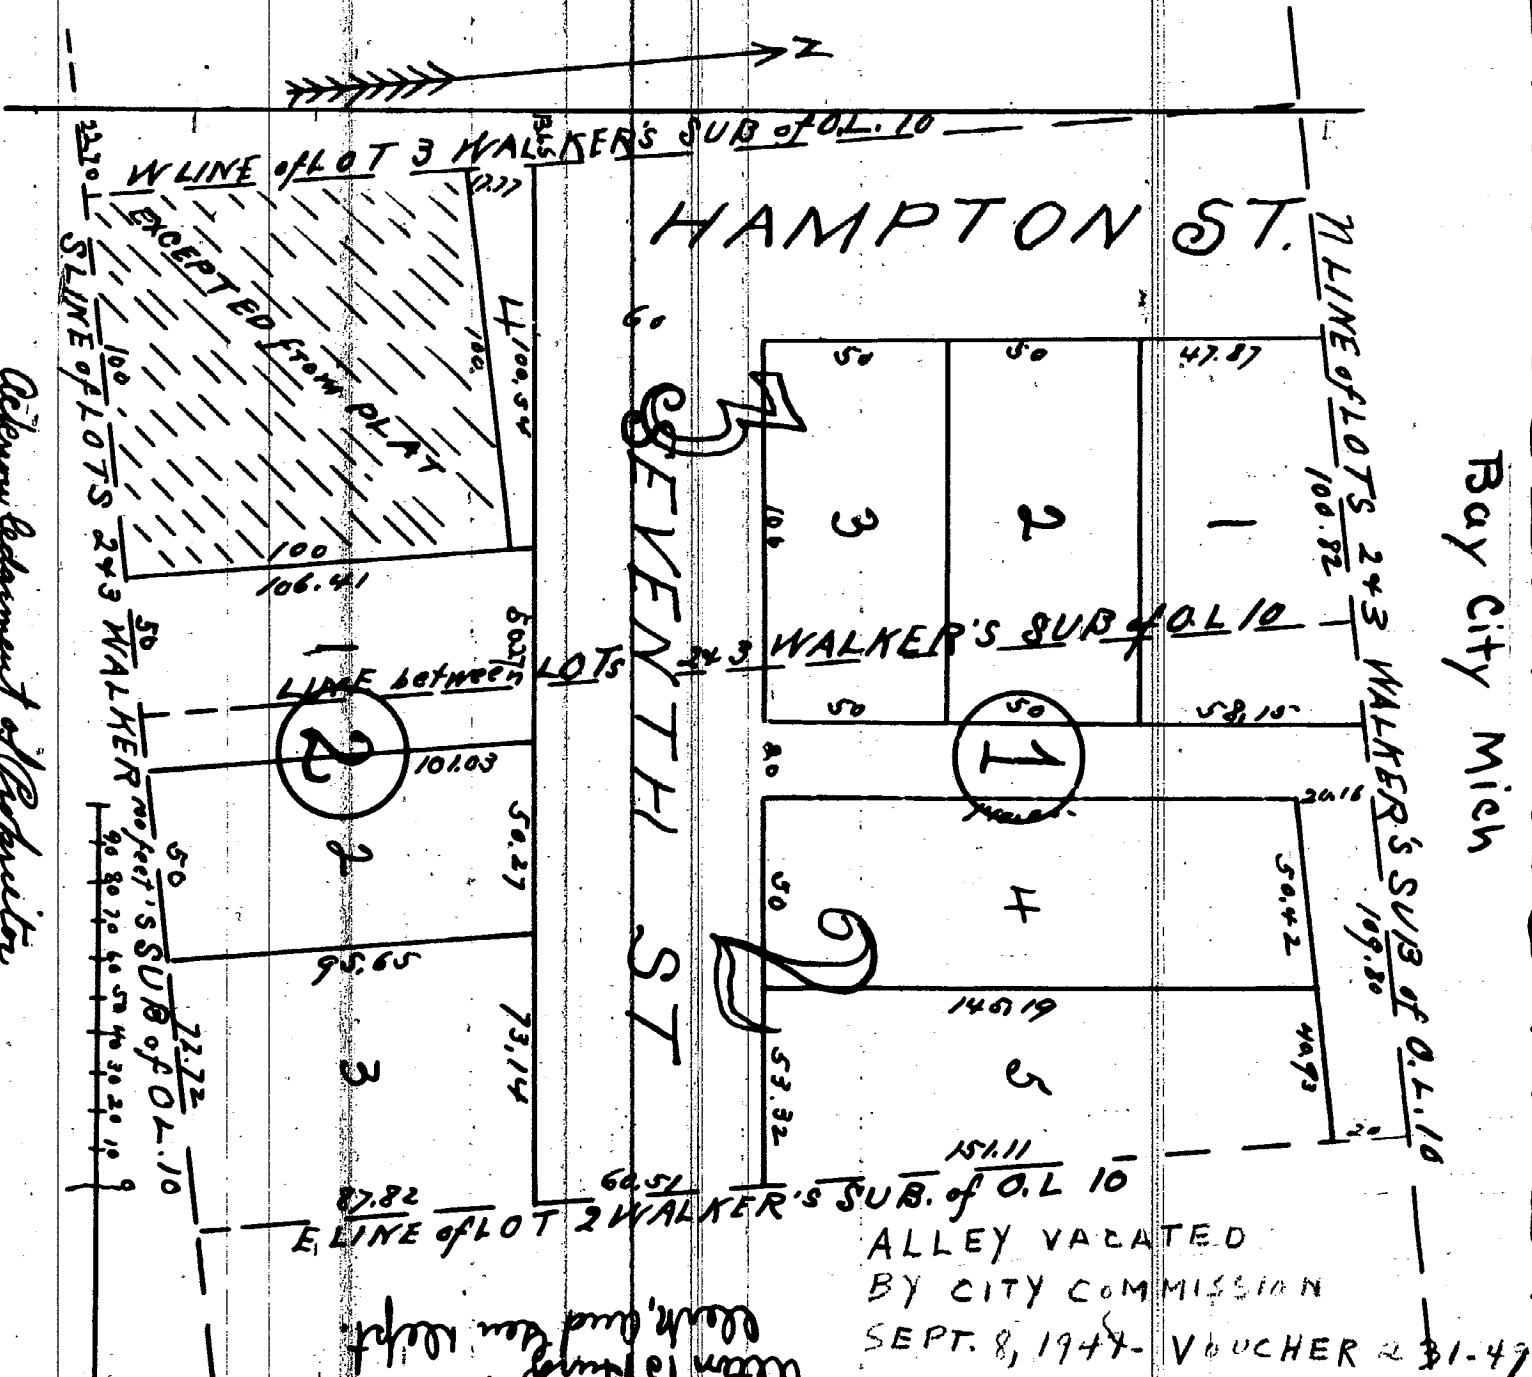

WALKERS SUB. OF OUTLOT TEN
Bay City Mich

LOT'S 2 & 3

M. RAYMOND'S
SUBDIVISION

Examined and approved
August 19th 1885
J.R. Pratt
Notary Public

Deed of M. Raymond to T.A. Delzell
I, Mary Raymond, of the County of Bay, State of Michigan, do hereby certify that the within Plat is a true and correct copy of the original Plat as the same appears in the records of the County of Bay, State of Michigan, and that the same was my free act and deed, and that this Plat is correct to the best of my knowledge and belief in testimony whereof I have hereunto set my hand and seal this 13th day of June A.D. 1885
C. Sittmann
Notary Public Bay Co Mich

Recorded in the
County of Bay
Michigan
at 5 o'clock P.M. and recorded in page 50 of
Platbook No. 2
9/10/1886
John Sargent for Register

State of Michigan
County of Bay
I, John Sargent, Register of the County of Bay, Michigan, do hereby certify that the within Plat is a true and correct copy of the original Plat as the same appears in the records of the County of Bay, State of Michigan, and that the same was my free act and deed, and that this Plat is correct to the best of my knowledge and belief in testimony whereof I have hereunto set my hand and seal this 13th day of June A.D. 1885
John Sargent for Register

Shew all men by these presents that I George Turner Civil Engineer and Surveyor residing in Bay City Bay County Michigan on the application and request of Mary Raymond proprietor of the land described in this plat did in the month of June A.D. 1885 Survey and Plat said land as it appears in said plat and that the same was my free act and deed and that this plat is correct to the best of my knowledge and belief in testimony whereof I have hereunto set my hand and seal this 13th day of June A.D. 1885
George Turner Surveyor

Deed of M. Raymond to T.A. Delzell
I, Mary Raymond, of the County of Bay, State of Michigan, do hereby certify that the within Plat is a true and correct copy of the original Plat as the same appears in the records of the County of Bay, State of Michigan, and that the same was my free act and deed, and that this Plat is correct to the best of my knowledge and belief in testimony whereof I have hereunto set my hand and seal this 13th day of June A.D. 1885
C. Sittmann
Notary Public Bay Co Mich