



ET ARK and HANNA'S addition to ONTONAGON.

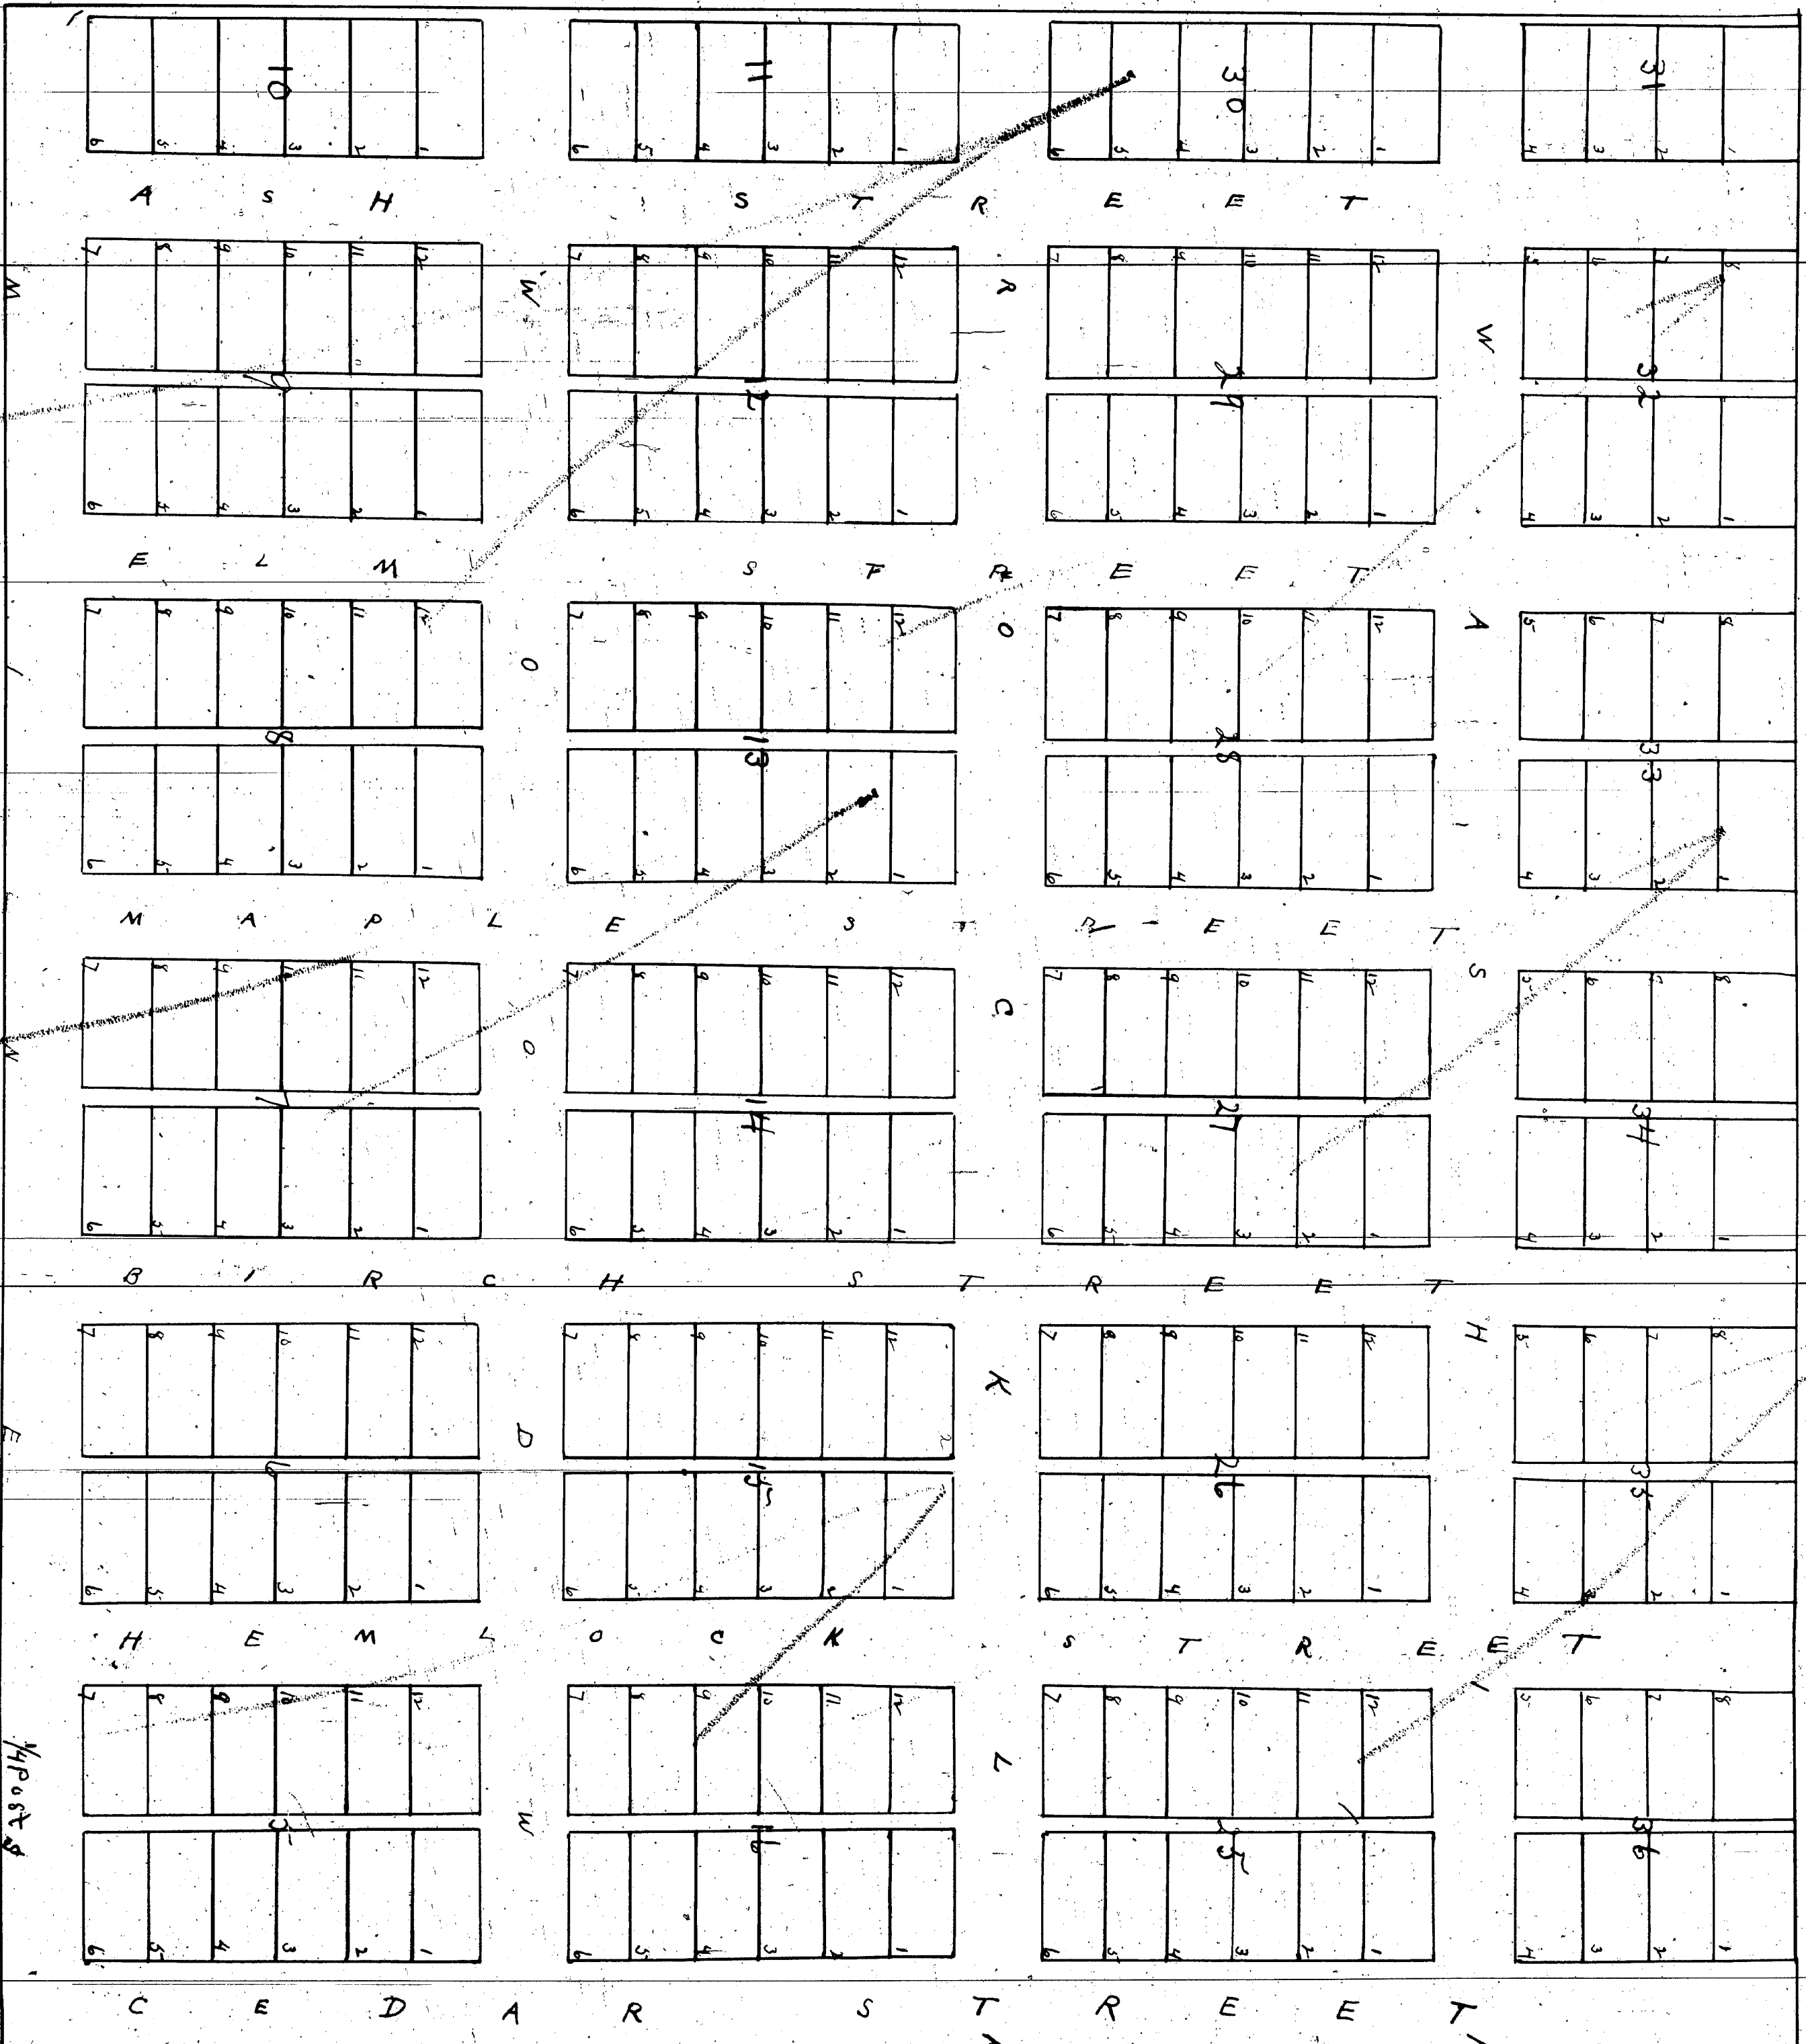


Reference

Lots 50 feet by 100 feet
Streets 66 feet wide
Alleys 13 feet wide
Scale 100 feet to an inch

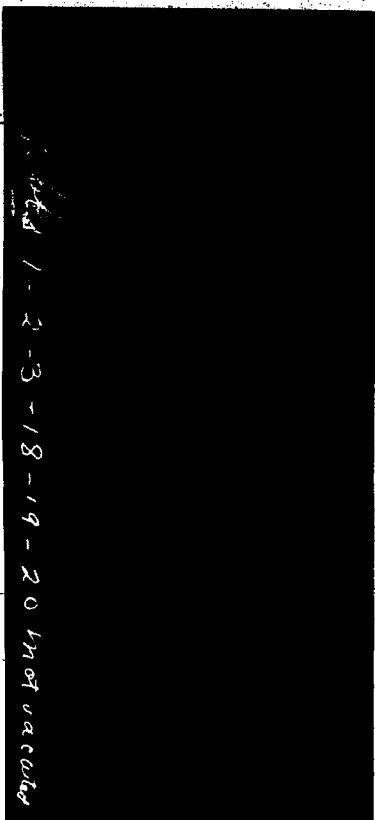

CLARK and HANNA'S addition to ONTONAGON.

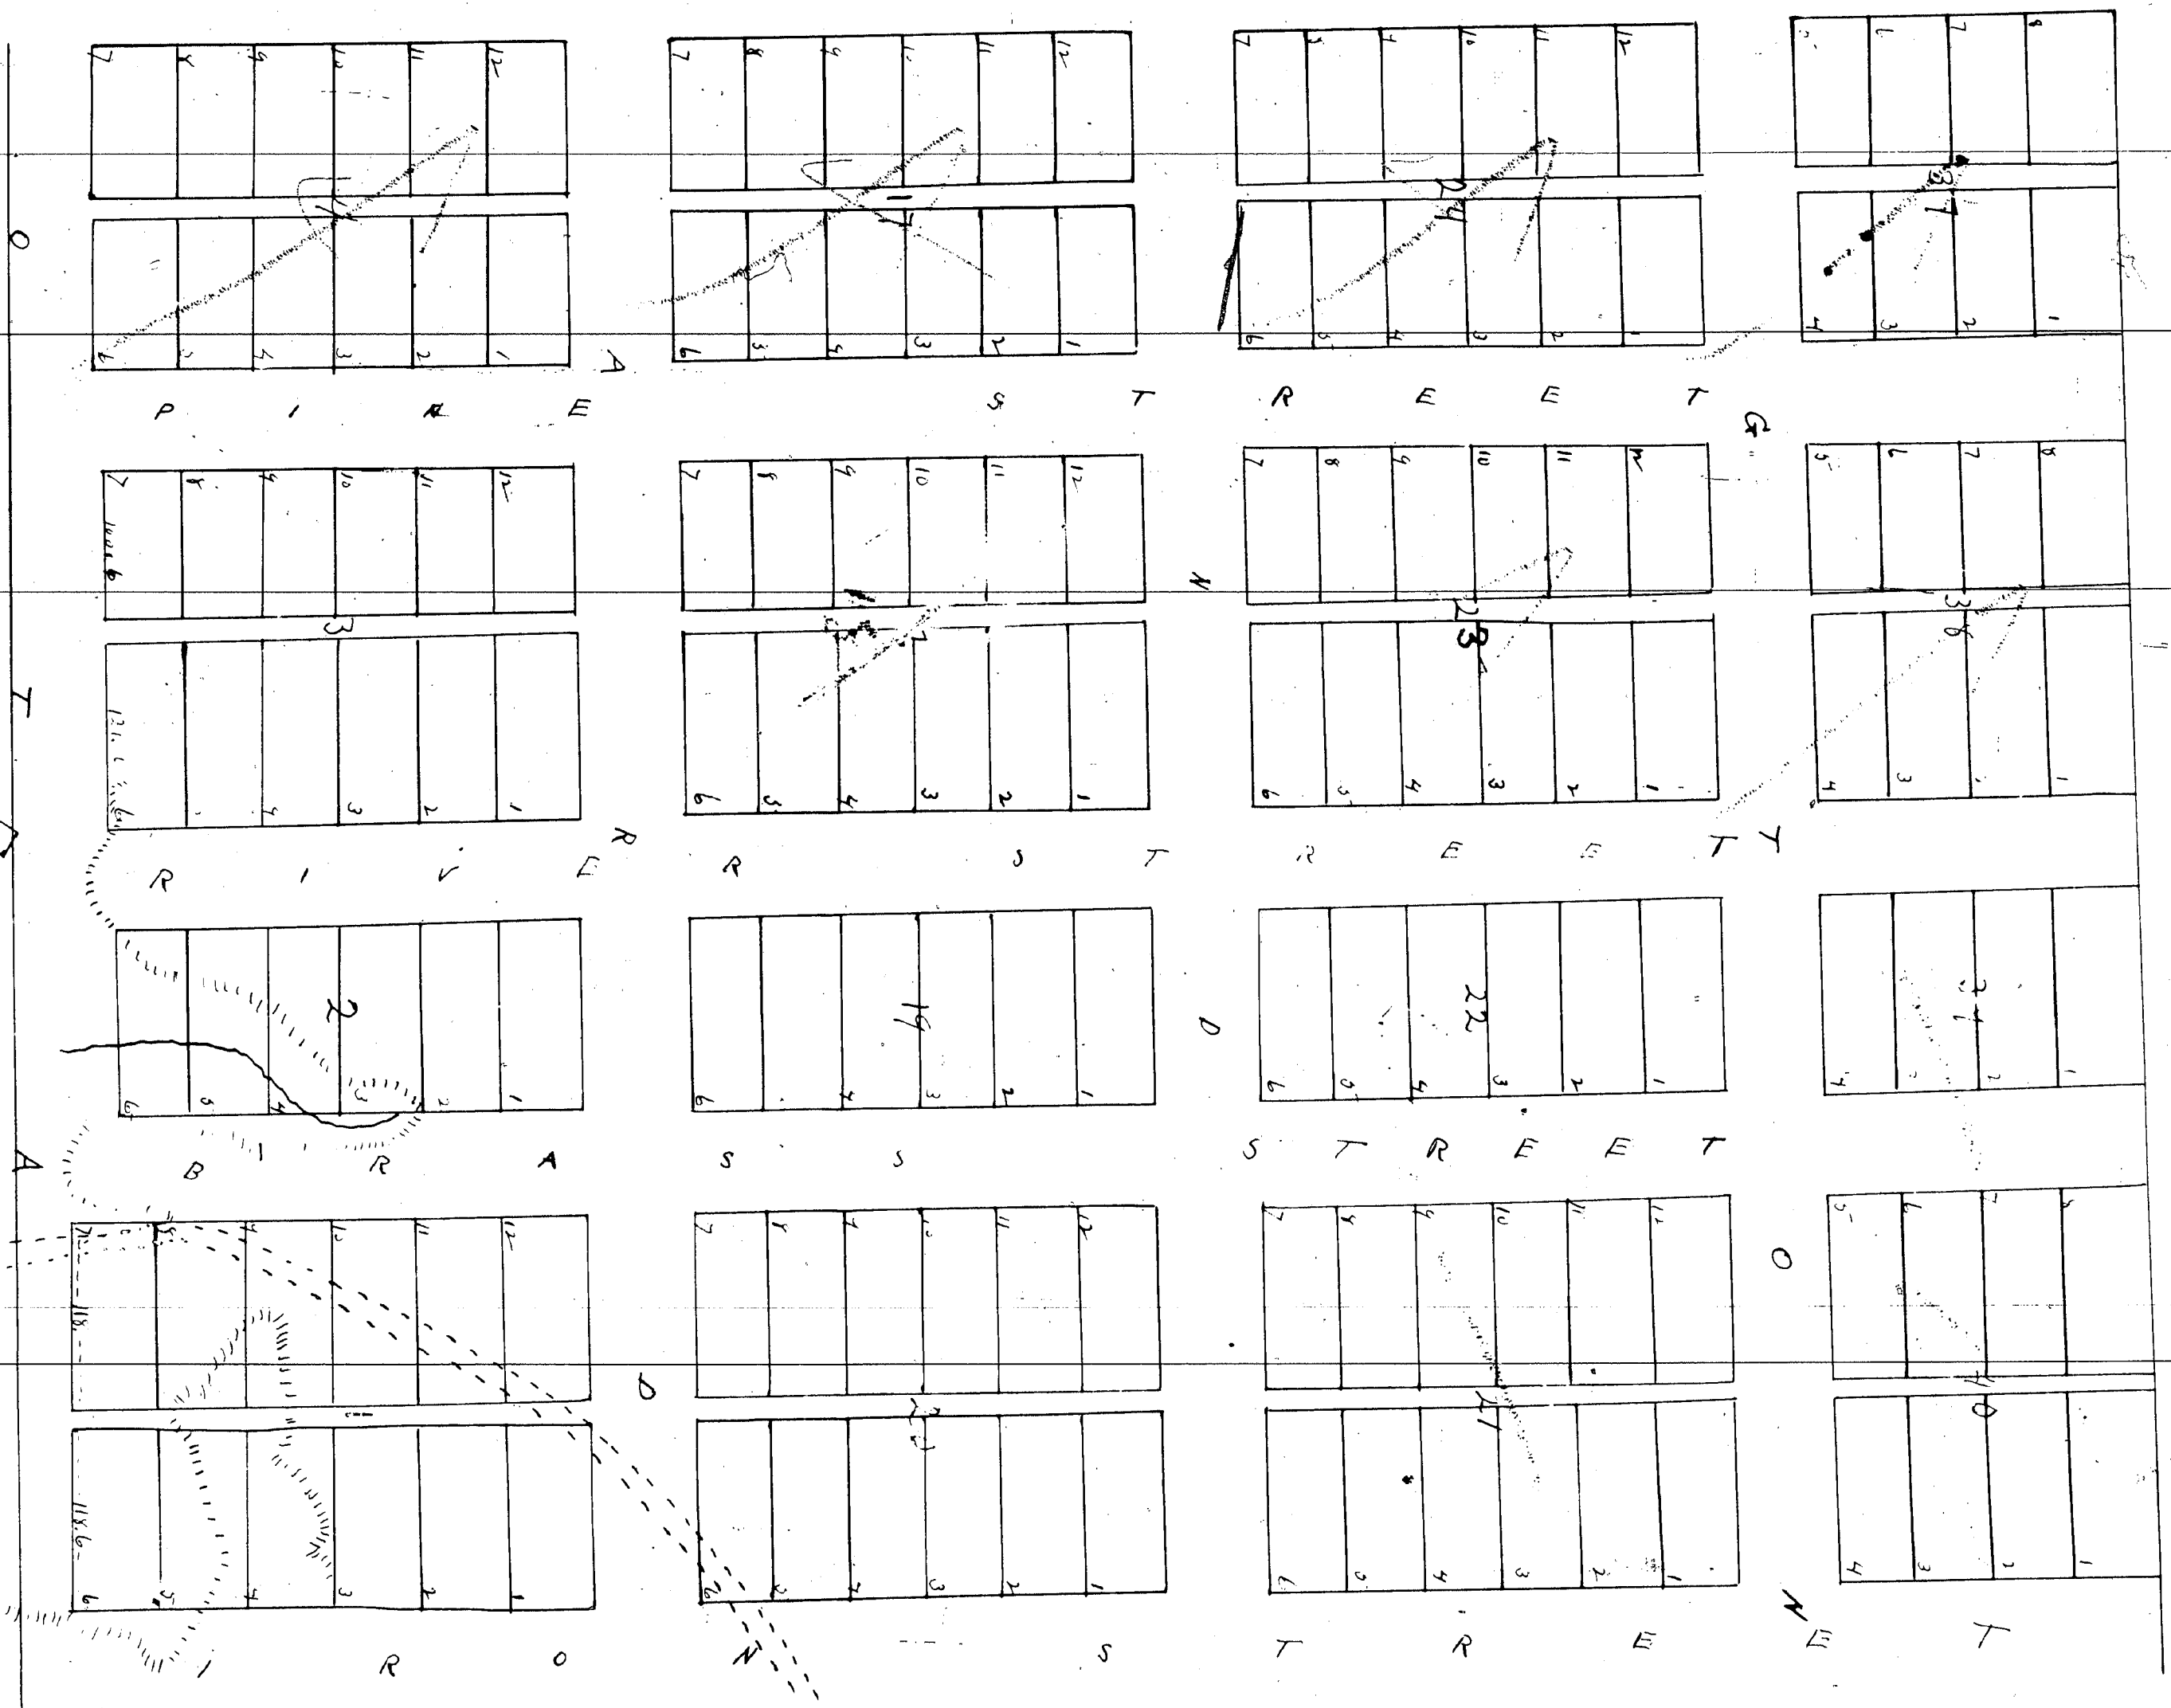

All of Clark & Hanna's addition to the Village of Ontonagon consisted of Block 111 two (2) and three (3) eighth (1/8) section (1/9 & twenty (2) and that part of Iron Street, Green Street & Clark Street that lie between Minnesota Avenue and Rockland Avenue and as much of Rockland Avenue and Minnesota Avenue as lies between Iron Street and Pine Street. See sketch map of town.

November 17, 1964

Dorothy G. Aubrey
Village Clerk
Ontonagon, Michigan

RESOLUTION TO VACATE PORTION OF BRASS STREET IN
CLARK AND HANNA'S ADDITION TO THE VILLAGE OF
ONTONAGON, ADOPTED NOVEMBER 9, 1964

In order to post our records, it will be necessary
that we have a sketch showing its location.

BILLIE S. FAHRIN
Auditor General

By
Amy Van Driesen
AVD:jc

STATE OF MICHIGAN)
County of Ontonagon) ss

On this 12th day of November, A.D., 1964, before me, a
Notary Public in and for said County, appeared BERNARD GUZEK and
DOROTHY G. AUBREY, to me personally known, who, being by me duly
sworn, did each for himself say that they are respectively the
President and Clerk of the Village of Ontonagon and executed the
within instrument in accordance with the Resolution passed at the
meeting of the Village of Ontonagon Board of Trustees held on
November 9, 1964; that the seal of the Village of Ontonagon is
affixed to said instrument and that said Bernard Guzek and
Dorothy G. Aubrey acknowledged said instrument to be the free act
and deed of said Village of Ontonagon.

Fred J. Glaser
Notary Public, Ontonagon County, Michigan
My Commission Expires: _____

FRED J. GLASER
Notary Public, Ontonagon County, Mich.
My Commission Expires Feb. 3, 1965

ORDER VACATING STREET

At a regular meeting of the Board of Trustees of the Village
of Ontonagon held on the 9th day of November, A.D., 1964, the
following Resolution was offered by Trustee William Labine,
supported by Trustee Walter Younk, and unanimously carried:

WHEREAS, The Board of Trustees here assembled, in accordance
with the public notice duly published in the Ontonagon Herald
issues of October 22, 1964, October 29, 1964, and November 5, 1964,
and the notices posted in three public places in the Village of
Ontonagon, scheduled a hearing on the vacation of part of Brass
Street in the Village of Ontonagon to be held at this time and
place, and there being no objections thereto;

NOW, THEREFORE, BE IT RESOLVED, By the Board of Trustees of
the Village of Ontonagon, in accordance with the Statutes in such
case made and provided, that all that part of Brass Street
contained in the following description, to-wit:

That portion of Brass Street lying between
Blocks 19 and 20 in Clark and Hanna's Addition
to the Village of Ontonagon,

be and the same is hereby vacated; subject, however, to a
reservation of a right-of-way over and across, through and under
said property for the purpose of installing therein such public
utilities as shall be deemed necessary or convenient to the
interests of the Village of Ontonagon.

BE IT FURTHER RESOLVED, That a certified copy of this Order
of Vacation be recorded in the Office of the Ontonagon County
Register of Deeds by the Village Clerk and the Clerk is hereby
instructed to forward a copy of this said Order of Vacation to the
Auditor General of the State of Michigan, State Capitol Building,
Lansing, Michigan


VILLAGE OF ONTONAGON

By Bernard Guzek
Bernard Guzek, President
By Dorothy G. Aubrey
Dorothy G. Aubrey, Clerk

James M. Rose
Witness:
Stanley J. Cone

ONTONAGON VILLAGE

Plat of a Portion of Clark & Hanna Addition
Methodist Church Property
Scale 1"=40'

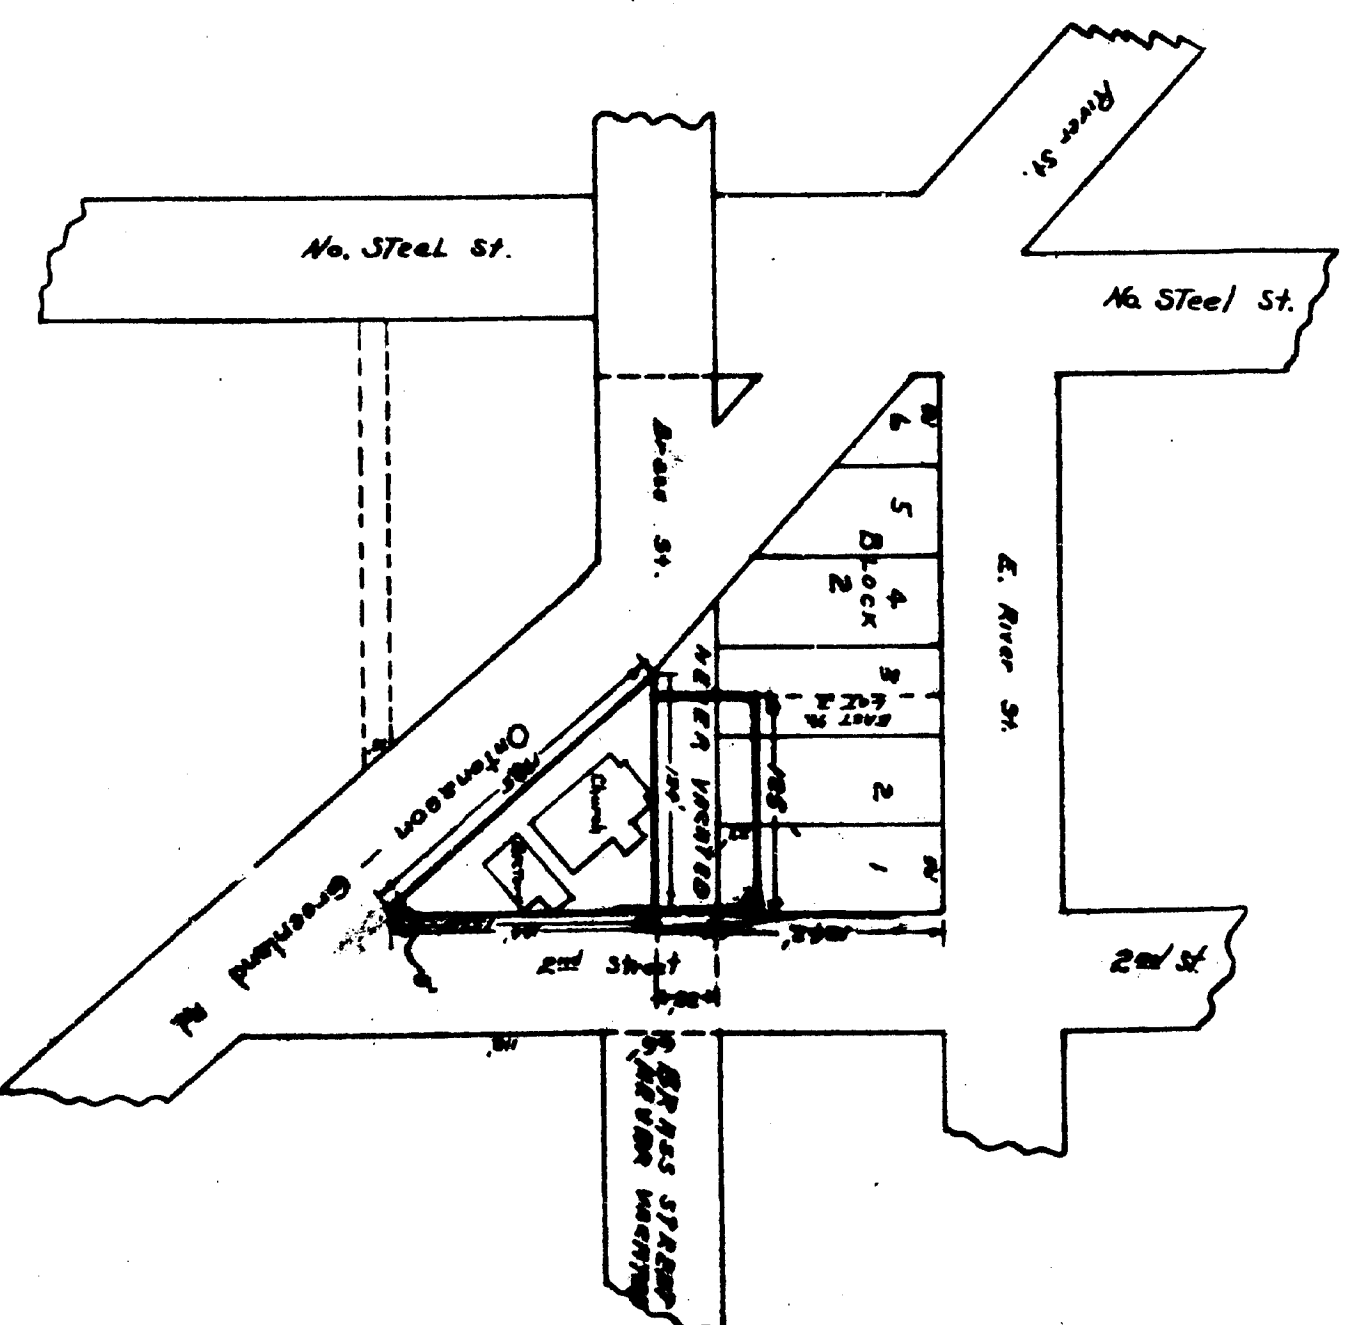

Ontonagon County Vacations

✓ PLAT- CLARK & HANNA'S ADDITION TO THE VILLAGE OF ONTONAGON

In re petition)
Levi Hanna to)
Vacate part of)
PLAT)
BLOCKS Excepted)
ALLEYS)

STREETS Excepted.-


ORDERED: That all of Blocks, Streets and Alleys
in said Addition Excepting BLOCKS 1,2,3,18,19 and 20,
and the ALLEYS running through said BLOCKS and
Excepting also following streets and parts of Streets
in said Addition;
IRON Street and that part of BRASS Street and RIVER St;
that lies between Minnesota Avenue and Rockland Ave;
And so much of ROCKLAND, WOODWARD and MINNESOTA AVENUES
as lie between Iron Street and Pine Street- be and the
same is hereby VACATED.

Order Judge D. Goodwin
June 27, 1868.
Page 364-5 District Court Jour

Aud Gen Dept Vol
151
Page ~~12673~~
12677 ✓

Eddy & Bennett
Plat Examiners
September 1915

188

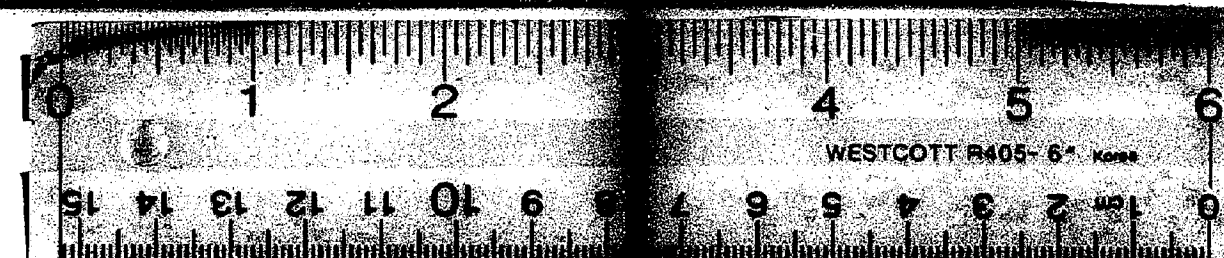

16 X