

Know all men by these presents that James F Watson and Charlotte A. Watson, his wife of Inness County of Cheboygan State of Michigan proprietors and owners of Watsonville Lands have had the same surveyed and subdivided into lots, streets and alleys as set forth and fully described by the annexed plat or map denominated Watsonville to wit: a portion of Lot Number two (2) in fractional section number six (6) in town number thirty seven North of Range number one (1) West being in the township of Inness County of Cheboygan and State of Michigan. Now therefore in consideration of the premises the said James F Watson and Charlotte A. Watson his wife as aforesaid do hereby dedicate and convey to public use for ever all the streets and alleys laid down in the annexed plat aforesaid Cheboygan road being sixty six (66) feet in width, the streets being fifty (50) feet in width and the alleys being twenty (20) feet in width Mill Street extends east from Cheboygan road to within five (5) feet of Cheboygan river the same to be used only as public highway.

In witness whereof the said proprietors as aforesaid have hereunto set their hands and seals this 6th day of April A.D. 1872.


Signed in presence of
Jno. Edwards
Wm N Maullby
Wm N Maullby

James F Watson LS
Charlotte A Watson LS

State of Michigan } On this 6th day of April A.D. 1872
County of Cheboygan } before me the subscriber a Notary Public for said County personally appeared James F Watson and Charlotte A. Watson his wife to me known to be the persons who signed the foregoing instrument and acknowledged the same to be their free act and deed, And the said Charlotte A. Watson on a private examination separate and apart from her said husband acknowledged that she executed the same freely and without compulsion from anyone
Wm N Maullby Notary Public
for said County

I hereby certify that this plat is a correct copy of the plat now on record in the Register of Deeds office being made under the supervision of the Auditor General by tracing the plat on record and affixing thereto a carefully compared copy of the dedication and certificate

Dated this 20th day of June 1911
John B La Fountaine
Clerk and Ex. Secy.

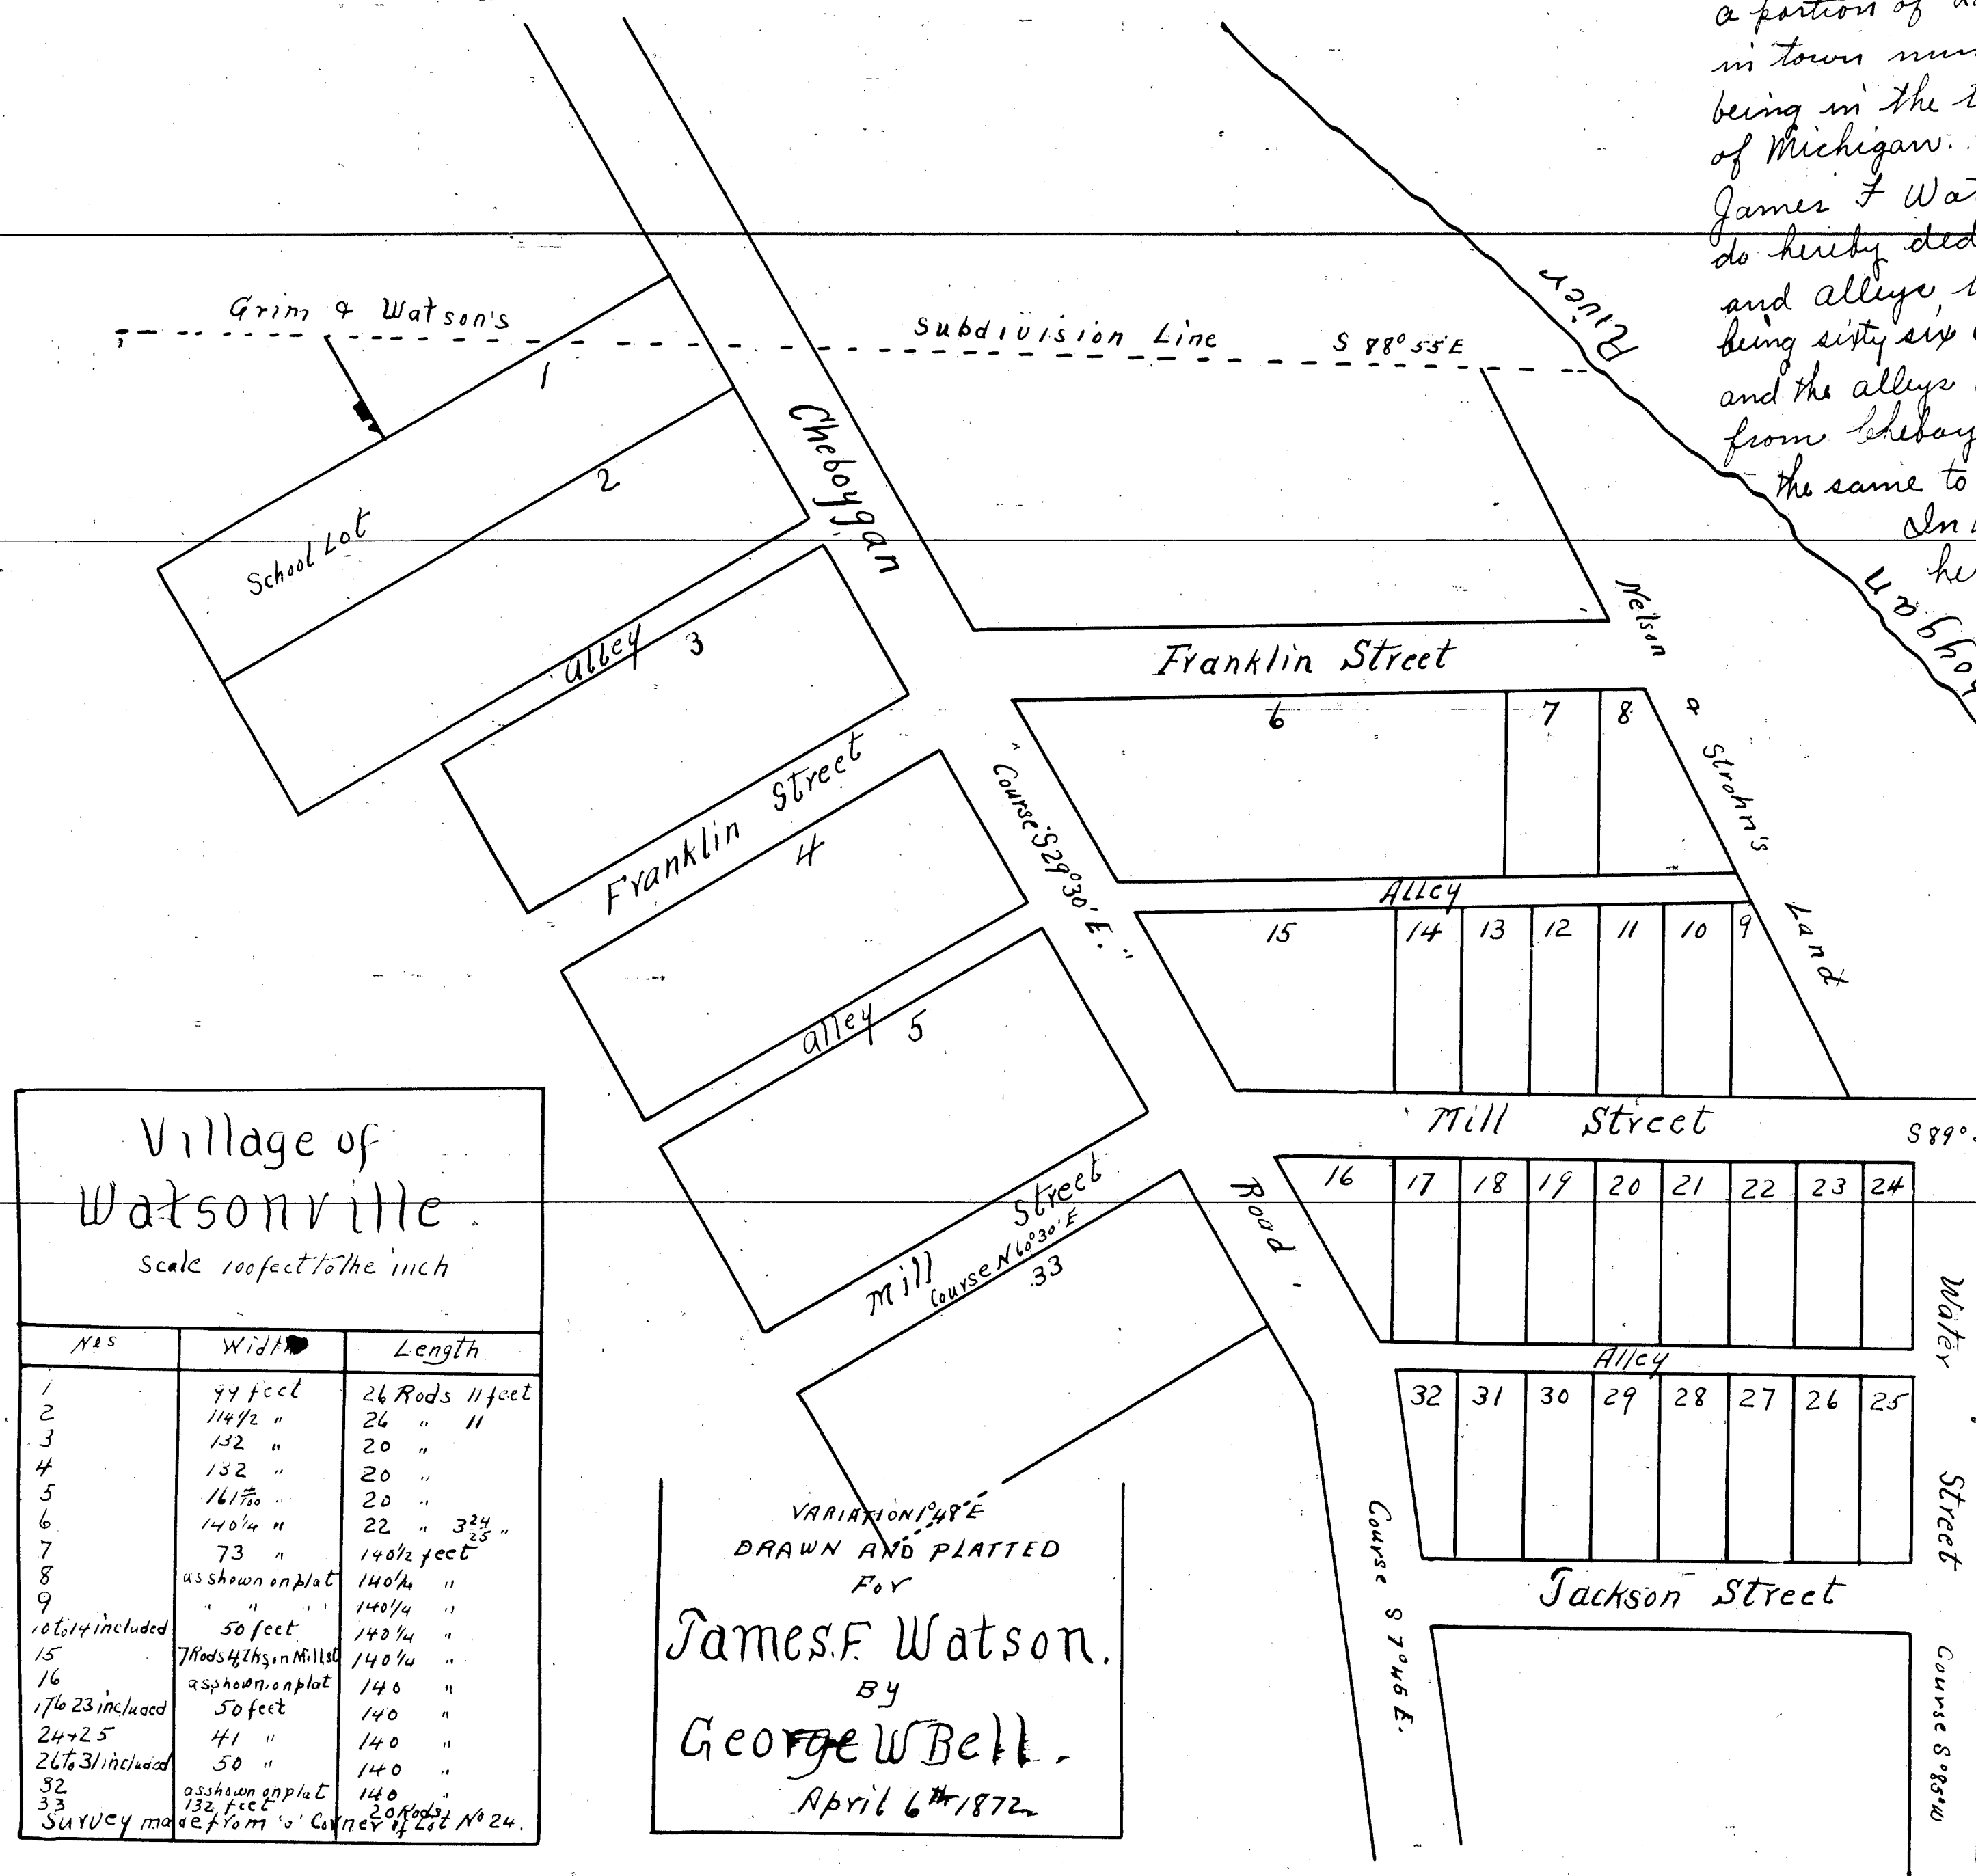

Village of Watsonville		
Scale 100 feet to the inch		
Nos	Width	Length
1	94 feet	26 Rods 11 feet
2	114 1/2 "	26 " "
3	132 "	20 " "
4	132 "	20 " "
5	161 7/10 "	20 " "
6	140 1/4 "	22 " 3 24/25 "
7	73 "	140 1/2 feet
8	as shown on plat	140 1/4 "
9	" "	140 1/4 "
10 to 14 included	50 feet	140 1/4 "
15	7 Rods 4 1/2 ins. in Mill St	140 1/4 "
16	as shown on plat	140 "
17 to 23 included	50 feet	140 "
24 to 25	41 "	140 "
26 to 31 included	50 "	140 "
32	as shown on plat	140 "
33	132 feet	20 Rods 20 feet
Survey made from 'a' Corner of Lot No 24.		

VARIATION 1° 48' E
DRAWN AND PLATTED
FOR
James F. Watson.
BY
George W Bell.
April 6th 1872

DEC 6 5 1987

12689

At a Regular City Council Meeting held in the Council Chambers
in the City Hall, 202 Backus Street, Cheboygan, Michigan, 49721,
the following motion was passed:

Motion by Krawczewski supported by Charboneau to vacate the
SWly 20 ft. of Lot 4, Village of Watsonville adjacent to Plaza
27, also the Wly 30 ft. of Franklin Street adjacent to the
described alley to Plaza 27.

Yes votes: Councilmen, Ranks, Ostwald, Charboneau, Striebich,
Mayor Muschell, Krawczewski and Henderson

No votes: None

Absent: None

I, Patricia J. St. Jean, City Clerk of the City of Cheboygan,
certify that this is a true and correct copy taken from the
Minutes of the Regular City Council Meeting of November 24,
1987.

Patricia J. St. Jean
Patricia J. St. Jean,
City Clerk
City of Cheboygan

MAY 27 1994

Cheboygan

CERTIFICATION

At a Regular City Council Meeting held in the Council Chambers in the City Hall, 202 Backus Street, Cheboygan, Michigan 49721, the following motion was passed:


Motion by Hansen supported by Verwys to grant the request for portion of an alley vacation - McDonald's - Rozek Enterprises, Inc. - legal description as follows: Com. N.W. cor Lot 5, ~~th N.W. 1/4~~ of ~~Sec. 16~~ th N.W. 1/4 to S.W. cor Lot 4, th N.E. along S line Lot 5, th S.W. 20.0 ft to point of beginning of this description.

Yes votes: Council Members, Krawczewski, Hansen, Verwys, Charboneau, Olson and Mayor LeBlanc

No votes: None
Absent: Councilman Oxley

I, Leona M. Kwiatkowski, City Clerk of the City of Cheboygan, certify that this is a correct and true copy taken from the Regular City Council Meeting Minutes of May 25, 1994.


Leona M. Kwiatkowski
Leona M. Kwiatkowski,
City Clerk
City of Cheboygan

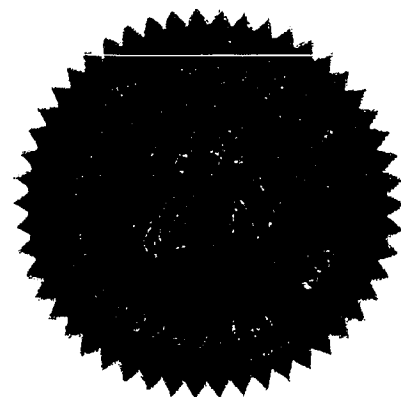

YELLOW - vacated May 24, 1994
GREEN - previously vacated

VILLAGE OF WATSONVILLE

DRAWN AND PLATTED
FOR
JAMES F. WATSON
BY
GEORGE W. BELL
APRIL 6 1872

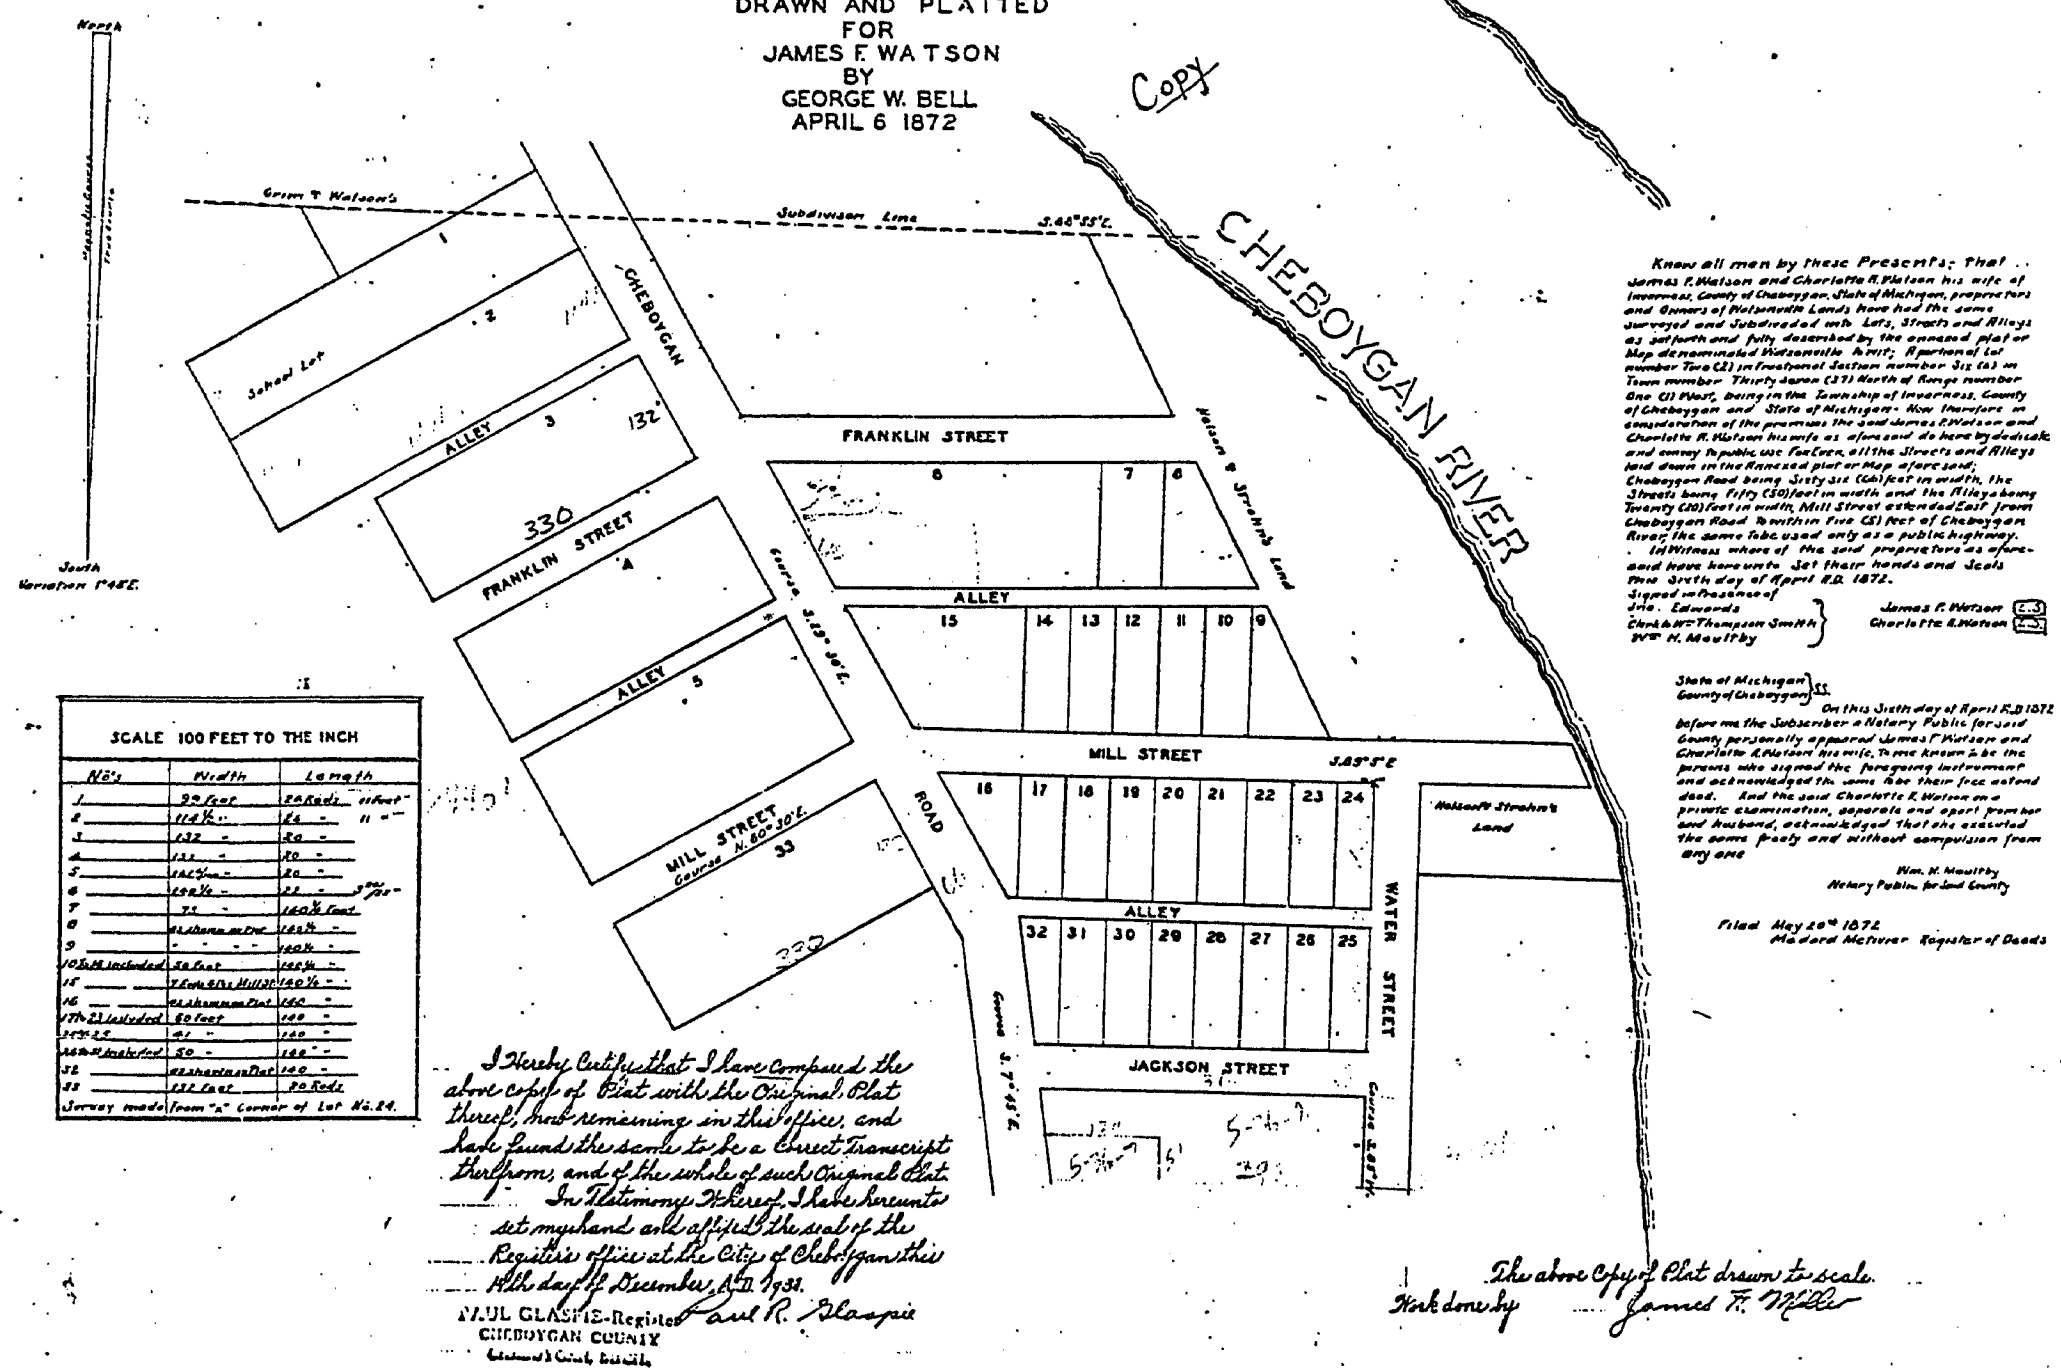

55-W58