


CONNOR'S Subdivision of the North half of
Out Lot 185 **RIVARD FARM** in the City of
Detroit, Wayne County, Michigan.
T2S. R.12E.

J. E. Munro Surveyor

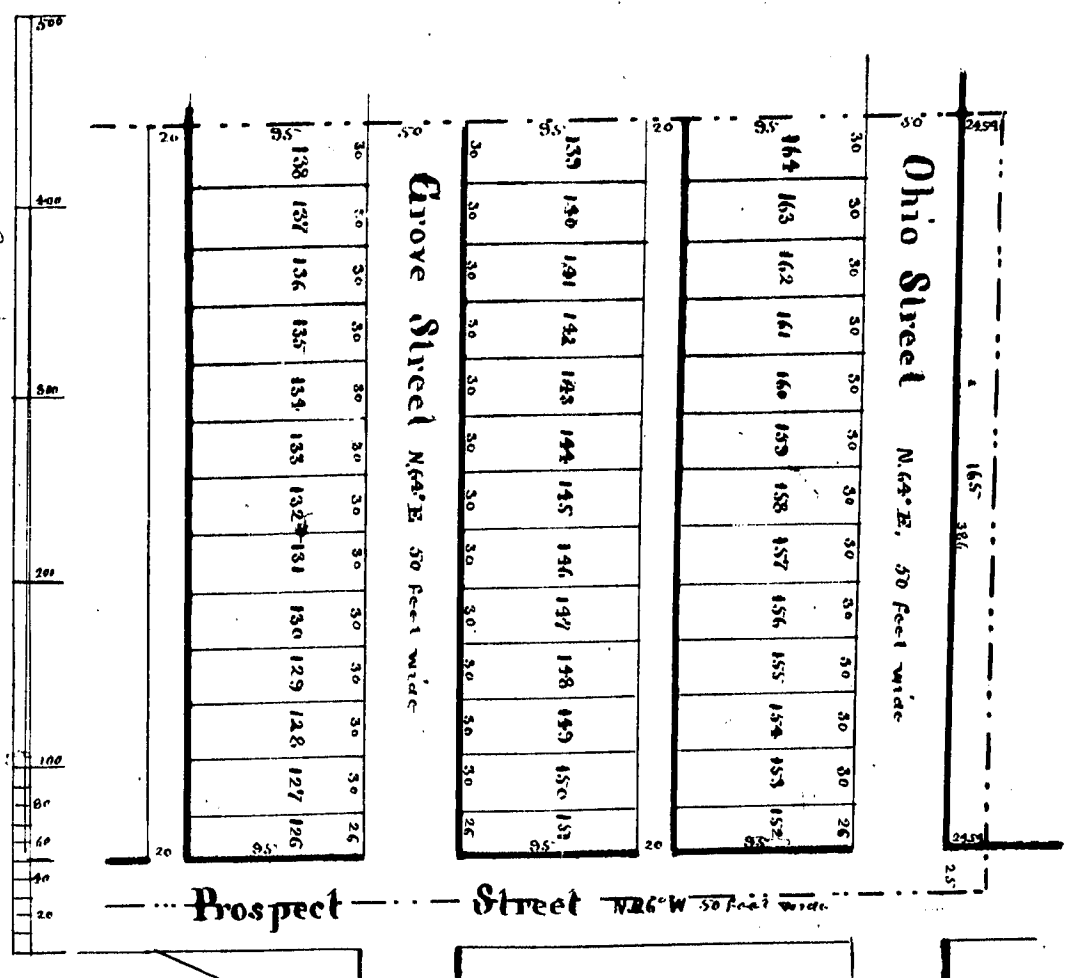

Received and Filed in Auditor
General's Office,
Oct 16 1876
J. E. Munro
Deputy Auditor General.

Where all men by their persons that the Richard W. Connor
and Catherine Connor his wife of the Town of Green Point, Wayne
County, Michigan, do hereby advertise to the Public the proposed
sale of the above and all other as hereinafter on the plat known
pursuant to the order of the Court and Register the proceeds thereof
whereof the same may be returned to the said Richard W. Connor and
Catherine and also the said wife of the said Richard W. Connor
eight hundred and seventy five

Catherine Connor

§ 2023

State of Michigan
County of Wayne

In this case of the said Richard W. Connor and Catherine Connor his wife of the Town of Green Point, Wayne County, Michigan, do hereby advertise to the Public the proposed sale of the above and all other as hereinafter on the plat known pursuant to the order of the Court and Register the proceeds thereof whereof the same may be returned to the said Richard W. Connor and Catherine and also the said wife of the said Richard W. Connor eight hundred and seventy five

J. E. Munro
Surveyor

Richard W. Connor
Catherine Connor
Wife of Richard W. Connor

The Charles Dupont Registry of Deeds for the County of Wayne, Michigan
and John H. Munro Surveyor do hereby certify that we have carefully compared the
plat of Connor's Subdivision of the North half of Out Lot 185 known as the
City of Green Point, Michigan, with the one here of record in the Registry
Office of Wayne County, Michigan and we also certify that it is a true and correct
copy of the whole of said record


Charles Dupont
Registry
John H. Munro, Surveyor

State of Michigan
County of Wayne
Received for Record July 20 1876
at 230 O'clock P.M. and recorded on the
3d of August on page 82
Charles Dupont
Registry

J. H. Munro Sup

Pratt's Office

Advert

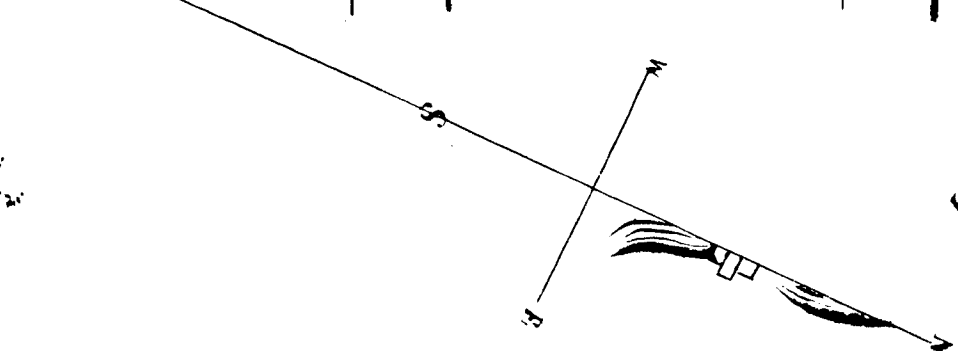

John L. Moore Junr.

to the year 1860, and will be a great benefit to the State, and to the people, and to the country, and to the world.

Alfred
McLary, Dallas

Chloroform

12/18/89
 Chas. M. and
 Fred. M.

Hand of J. J. J. J. J.

I have all now by these means that the husband of Thomas
 and Catherine Thomas the wife of the Henry Thomas Smith, began
 to write in 1840, to her by writing to the father of the first son
 one of the children and to her as a reference in the first known
 reference to Catherine's son and to her the person known
 as the same way to be identified by her. William and
 Thomas and also the
 William Thomas and John of the

recorder and

Mar. of. Morgan }
County of Morgan }

country of Haywards } for the
day of June in the
year eighteen hundred and seven I was
born at Haywards, in the county of Alameda,
California, U. S. of America, to the late
William H. the same farmer, now dead, and the said
Johnnie, now dead, and the said William, now
living, being taken
and I was reared the same in that place, so
confabulate from ~~the~~

In *Charles Lyndon* Lyndon of 'Lundy' for the County of Weymouth, Wiltshire
and John William Lyndon, do hereby certify that we have compared the
Book of Records, Distribution of the eighth part of land till 1535 thence down in the
14th of Edward, Weymouth, Wiltshire, with the one now of record in the County
Office of Weymouth, Wiltshire and do also certify that it is a true drawing of the
Book of the eighth part of such Record

Edward Tufant
John H. Moore, Jr.

Edt. of Buchanan }
Secretary of State }

Received for deposit 20th Feb 1895

at 2.30 O'clock. J. D. M. in
33 of Plate on page 82

Abundant in fruit.
Argentina

City Engineering Department
Honorably City Council July 24, 1989
Re: Petition No. 4389(a), Community and Economic Development Department, Wholesale Distribution Center Rehabilitation Project No. 2 McDonald's Parcel Alley to Vacate, east-west public alley in the block bounded by Chrysler Fwy., Rivard, Eliot and Mack.
To develop properties in Wholesale Distribution Center Rehabilitation Project No. 2 (McDonald's Parcel) it is necessary to vacate the east-west public alley, 20 feet wide, in the block bounded by the Chrysler Freeway, Rivard and Eliot Streets, and Mack Avenue.
The public alley closing was approved by the Department of Transportation.

Satisfactory arrangements have been made with all City departments and privately-owned utility companies.
An appropriate resolution is attached for consideration by your Honorable Body.

Respectfully submitted,
CLYDE R. HOPKINS
Director

By Council Member Peoples:

Resolved, All of the east-west public alley, 20 feet wide, in the block bounded by the Chrysler Freeway, Rivard and Eliot Streets, and Mack Avenue lying northerly of and abutting the north line of Lots 139 to 151; also lying southerly of and abutting the south line of Lots 152 to 164 in the "Plat of Connor's Subdivision" of the North Half of Outlot No. 185, Rivard Farm, Town 2 South, Range 12 East, City of Detroit, Wayne County, Michigan as recorded in Liber 3, Page 82, Plats, Wayne County Records; Be and the same is hereby vacated as public alley right-of-way to become a part and parcel of the abutting property, and be it further
Resolved, Pursuant to the Court ruling in Center Line v. Michigan Bell Telephone Co., 26 Mich. App 659 (1970), aff. 387 Mich. 260 (1972), the Community and Economic Development Department is hereby authorized to process billings from utility companies and others for the relocation of their equipment in connection with this urban renewal project; and further
Provided, That a certified copy of this resolution shall be recorded by the Community and Economic Development Department with the Wayne County Register of Deeds.

STATE OF MICHIGAN) ss. SHORT FORM - TRUE COPY CERTIFICATE
CITY OF DETROIT)

I, JAMES H. BRADLEY, CITY CLERK of the City of Detroit, do hereby
certify that the annexed paper is a True Copy of a Resolution
adopted by the City Council on August 2nd, 1989
and approved by the Mayor on August 3rd, 1989
as appears from the Journal of said City Council, on file in my office.

IN WITNESS WHEREOF, I Have hereunto
set my hand and affixed the Corporate
Seal of said City, at Detroit, on



September 19th, 1989

James H. Bradley
City Clerk

Adopted as follows:
Yeas — Council Members Cleveland, Collins, Eberhard, Hood, Kelley, Mahaffey, Peoples, Ravitz, and President Henderson — 9.
Nays — None.

MAP ATTACHED
LI 24342
PA 347
Rec'd 9-20-89

127
OCT 17 1989

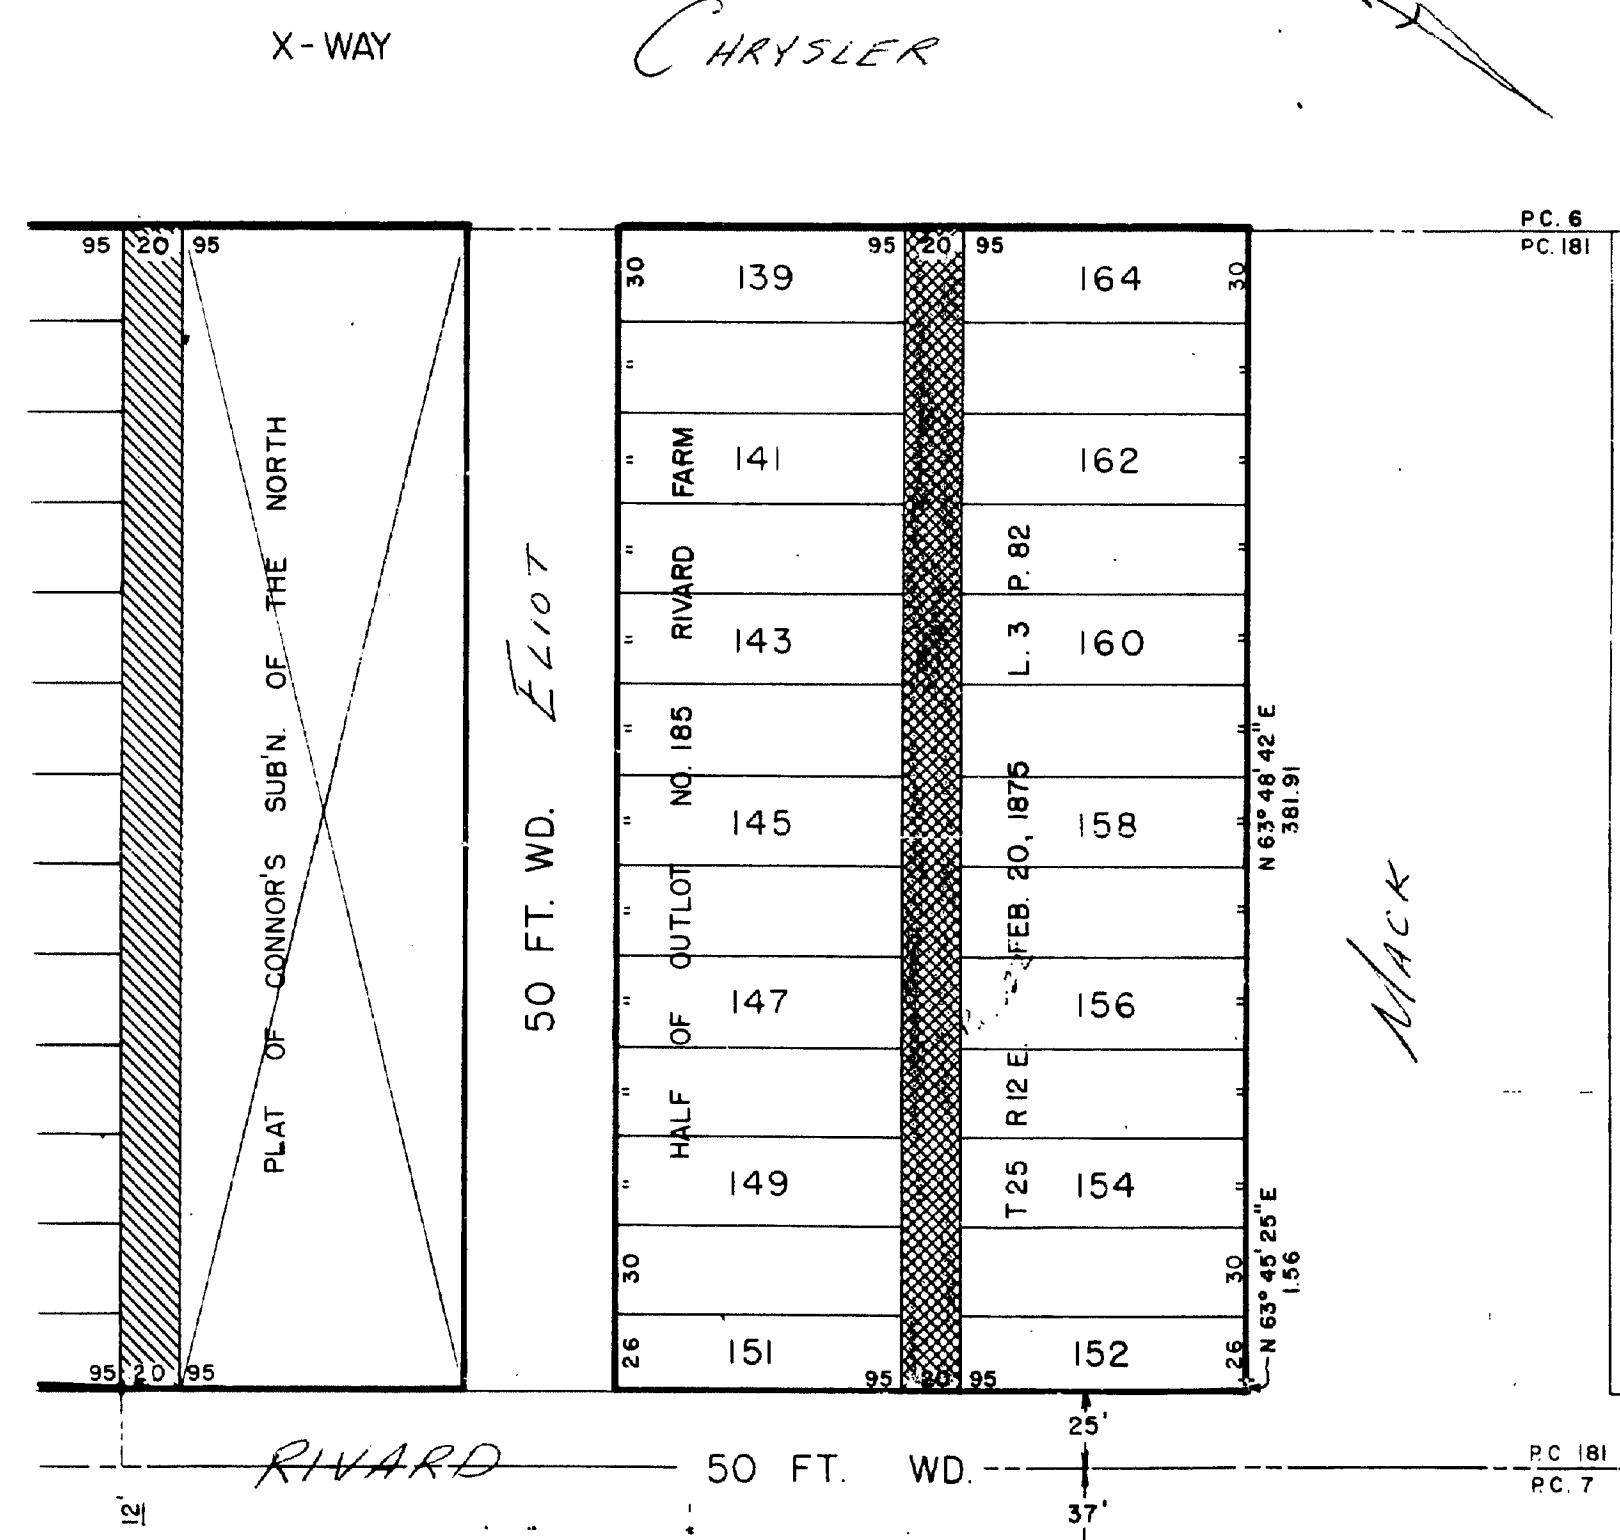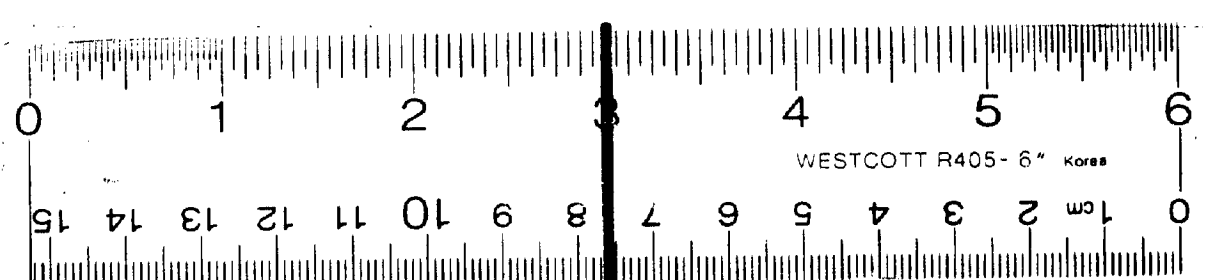

16 X