


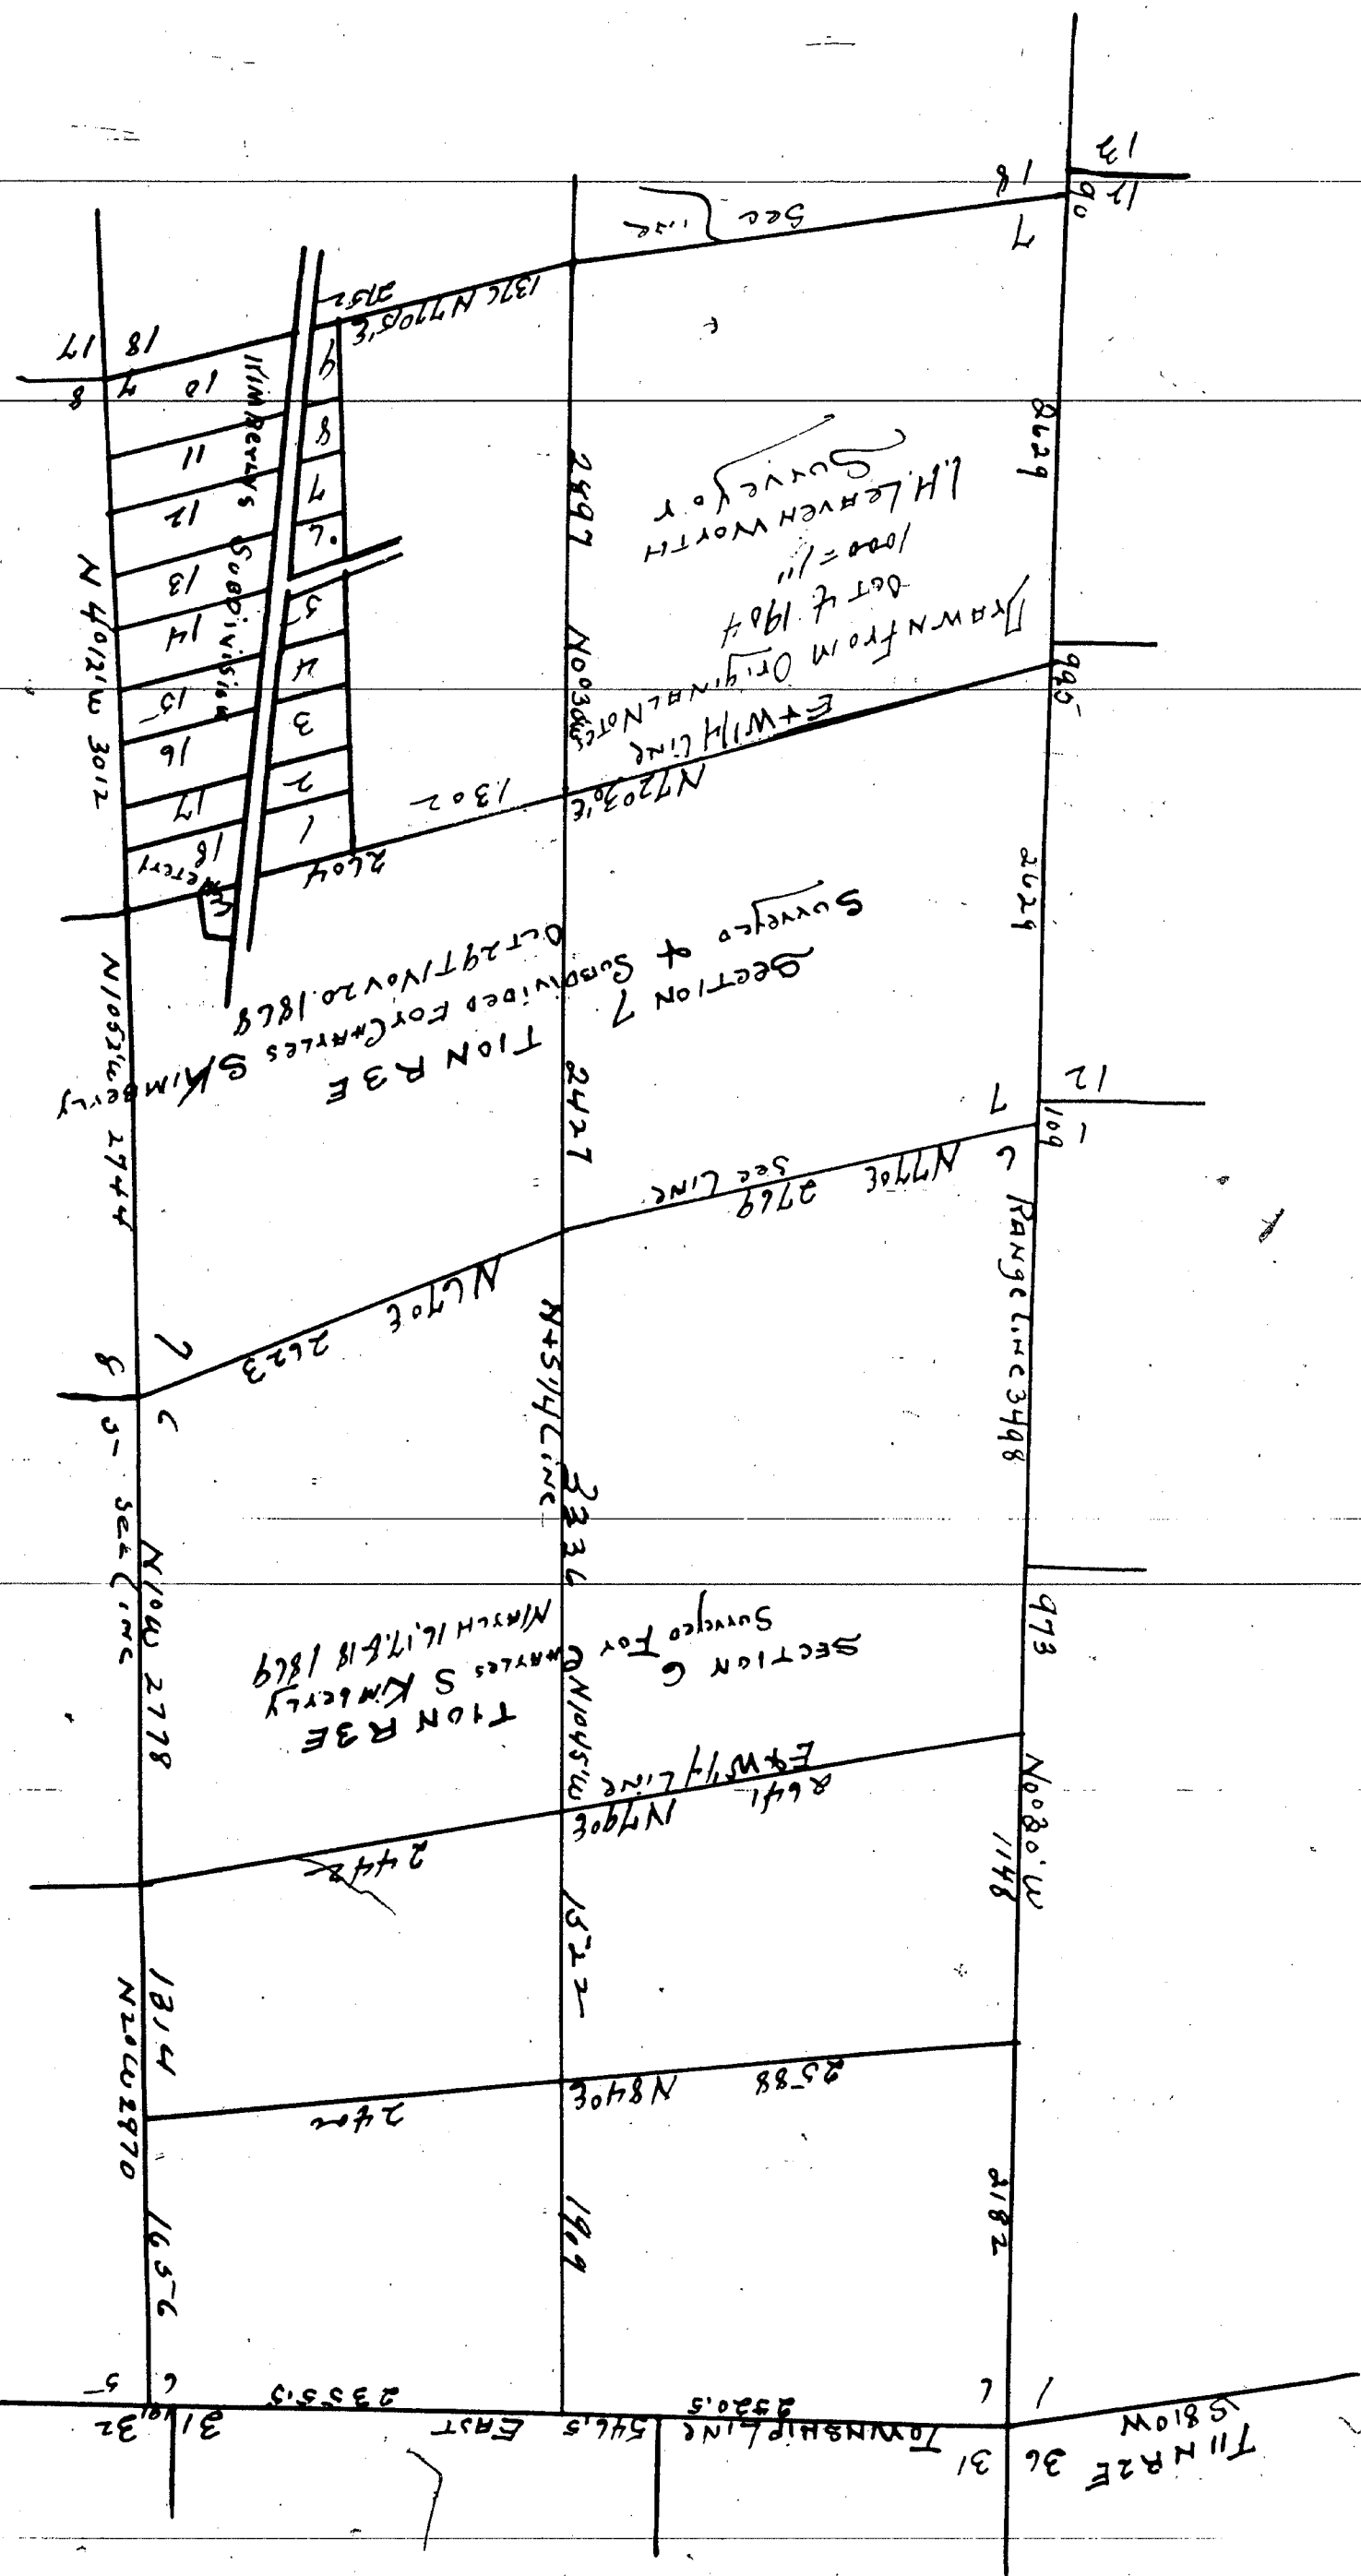

I hereby certify that the Plat is a correct copy of the
Plat now on hand in the Registry of Deeds office, being
made under the supervision of the Assessor General
of said city and county.

Wm. H. Johnson of St. Louis 1901

Wrote this 21st day of June 1911

Prof. H. Warner, New York.