

SERIAL No. 5852

AUDITOR GENERAL'S OFFICE,

Lansing, Mich. June 6 1874


WILLIAM F. TURNER'S

ADDITION TO THE VILLAGE OF STANTON.

MAY 9TH, 1874.

Received and filed  
in Auditor General's  
Office June 15, 1874  
H. R. Pratt  
S. J. Anderson

Wm F. Turner  
Stanton Mich  
Your plat of W. F. Turner's  
addition to Stanton is herewith  
returned for the certificate required by  
the law as found about the middle of  
page 144 Vol 1 laws of 1873.  
I return the \$1.00 recd with the  
plat less postage - Send a dollar  
when the plat is corrected & returned.  
Does the description of the  
land platted as written correspond  
with the plat itself; the written  
description reads "Hoff's of N. 1/4 Sec 1  
10 N - 7 W except a strip &c" - the plat  
shows Hoff's of N. 1/4 1-10 N - 7 W except  
a strip &c and a strip off W side of  
N. 1/4 of N. 1/4 6-10 N - 6 W if I correctly  
understand it  
Very Resp H. R. Pratt  
S. J. Anderson

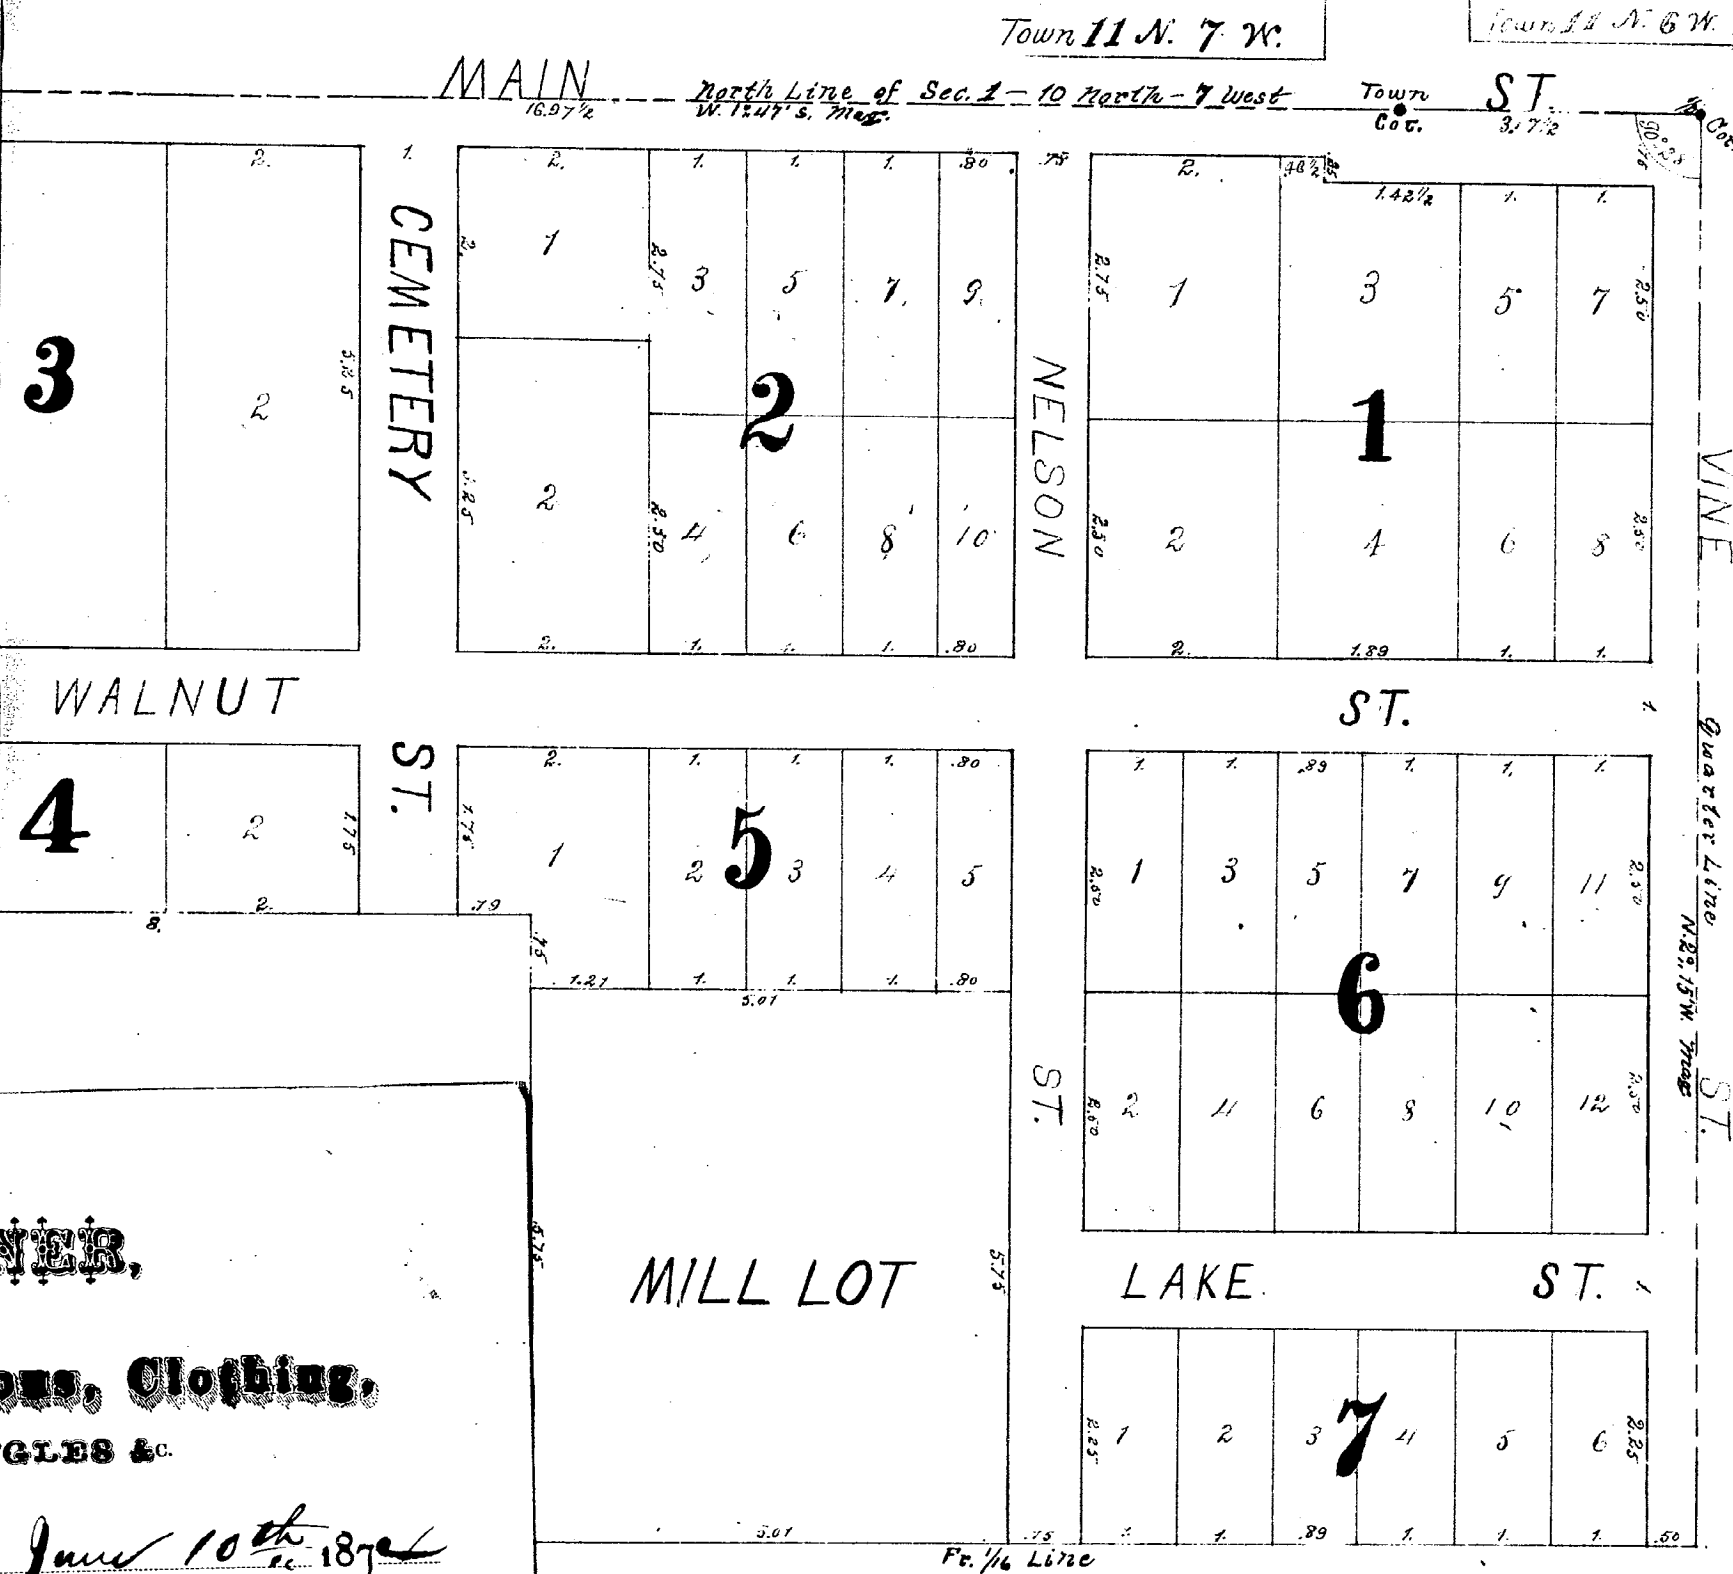

D. M. GARDNER,

GENERAL DEALER IN

Dry-Goods, Groceries, Provisions, Clothing,

BOOTS & SHOES, LUMBER, SHINGLES &c.


STANTON, MICH., June 10th 1874

Auditor General

Lansing Mich.

Dear Sir:

The parallel between town  
10 and 11 north is a correction line and  
there is a jog in the corner of a little over a half  
mile. a diagram will explain it all

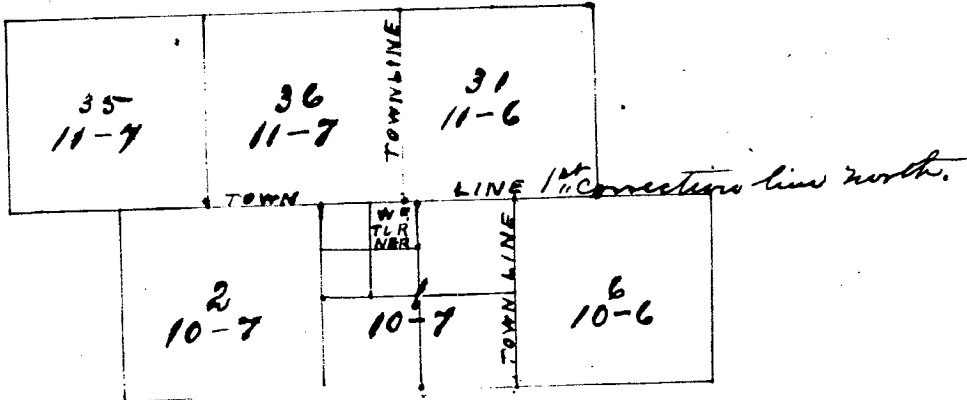

Hoping it will all be satisfactory now  
I am Very truly yours  
D. M. Gardner

to the Village of Stanton, includes the north east  
fractional quarter of section one in Township Ten  
all that certain piece of land bounded as follows, to wit:  
said north east fractional quarter of north west fractional  
Range Seven west and running thence east eight chains,  
west eight chains and thence south twenty six links to  
County of Montcalm and state of Michigan.  
The above plat are hereby dedicated to the use of the  
people of the above plat is two chains or eight rods to the west  
of Turner's addition of said Addition and Addition B. his  
deed this ninth day of May A.D. 1874.

William F. Turner  
Addie E. Turner

May 29, 1874 before me a Notary Public in and for  
Illinois F. Turner and Addie E. his wife to me known to  
that and foregoing instrument and acknowledged the same  
uses and purposes therein mentioned.

Oscar Fenn  
Notary Public

Oscar Fenn Civil Engineer do hereby certify that we have compared  
and that it is a true copy thereof and of the whole of such

Oscar Fenn Register  
Addie E. Turner Civil Engineer

Register Office  
Montcalm County

Received for Record May 9th 1874  
And Recorded in Liber One of Plats on Page 7

Oscar Fenn

Register of Deeds

We Oscar Fenn Register of Deeds and Addie E. Turner  
Civil Engineer do hereby certify that we have compared  
and that it is a true copy thereof and of the whole of such  
instrument and of the whole of such instrument