


PLAT OF GRANDVIEW HEIGHTS KALAMAZOO, MICHIGAN,

- Scale - 1 inch - 50 feet -

- Edw. J. Stevens -

- Engineer -

1911

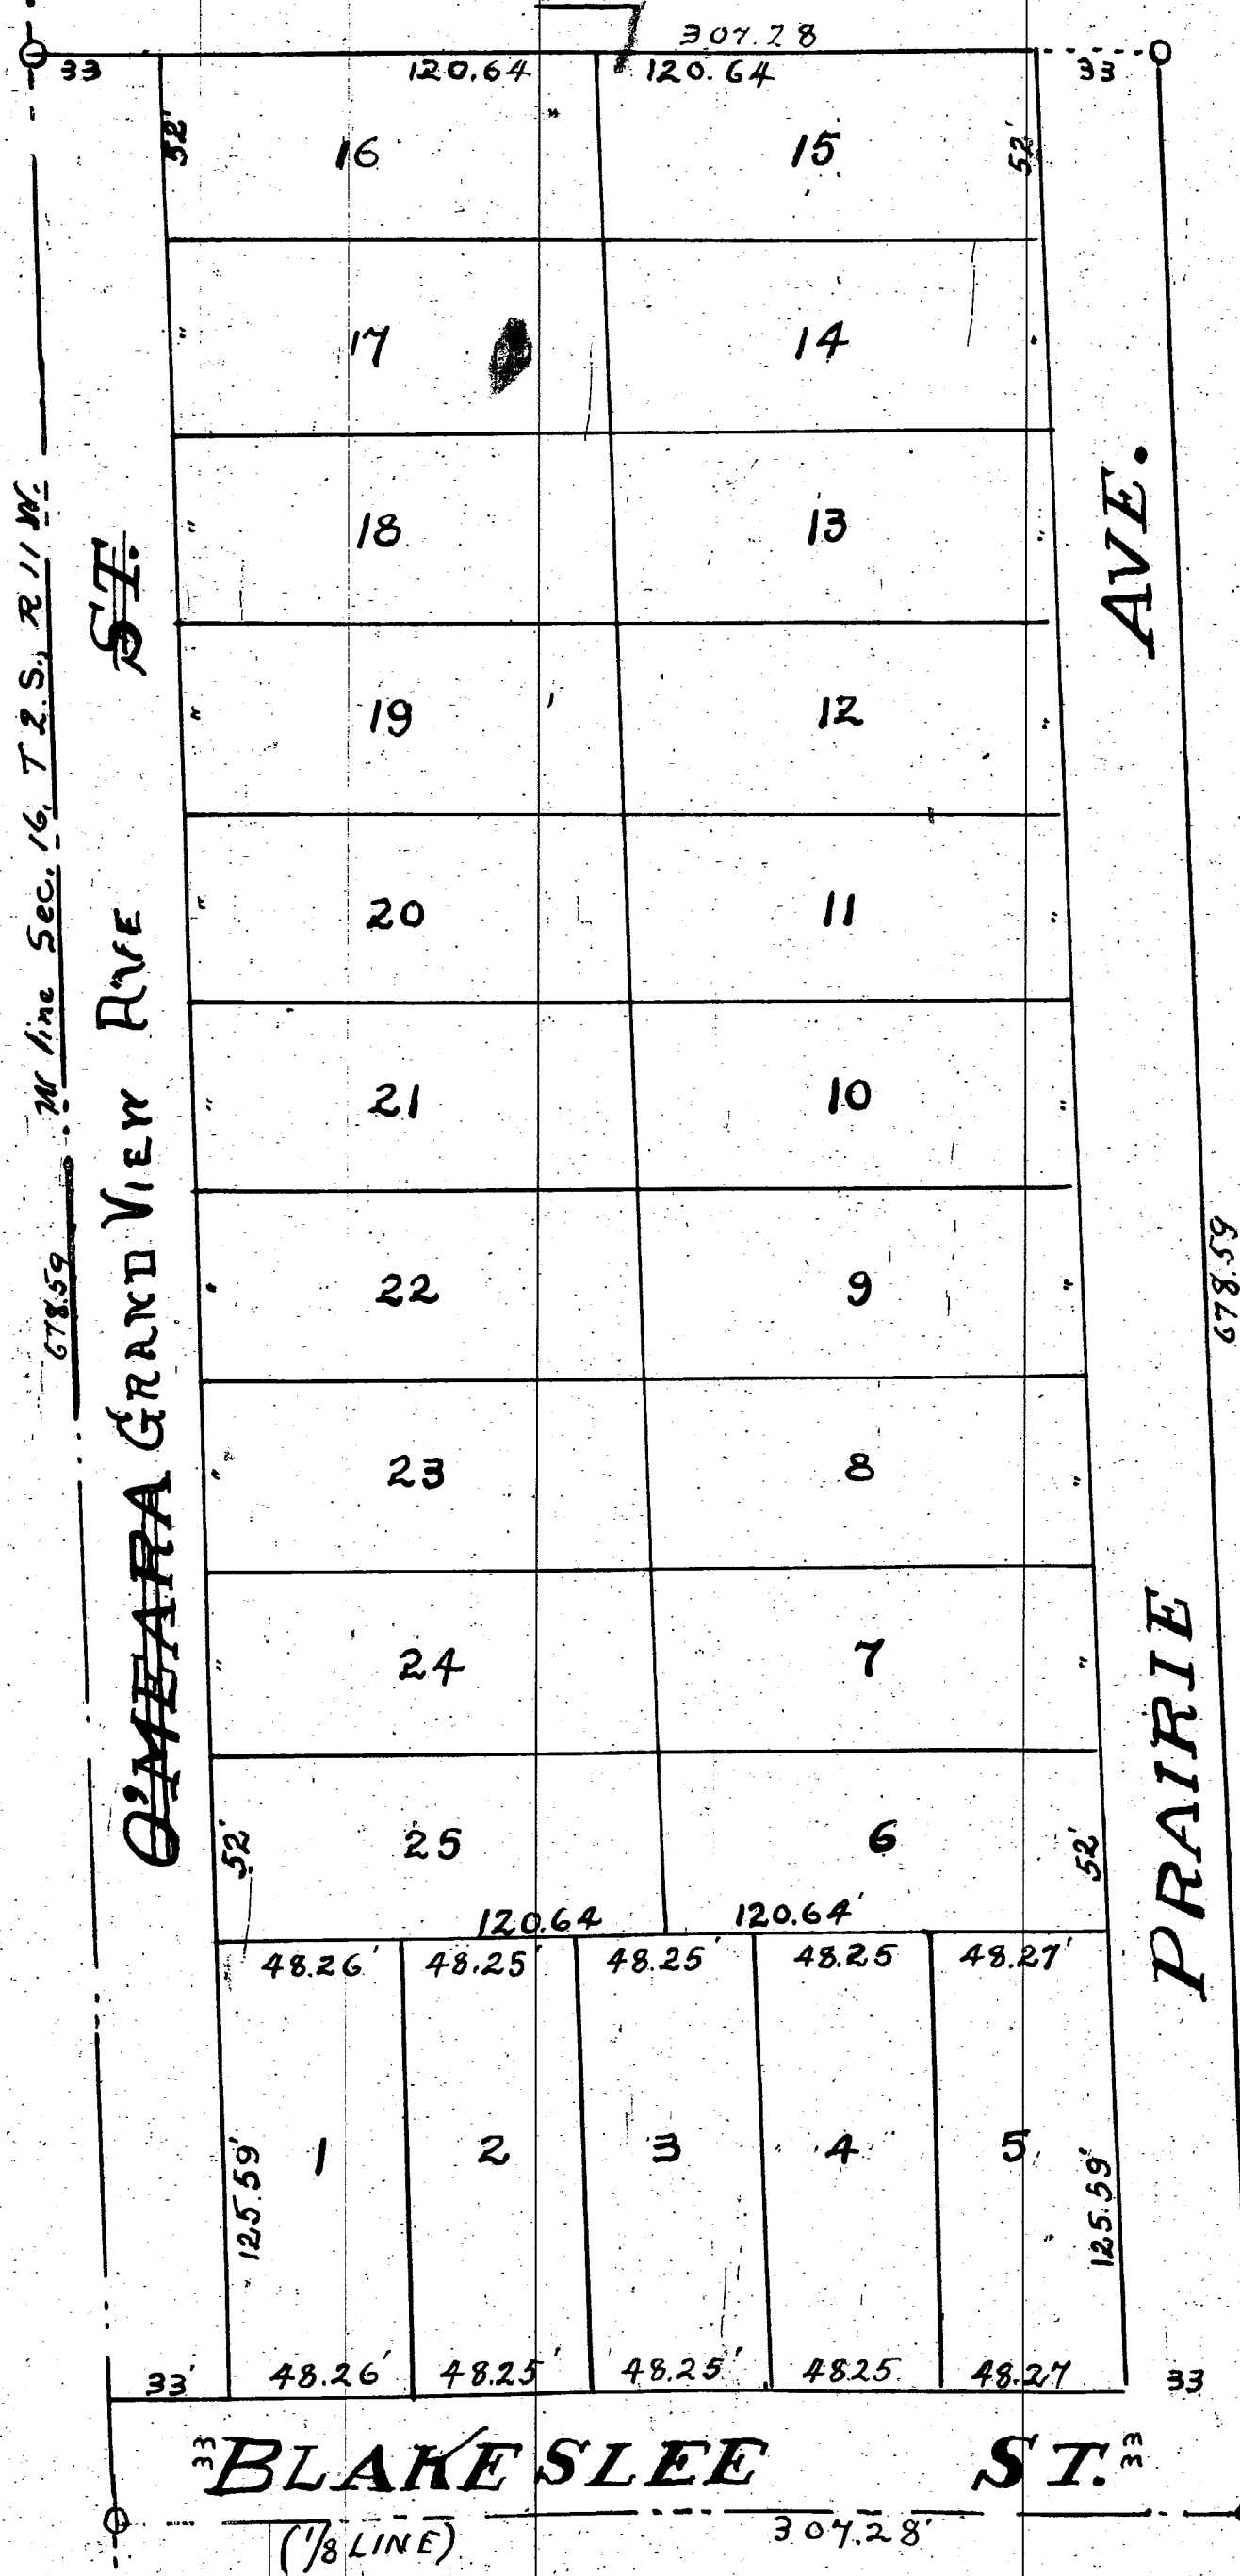

A TRUE COPY OF AN
UNRECORDED PLAT

November 1915,

Noted by

Chas. Cady

Auditor of the

Department

From Taylor Abstract?
Blue Print.