

Plat of the
Northside Addition
 to the City of
KALAMAZOO.

RECEIVED AND FILED.
 In Auditor General's Office
 December 17 1885
 No. 10
 Dep. Aud. Gen'l.

Described as commencing at the point where the centre line of the highway known as the cement road intersects the south line of Section 10 Town 2 South Range 11 West and running thence along the center of the highway to a point one chain and fifty-nine links north of the Indian Reserve line; thence east parallel with said reserve line to the west line of right of way of the Lake Shore and Michigan Southern Railroad; thence southerly along said line of right of way to the section line; thence west along the section line to the place of beginning.

November 28th 1885

F. Hodgman Surveyor.

Executed in presence of *A. L. Cobb*

Frederick Bush Owner. (Seal)

W. B. Standiford

State of Michigan

County of Kalamazoo } 55. On this 28th day of Nov. A.D. 1885 before me a Notary Public in and for said County personally appeared F. Hodgman and Frederick Bush known by me to be the persons who executed this plat who severally acknowledged the same to be their free act and deed. *Chas. L. Cobb Notary Public* } Examined and approved November 28th A.D. 1885 of R. Pratt Dep. Auditor General
 Received For record this 10th day of December A.D. 1885 at 3²⁰ o'clock P. M. and recorded in Lib. 3 of Plats on page 28

Holland Simmons Register of deeds for Kalamazoo County.

State of Michigan

County of Kalamazoo } S. W. Holland Simmons Register of Deeds and F. Hodgman Surveyor hereby certify that we have separately carefully compared this duplicate plat with the original plat of the Northside Addition to the City of Kalamazoo and that it is an exact duplicate thereof and of the whole of such plat.

Holland Simmons Register of Deeds


F. Hodgman Surveyor

State of Michigan

County of Kalamazoo } S. W. Holland Simmons Register of Deeds and F. Hodgman Surveyor hereby certify that we have separately carefully compared this plat with the duplicate plat of the Northside Addition to the City of Kalamazoo now of record in the office of said Register of Deeds and that it is a true transcript therefrom and of the whole of such duplicate plat so recorded. *Holland Simmons* Register of Deeds *F. Hodgman* Surveyor

North

Scale one chain to an inch

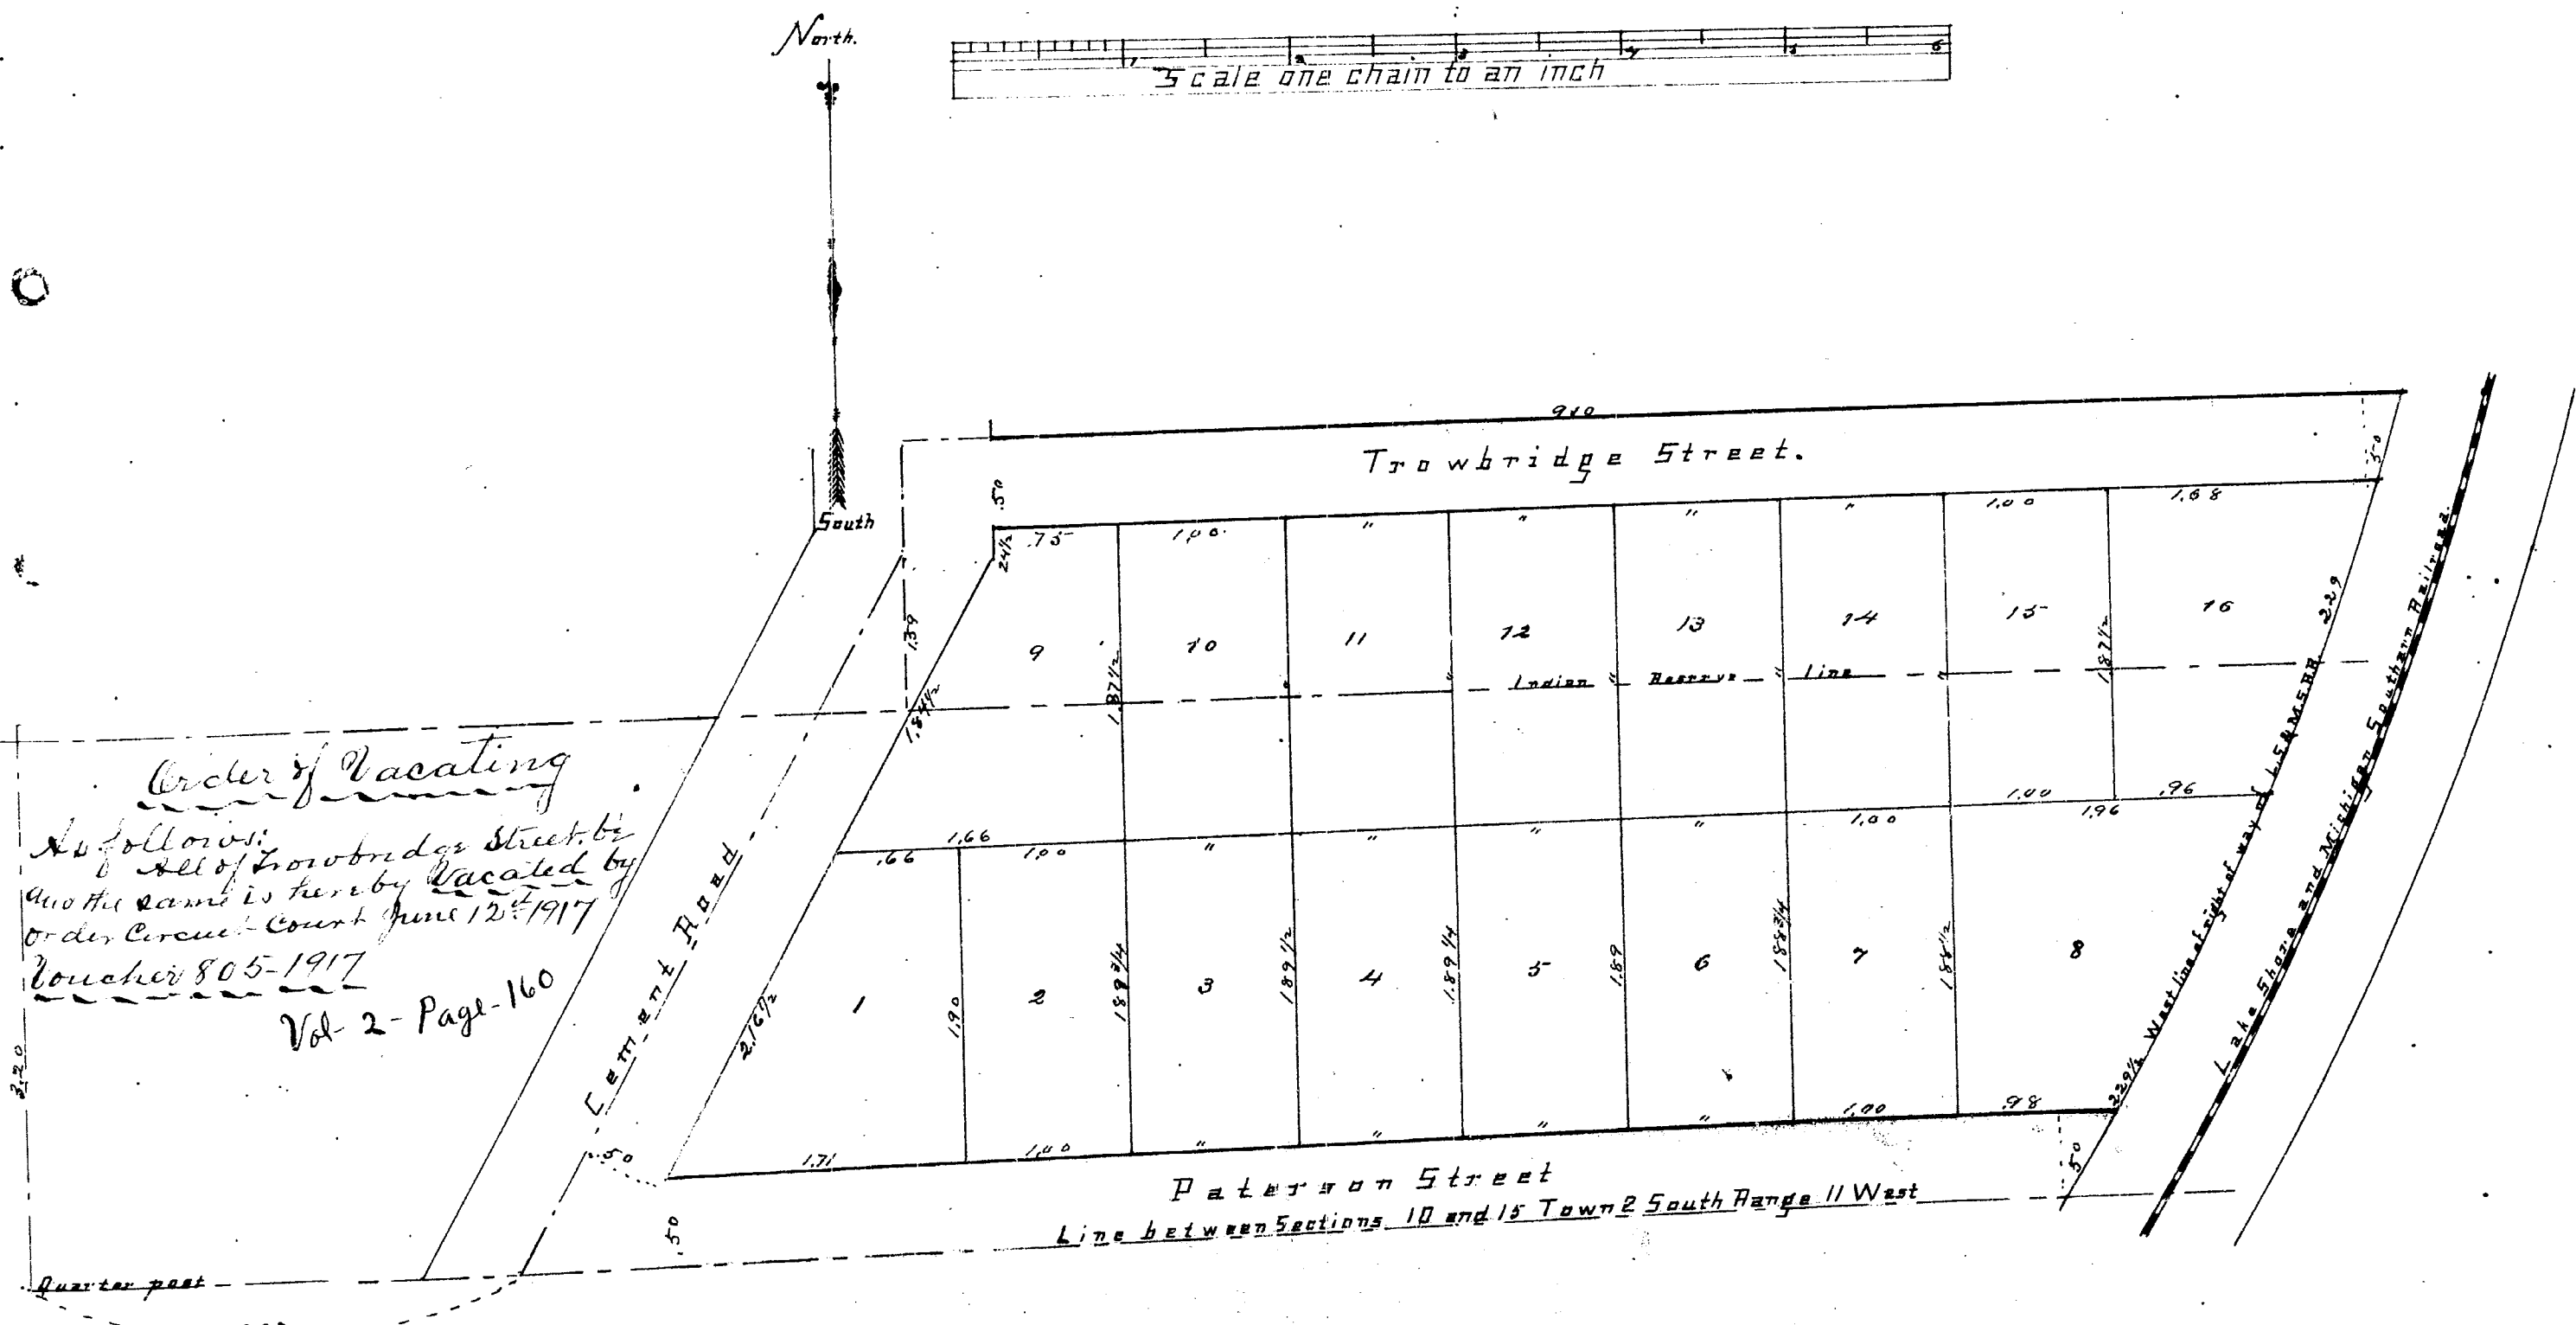

Order of Vacating

As follows:
 All of Trowbridge Street, by
 and the same is hereby vacated by
 Order Circuit Court June 12th 1917
 Voucher 805-1917

Vol 2-Page-160

Paterson Street

Line between Sections 10 and 15 Town 2 South Range 11 West

Plat.

TROWBRIDGE PLACE AND NORTHSIDE ADDITION TO KALAMAZOO

In the matter of the petition
of the William E. Hill Co. and
the Standard Paper Co.

George V. Weimer,
Circuit Judge.
June 12, 1917.

Voucher No. 805 - 1917.

ORDERED that Trowbridge St. and Elnora
St. and that portion of Irene St. lying
easterly of and that portion of Jerome St.
lying southerly of the southerly line of
the right of way of the C. K. & S. R. R.
siding be vacated.

Vol. 156 page 13100 ✓
" 157 " 13113 ✓

VACATION OF PLAT

----- GLENDALE.

In the matter of the
petition of the Kalamazoo
Vegetable Parchment Company
to vacate a portion of the
Revised Plat of Glendale,
Kalamazoo Twp.

March 6, 1918.


Charles B. Collingwood,
Circuit Judge.
Voucher No. 447 -- 1918.

the north line of said Block 1 to the northeast corner of said Block 1 and thence
north 66 ft. to the place of beginning;

That portion of Gallup Ave. and Everett Ave. described as com-
mencing at the northeast corner of Block 6 of said Revised plat of Glendale and
running thence west 205.77 ft. to the easterly line of the Michigan Railway Com-
pany's right of way as shown on said revised plat; thence northwesterly along said
easterly line of said right of way to a point in the south line of said Gallup
Ave., thence east 66 ft. more or less to a point on the west line of Lot 1 of Block 5
of said Revised Plat; thence southeasterly along the westerly line of said Lot 1 of
Block 5 to the southwest corner of said lot 1, thence east on the south line of said
Lot 1 56.6 ft. to the southeast corner of said Lot 1; thence south along the
west line of the right of way of said C.K. & S. Ry. Company 66 ft. to the place of
beginning.

Be and the same are hereby vacated as public grounds.

Vol. 159 Page 13256 ✓

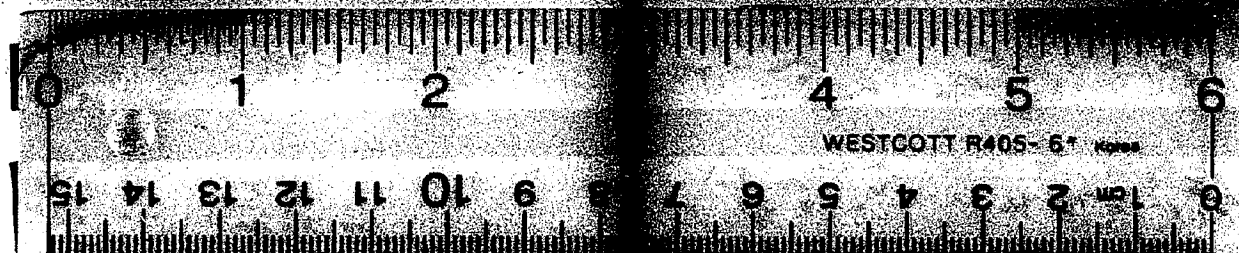

16 X