

SCHULTE FELDMANN'S SUBDIVISION

OF A PART OF OL. 10 REAR CONCESSION OF P.C. 19 BEAUFORT FARM


CITY OF DETROIT

WAYNE CO.

MICHIGAN

MASON L. BROWN
Civil Engineer
88-10000 Woodward
Detroit, Mich.

Scale 50 Feet = 1 1/2" = 1500'

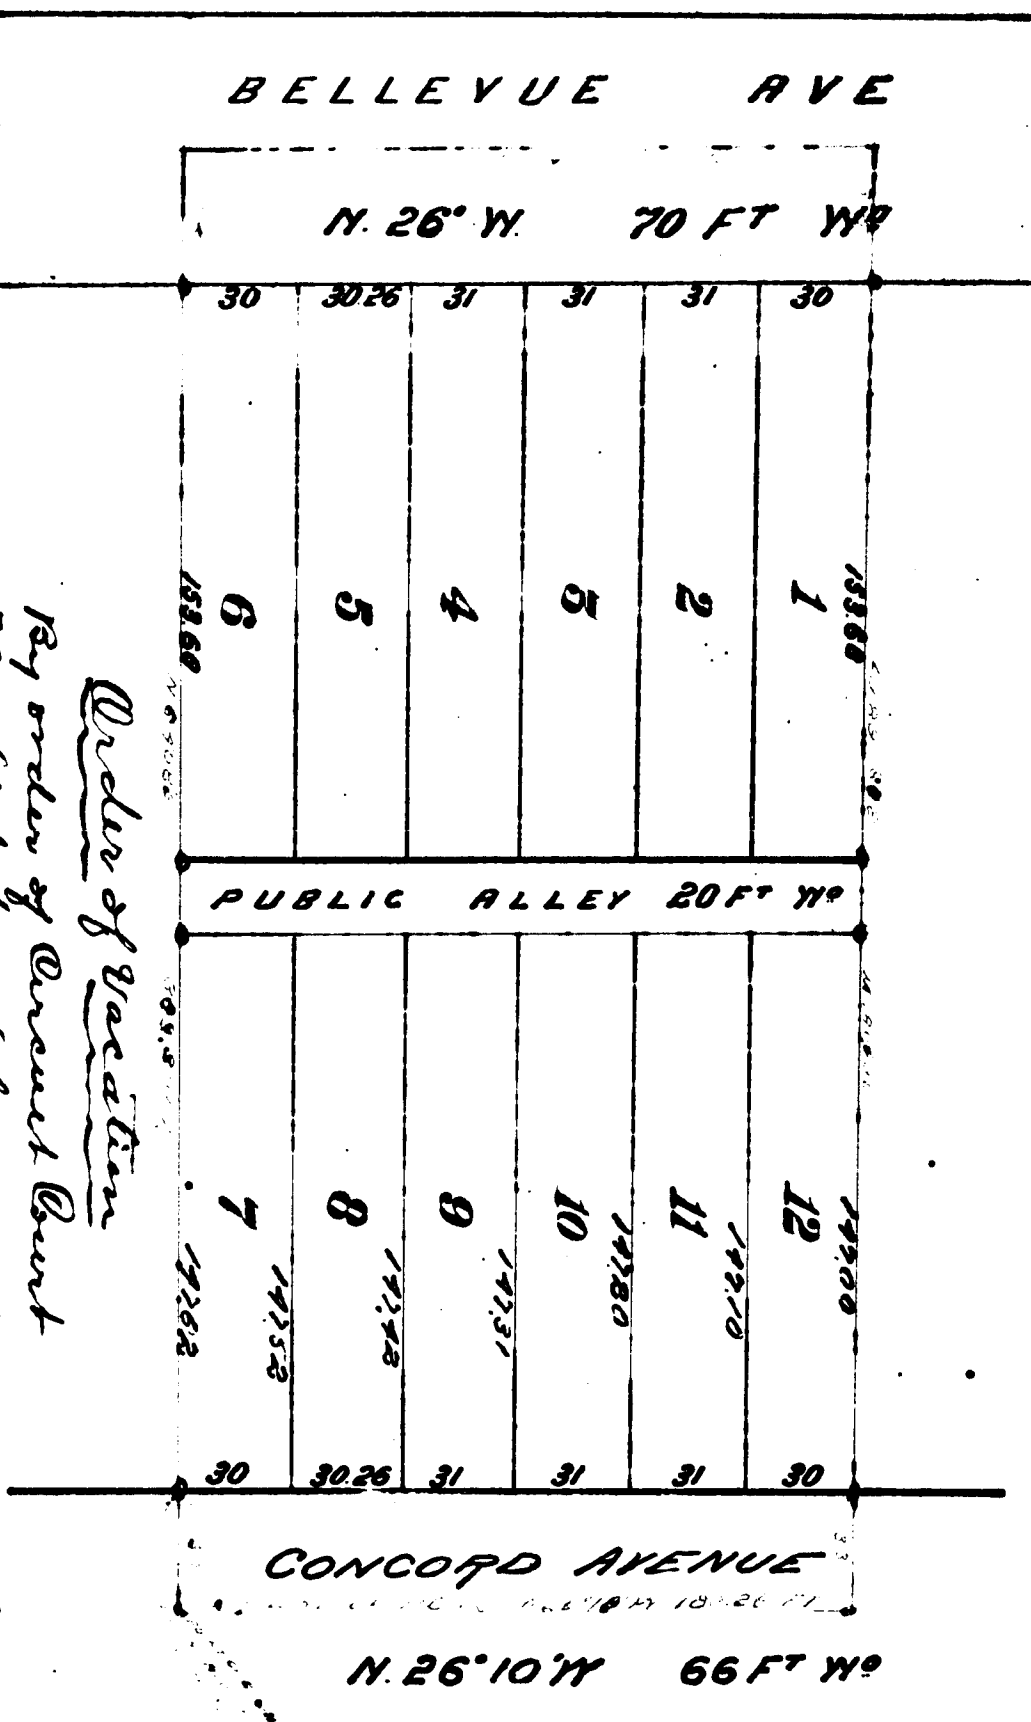

Order of Vacation
By order of Circuit Court
This plat, by and the same is
hereby vacated January 6th, 1918
Docket - 45-1921

I hereby certify that the above Plat is correct, and that the same
consisting of Oak Stakes 1 1/2 inches square and 15 inches long have
been placed in the ground at all angles in the boundaries, and at the
intersection of all Streets or Streets and Alleys, as shown on plat by O.

Detroit, June 16, 1896.
Mason L. Brown
Engineer and Surveyor.

RECEIVED AND FILED
IN AUDITOR GENERAL'S OFFICE.

July 16, 1918
Auditor General

STATE OF MICHIGAN,
County of Wayne.

Masson L. Brown, Surveyor, hereby
certify that we have each carefully compared this copy with the original
plat of the above described premises, and that it is a true and correct copy of the
whole of each original map or plat.
Mason L. Brown, Surveyor.

STATE OF MICHIGAN,
County of Wayne.

Masson L. Brown, Surveyor, hereby
certify that we have each carefully compared the annexed copy with the
plat of the above described premises, and that it is a true and correct copy of the
whole of each original map or plat.
Mason L. Brown, Surveyor.

Gravard McPherson

July 5, 1896
Notary Auditor General

NOTARY PUBLIC AT THESE PRESENTS, that the said
Mason L. Brown, Surveyor, and the said
Gravard McPherson, Notary Public,
have caused the above plat to be surveyed, laid
out and plotted, to be known as the
Schulte Feldmann's Subdivision, and the
Alleys shown on said plat are hereby dedicated to the use of the public.
Witness our hands and seals this 16th day of
June, 1896.
A. D. Eighteen Hundred and Ninety Six.
In presence of:
Gravard McPherson, Notary Public
Mason L. Brown, Surveyor
Mason L. Brown, Surveyor

STATE OF MICHIGAN,
County of Wayne.
On this, the 16th day of June, 1896, before
me, a Notary Public, and for said county, personally appeared the
above named Mason L. Brown, Surveyor, and the said
Gravard McPherson, Notary Public, and they acknowledged to me to be the same persons who executed the above dedication,
and who acknowledged the same to be their free act and deed.
Gravard McPherson, Notary Public
Mason L. Brown, Surveyor

APPROVED, July 24, 1896
Notary Public
Wayne Co., Michigan

THE ANNOTATED HANDBOOK OF THE
Beginning of a state on the east line
of P.C. 19 distance N 86° 10' W 103.85 ft. from the SE corner
of O.A. 10 distance south along N 86° 10' W 103.85 ft. to a
state, thence S 89° 10' W 500.00 ft. to a state thence
S 86° 15' 18.85 ft. to a state, thence N 86° 06' 38.95
ft. to pt. of beg.

22

CITY OF DETROIT

MASON L. BROWN
Civil Engineer & Surveyor
28--24 Hodges Bldg
Detroit

BELLEVUE AVE

N. 26° W. 70 FT WP

PUBLIC ALLEY 20 FT W⁹

CONCORD AVENUE

N. 26° 10' W 66 FT W^o

By order of Circuit Court

These plates, or window sashes, is
herby wooded January 6th 1918
Ottawa - 45 - 1921

Detroit, June 16 1896.
Maxwell D. Oliver
 Engineer and Surveyor.

[illegible]

STATE OF MICHIGAN } ss.
County of WARRREN }

W. D. Gullett Register
Mason's Trustee Sumner.

A. E. O'NEILL, JR., P.O. 29,
 2001 10th St.,
 New York, N.Y. 10011
 Dear Mr. O'Neill:
 Your letter of 1/25/72 received for answer by
 mail of 2/1/72. I am glad to hear that you
 are now working in the field in Liberia.
 I am on leave until the proper certificate is
 issued to me. I am working with Paul L. and
 Mrs. A. E. O'Neill, Jr., New York.
 Sincerely,
 C. P. Kennedy

George Schmidt (L.S.)
Wendell Schulte (L.S.)
Frederick Tibbaw (L.S.)
Charles F. Williams (L.S.)

On this, the 25th day of April 1886, before

County, Kansas

Beginning at a state on the

16. to pt. of Reg