

RITTER & BURCH'S SUBN
 OF THE N 198 FT OF THE S 528 FT OF THE N 738.00 FT OF LOT 1
 OF COMMISSIONERS' PLAT OF JAMES MESSMORE ESTATE
 BEING PART OF FRAC. SEC. 1, T. 2 S. R. 11 E. 9

FRAC. SEC. 36 T. 1 S. R. 11 E.
 Except that portion lying north of the south line of Highway Avenue
 Detroit

Wayne Co., Mich.

18TH ST. N 33° 30' W

1	2	3	4	5	6	7	8	9	10	11	12	13	14	15	16	17	18	19	20	21	22	23	24	25	26	27	28	29	30	31	32
1	2	3	4	5	6	7	8	9	10	11	12	13	14	15	16	17	18	19	20	21	22	23	24	25	26	27	28	29	30	31	32

16TH ST.



SCALE, ONE INCH = 200 FT.

VACATED BY RESOLUTION
 OF
 JUNE 1, 1904
 VOUCHER NO. 34-22

I hereby certify that the above
 description is correct, and that the monument
 monuments consisting of oak sticks
 have been placed at points marked
 thereon as shown above, at all
 angles in the boundaries of the
 land platted, and at all intersections
 of streets or alleys.

Frank D. Robinson

Dawson

There are now by these parties that should be. Ritter and May's Riddle (this map) Edwin A. Burch and May's Riddle (this map) Wayne County, Michigan. Any device to the public the purpose of the above and also as represented in the annexed plat of Ritter and Burch's Subn of the N 198 ft. of the S 528 ft. of the N 738.00 ft. of Lot 1 of Commissioners' Plat of James Messmore Estate, being part of Frac. Sec. 1, T. 2 S. R. 11 E. 9, Detroit, Wayne Co., Mich.

Witness our hands and seal this 30 day of June A. D. 1904.

W. J. Burch
 Mayor of Detroit

State of Michigan } ss.
 County of Wayne }

On this 30 day of June 1904 before me, the undersigned a Notary Public, in and for said County, personally appeared the above named Frank D. Ritter and May's Riddle (this map) and Edwin A. Burch (this map) to me known to be the persons described, who executed the above instrument and acknowledged the same to be their free act and deed.

Anthony B. Borch
 Notary Public

Wayne Co.,

Description of Land Platted - Beginning at a point on the center line of Big Island St. distant 327.80 ft. on a bearing of N 33° 30' W. from the corner of Lot 1 of James Messmore Est. thence N 33° 30' W. 162.30 ft. to a point on the center line of Big Island St. thence S 33° 30' W. 177.00 ft. to a point of beginning.

State of Michigan } ss.
 County of Wayne }

We C. C. Lantry, Register of Deeds and Clerk of Probate, County of Wayne, Michigan, do hereby certify that the copy with the original plat of Ritter and Burch's Subn of the N 198 ft. of the S 528 ft. of the N 738.00 ft. of Lot 1 of Commissioners' Plat of James Messmore Estate, being part of Frac. Sec. 1, T. 2 S. R. 11 E. 9, and also the copy of the original plat of the whole tract, are true and correct copies of the original plat.

C. C. Lantry, Register of Deeds
 and Clerk of Probate, County of Wayne

State of Michigan } ss.
 County of Wayne }

We C. C. Lantry, Register of Deeds and Clerk of Probate, County of Wayne, Michigan, do hereby certify that we have read carefully and found the annexed copy with the plat of Ritter and Burch's Subn of the N 198 ft. of the S 528 ft. of the N 738.00 ft. of Lot 1 of Commissioners' Plat of James Messmore Estate, being part of Frac. Sec. 1, T. 2 S. R. 11 E. 9, and also the copy of the original plat of the whole tract, are true and correct copies of the original plat, and that it is a true transcript thereof and of the whole tract, as the office of said Register of Deeds and Clerk of Probate.

Examined and approved
 July 2, 1904
 John J. Robinson
 Deputy Auditor General

RECEIVED AND FILED
 IN AUDITOR GENERAL'S OFFICE
 July 2, 1904
 John J. Robinson
 Deputy Auditor General

Frank D. Robinson
 Register of Deeds
 and Clerk of Probate, County of Wayne

The Streets on the annexed plat conform
 to the general plan of the City.

W. J. Burch
 City Engineer

Approved: W. J. Burch
 City Engineer


Commissioner of Public Works

REGISTER OF DEEDS OFFICE } ss.
 WAYNE COUNTY, }
 This instrument was received for record this
 day of July, 1904, at 11:30 A.M.
 and recorded in Liber 10, page 107.
 Witness my hand and seal of said County, this
 day of July, 1904.
 C. C. Lantry, Register of Deeds
 and Clerk of Probate, County of Wayne

RITTER & BURCH'S SUBN
of the N. 108 ft of the S. 528 ft. of the N. 738.00 ft. of LOT 1
of Commissioners' Plat of James Messmore Estate
BEING PART OF FRAC. SEC. 1, T. 2 S. R. 11 E. &
FRAC. SEC. 36 T. 1 S. R. 11 E.
Except that portion lying North of the South line of F. W. Watts Avenue

Detroit
Wayne Co. Mich.

1

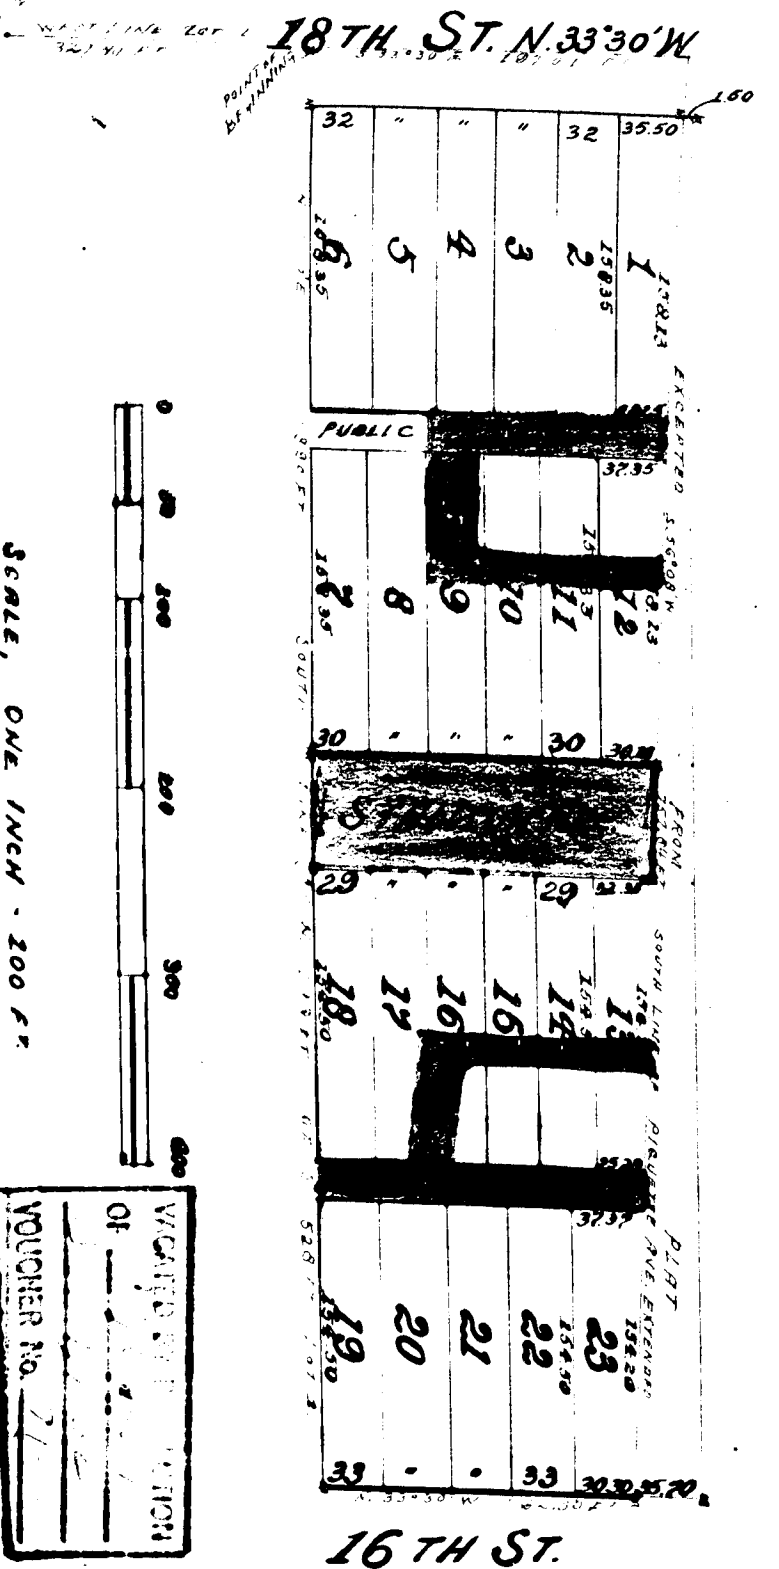

I hereby certify that the first herein delineated is correct, and that the same monument, consisting of oak sticks, have been planted at points marked thereon, in a known stream, at all angles on the foundation of the said pillar, and at all intersections of streets or streets and alleys.

Know all men by these presents that Deborah R. Rittle and Mary A. Rouse (his wife) Edwin A. Rouse and Mary A. Rouse (his wife of Detroit, Wayne County, Michigan, hereby dedicate to the public the permanent use of the streets and alley or referenced on the annexed plat of Rittle and Rouse's Sub of the N. 198 ft. of the S 528 ft. of the N 758.90 ft. of Lot 1 of Commencement Plat of James W. Rouse, dated Aug. 1st of 1900. Sec. 1 S. 2 S. R. 11 E. and Tce. Sec. 36, T. 1 S. R. 11 E. V. Detroit, Wayne Co., Mich.

State of Michigan }
County of Wayne } ss.

bounty of \$4000 } ss.
 On the 3^d day of June 1904 before me, the undersigned, a Notary Public,
 we and for said bounty, personally appeared the above named above J. R. Riden and Mary Ritten (his wife)
 known to me and Mary R. Ritten (his wife) to me known to be the persons described, who executed
 before me and Mary R. Ritten (his wife) the same to be their free act and deed.

Anthony Borda
Mary Borda
Wayne Borda

My communication expires March 17th Michigan
 Description of Land. 11th Sec. - Beginning at a point on the center line of Big Lake Rd. distant 327.80 ft. on a course
 N. 30° 30' W. to corner of Sec. 1 Twp. 36 N. 33° 30' E. 108.10 ft. thence N. 33° 30' W. 163.30 ft. to north line
 of Sec. 36 Twp. 36 N. thence E. 60° 08' W. 177.90 ft. to corner of Big Lake Rd. thence S. 33° 30' E. 177.90 ft. to place of beginning.

State of Michigan } S.S.
County of Saginaw }

[illegible]

Wm. L. G. *Regent of Essex*
 Ward of Boston *August*

State of Michigan } ss.
County of Wayne }

bound of May 1888.
 The C. & C. Co. has
 Register of Deeds and "Bank of Wisconsin, Drovers' Club"
 and in that we have not correctly compared the annexed copy with the plat of Rille and Hunt's "Book of
 the W. 1888 of 14. 2 58 ft of the W. 758.90 ft of 141 ft of "Immense" part of "Imperial" and "Imperial" and "Imperial"
 part of "Imperial" of 2 5. 11 ft. and "Imperial" of 36 5 1 5. R. 11 ft. and "Imperial" and "Imperial" and "Imperial"
 in the office of said Register of Deeds and that it is a true transcript therefrom and of the method of
 record.
 RECEIVED AND FILED.
 IN AUDITOR GENERAL'S OFFICE,
 1888.
 Register of Deeds.
 Auditor General.

RECEIVED AND INDEXED
IN AUDITOR GENERAL'S OFFICE,
September 12, 1904.
Wm. Bird & Co.,
Auditors General.

Respectfully,
Frank D. Robinson, Director

August 2, 1904
 John F. Smith
 Sydney Austin Brown.

The Streets on the annexed plat conform
to the general plan of the City.

Y. H. McCombs

CITY ENGINEER

Approved: *Wm. H. McLaughlin*
July 21, 1900
 Commissioner of Public Works.

Commissioner of Public Works

14th inst. was received for perjury 1880
day of March 1864 at 3
to John M. and resided in Liberty
to 1865 on page 367 as per certificate was
and in compliance with Sect. 1849 of Statute
BIO. NO. 180 FILED 22d day of 1880.
C. P. Randall
Clerk of the Court