

Vested by Circuit Court
Lot 46 & 47 2-20-31
" 49 to 112 inclusive
Second St. Entire
Third " "
Oak " "
Lake " between 2nd & 3rd
West " Entire
South " West of W. line of 1st St.
Voucher # 2213-12-28-31

5696
PLAT
OF
SECOND ADDITION TO PLAT
OF
IDLEWILD


M. C. TAFT, Surveyor.

SCALE - 100 FEET PER INCH.

1905

RECEIVED AND FILED
IN AUDITOR GENERAL'S OFFICE,

August 9-1905
John F. Wilkinson
Deputy Auditor General.

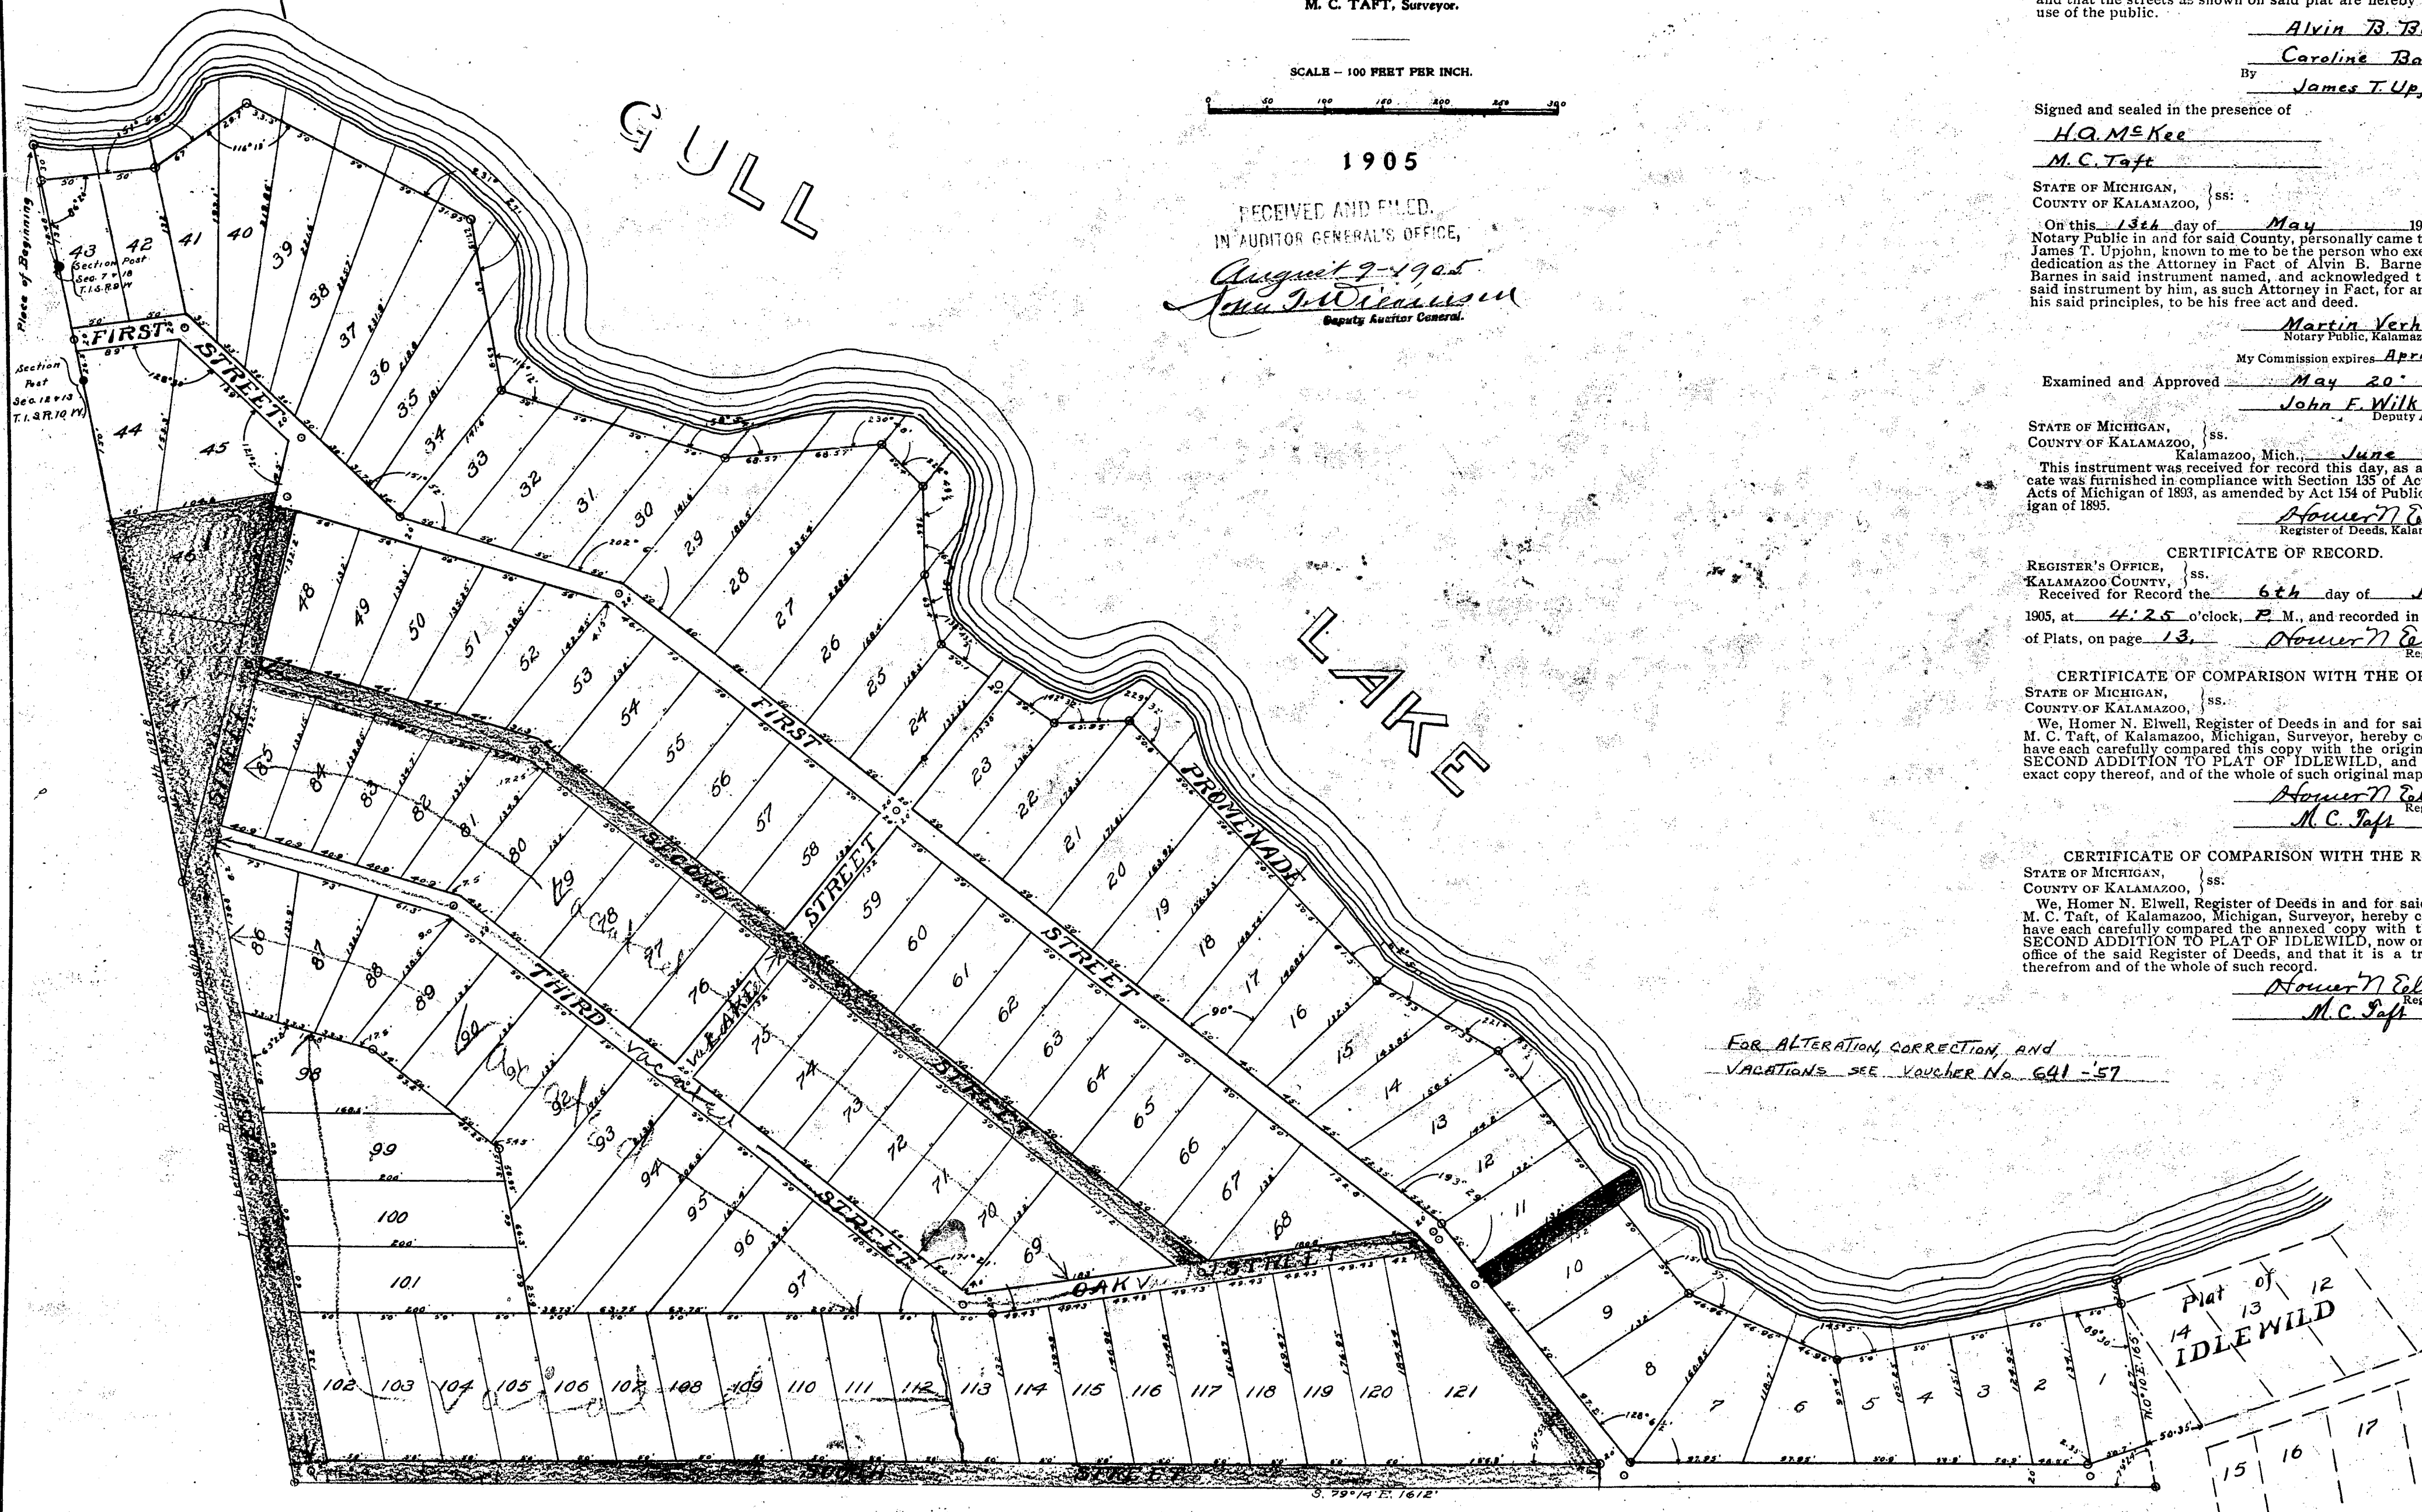

DESCRIPTION OF LAND PLATTED.

All that piece or parcel of land situate and lying in the southwest fractional quarter of section 7 and the northwest fractional quarter of section 18, T. 1 S., R. 9 W. and more particularly described by the following bounding lines:
Beginning at the point where the west line of the said section 7 intersects the southwesterly shore of Gull Lake and running thence south along the west line of sections 7 and 18, 1197.8 feet to a point 1039.32 feet south of the northwest corner of the said section 18, thence south 79 degrees 14 minutes east 1612 feet, thence north 10 minutes east 185 feet to the northwest corner of lot 14, Plat of IDLEWILD, thence north 10 minutes east 21.6 feet to the shore of Gull Lake, thence northwesterly along the shore of Gull Lake to the place of beginning.

SURVEYOR'S CERTIFICATE.

I hereby certify that the plat hereon delineated is a correct one and that permanent monuments consisting of 5/8 inch round iron rods have been planted at all points marked thus (O) as hereon shown, at all angles in the boundaries and at all intersections of streets.

M. C. Taft

Surveyor.

DEDICATION.

KNOW ALL MEN BY THESE PRESENTS, That we, Alvin B. Barnes as proprietor and Caroline Barnes, his wife, have caused the land embraced in the annexed plat to be surveyed, laid out and platted, to be known as PLAT OF SECOND ADDITION TO PLAT OF IDLEWILD, and that the streets as shown on said plat are hereby dedicated to the use of the public.

Alvin B. Barnes [L.S.]

Caroline Barnes [L.S.]

By James T. Upjohn [L.S.]
Attorney in Fact.

Signed and sealed in the presence of

H. A. McKee

M. C. Taft

STATE OF MICHIGAN,
COUNTY OF KALAMAZOO, ss:

On this 13th day of May, 1905, before me a Notary Public in and for said County, personally came the above named James T. Upjohn, known to me to be the person who executed the above dedication as the Attorney in Fact of Alvin B. Barnes and Caroline Barnes in said instrument named, and acknowledged the execution of said instrument by him, as such Attorney in Fact, for and on behalf of his said principals, to be his free act and deed.

Martin Verhage

Notary Public, Kalamazoo County, Mich.

My Commission expires April 21, 1907

Examined and Approved May 20, 1905.

John F. Wilkinson

Deputy Auditor General.

STATE OF MICHIGAN,
COUNTY OF KALAMAZOO, ss:

Kalamazoo, Mich. June 6th, 1905.
This instrument was received for record this day, as a proper certificate was furnished in compliance with Section 135 of Act 206 of Public Acts of Michigan of 1893, as amended by Act 154 of Public Acts of Michigan of 1895.

Homer N. Elwell

Register of Deeds, Kalamazoo Co., Mich.

CERTIFICATE OF RECORD.

REGISTER'S OFFICE,
KALAMAZOO COUNTY, ss:

Received for Record the 6th day of June, 1905, at 4:25 o'clock, P. M., and recorded in Liber 7 of Plats, on page 13.

Homer N. Elwell

Register of Deeds.

CERTIFICATE OF COMPARISON WITH THE ORIGINAL.
STATE OF MICHIGAN,
COUNTY OF KALAMAZOO, ss:

We, Homer N. Elwell, Register of Deeds in and for said County, and M. C. Taft, of Kalamazoo, Michigan, Surveyor, hereby certify that we have each carefully compared this copy with the original PLAT OF SECOND ADDITION TO PLAT OF IDLEWILD, and that it is an exact copy thereof, and of the whole of such original map or plat.

Homer N. Elwell

Register of Deeds.

M. C. Taft

Surveyor.

CERTIFICATE OF COMPARISON WITH THE RECORD.

STATE OF MICHIGAN,
COUNTY OF KALAMAZOO, ss:

We, Homer N. Elwell, Register of Deeds in and for said County, and M. C. Taft, of Kalamazoo, Michigan, Surveyor, hereby certify that we have each carefully compared the annexed copy with the PLAT OF SECOND ADDITION TO PLAT OF IDLEWILD, now on record in the office of the said Register of Deeds, and that it is a true transcript therefrom and of the whole of such record.

Homer N. Elwell

Register of Deeds.

M. C. Taft

Surveyor.

FOR ALTERATION, CORRECTION, AND
VARIATIONS SEE VOUCHER No. 641-57

Verified by Circuit Court
Lot 46 147 2-28-31
89 6 112

Second St. to line
Third " "
Oak " "
Lane " between 2nd & 3rd
West " Entire
South " W. of of lot line or 1st St.

Voucher # 2213-12-28-31

5676
PLAT
OF
SECOND ADDITION TO PLAT


IDLEWILD

M. C. TAFT, Surveyor.

SCALE -- 100 FEET PER INCH.

1905

August 9-1905
John J. Wilkinson
Deputy Auditor General.

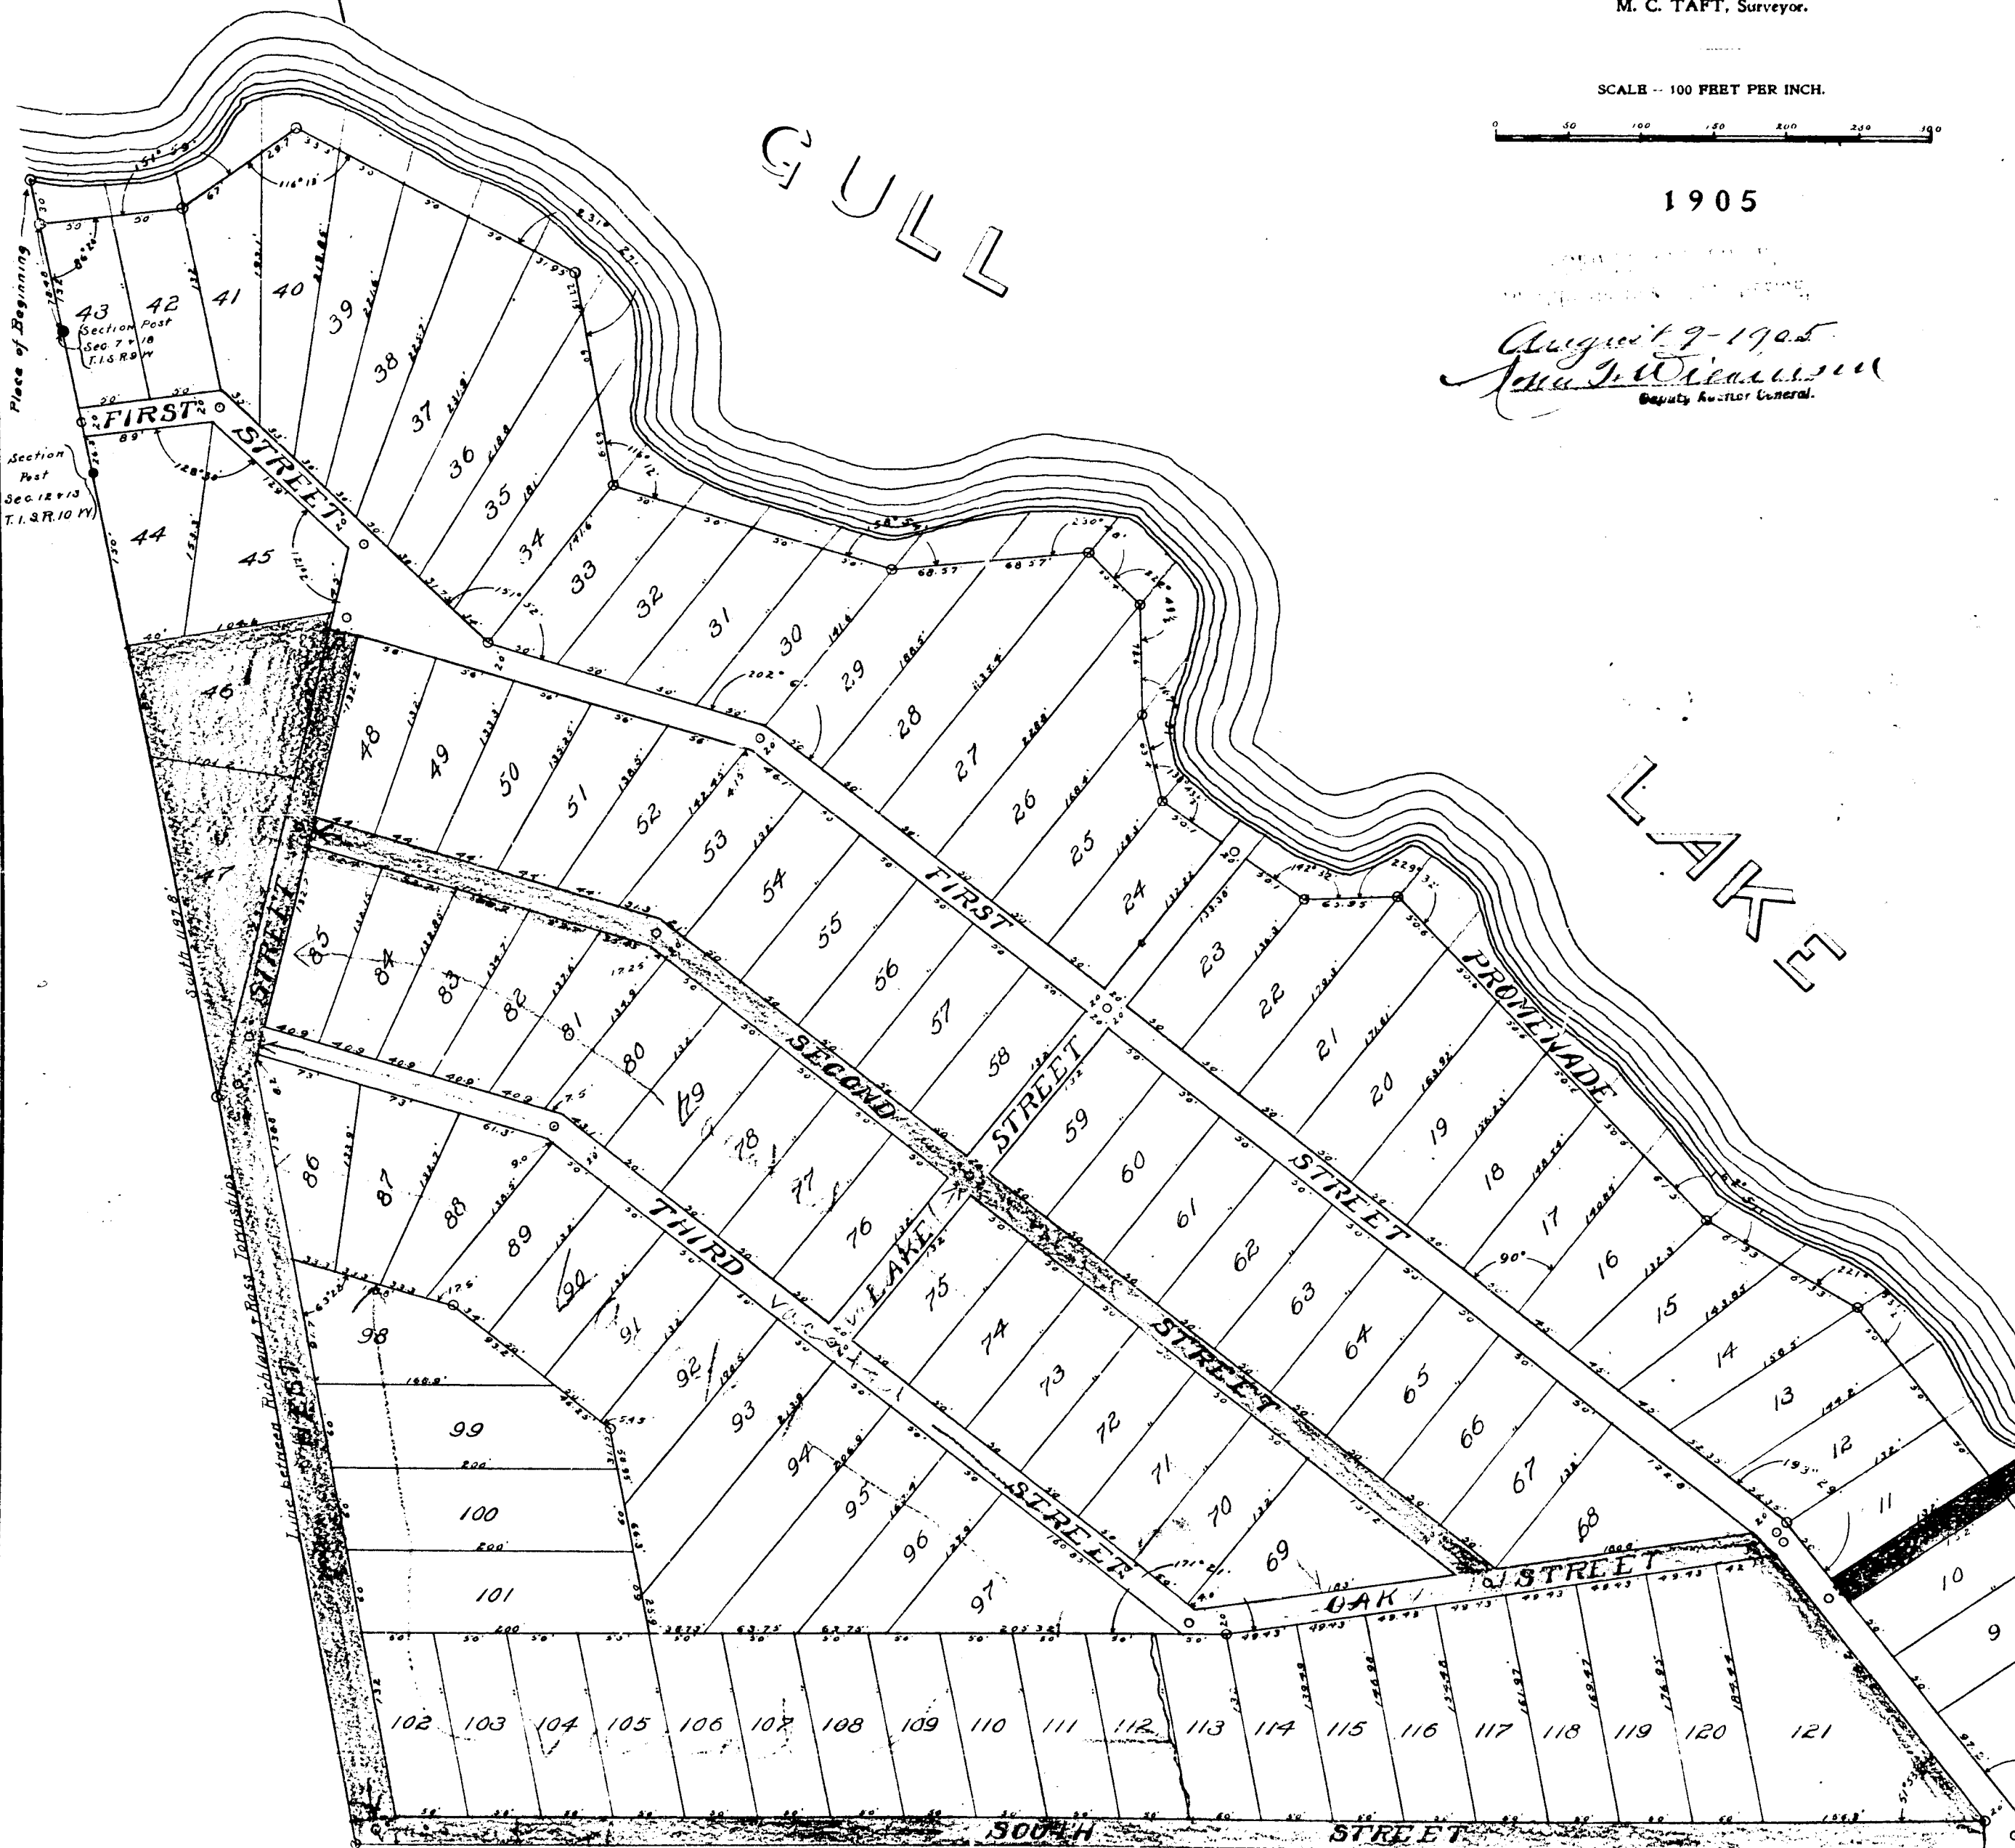

DESCRIPTION OF LAND PLATTED.

All that piece or parcel of land situate and lying in the southwest fractional quarter of section 7 and the northwest fractional quarter of section 18, T. 1 S., R. 9 W. and more particularly described by the following bounding lines:

Beginning at the point where the west line of the said section 7 intersects the southwesterly shore of Gull Lake and running thence south along the west line of sections 7 and 18, 1197.8 feet to a point 1081.32 feet south of the northwest corner of the said section 18, thence south 79 degrees 14 minutes east 1012 feet, thence north 10 minutes east 185 feet to the northwest corner of lot 14, Plat of IDLEWILD, thence north 10 minutes east 21.6 feet to the shore of Gull Lake, thence northwesterly along the shore of Gull Lake to the place of beginning.

SURVEYOR'S CERTIFICATE.

I hereby certify that the plat hereon delineated is a correct one and that permanent monuments consisting of 5/8 inch round iron rods have been planted at all points marked thus (O) as hereon shown, at all angles in the boundaries and at all intersections of streets.

M. C. Taft

Surveyor.

DEDICATION.

KNOW ALL MEN BY THESE PRESENTS, That we, Alvin B. Barnes as proprietor and Caroline Barnes, his wife, have caused the land embraced in the annexed plat to be surveyed, laid out and platted, to be known as PLAT OF SECOND ADDITION TO PLAT OF IDLEWILD, and that the streets as shown on said plat are hereby dedicated to the use of the public.

Alvin B. Barnes [L.S.]

Caroline Barnes [L.S.]

By James T. Upjohn [L.S.]
Attorney in Fact.

Signed and sealed in the presence of

H. G. McKee

M. C. Taft

STATE OF MICHIGAN,
COUNTY OF KALAMAZOO, ss.

On this 13th day of May, 1905, before me a Notary Public in and for said County, personally came the abovesigned James T. Upjohn, known to me to be the person who executed the above dedication as the Attorney in Fact of Alvin B. Barnes and Caroline Barnes in said instrument named, and acknowledged the execution of said instrument by him, as such Attorney in Fact, for and on behalf of his said principles, to be his free act and deed.

Martin Verhage

Notary Public, Kalamazoo County, Mich.

My Commission expires April 21, 1907

Examined and Approved May 20, 1905.

John F. Wilkinson

Deputy Auditor General.

STATE OF MICHIGAN,
COUNTY OF KALAMAZOO, ss.

Kalamazoo, Mich., June 6th, 1905.
This instrument was received for record this day, as a proper certificate was furnished in compliance with Section 135 of Act 206 of Public Acts of Michigan of 1893, as amended by Act 154 of Public Acts of Michigan of 1895.

Homer N. Elwell

Register of Deeds, Kalamazoo Co., Mich.

CERTIFICATE OF RECORD.

REGISTER'S OFFICE,
KALAMAZOO COUNTY, ss.

Received for Record the 6th day of June, 1905, at 4:25 o'clock, P. M., and recorded in Liber 7 of Plats, on page 13.

Homer N. Elwell

Register of Deeds.

CERTIFICATE OF COMPARISON WITH THE ORIGINAL.

STATE OF MICHIGAN,
COUNTY OF KALAMAZOO, ss.

We, Homer N. Elwell, Register of Deeds in and for said County, and M. C. Taft, of Kalamazoo, Michigan, Surveyor, hereby certify that we have each carefully compared this copy with the original PLAT OF SECOND ADDITION TO PLAT OF IDLEWILD, and that it is an exact copy thereof, and of the whole of such original map or plat.

Homer N. Elwell

Register of Deeds.

M. C. Taft

Surveyor.

CERTIFICATE OF COMPARISON WITH THE RECORD.

STATE OF MICHIGAN,
COUNTY OF KALAMAZOO, ss.

We, Homer N. Elwell, Register of Deeds in and for said County, and M. C. Taft, of Kalamazoo, Michigan, Surveyor, hereby certify that we have each carefully compared the annexed copy with the PLAT OF SECOND ADDITION TO PLAT OF IDLEWILD, now on record in the office of the said Register of Deeds, and that it is a true transcript therefrom and of the whole of such record.

Homer N. Elwell

Register of Deeds.

M. C. Taft

Surveyor.

FOR ALTERATION, CORRECTION, AND
VARIATIONS SEE VOUCHER No. 641-57

Plat of
14
13
12
IDLEWILD

13184